
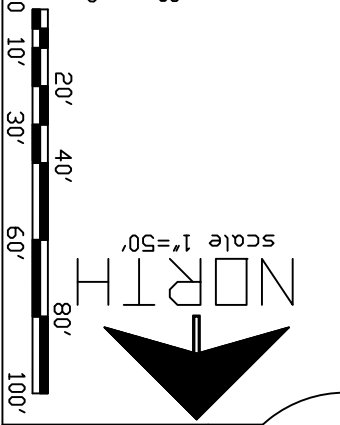


CONTRACTORS NOTE :
 UTILITY LOCATIONS ARE APPROXIMATE.
 CONTRACTOR TO VERIFY HORIZONTAL
 AND VERTICAL ALIGNMENT OF EXISTING
 UTILITIES AND TO NOTIFY THE ENGINEER
 IMMEDIATELY OF ANY DISCREPANCIES PRIOR
 TO CONSTRUCTION.

AVOID CUTTING
 UNDERGROUND UTILITY
 LINES IN YOUR AREA.
 TWO MORNING DAYS
 BEFORE YOU DIG-DRILL-BLAST
 IN NORTH DAKOTA, CALL THE FREE
 1-800-795-0555
 UNTIL THE UNDERGROUND LOCATION CENTER

AS BUILT --- MACEDONIA AVE SE
STA 8+00 to 13+50
WATER & SEWER IMPROVEMENTS
MACEDONIA HILLS—FIRST ADDITION
 PROJECT NUMBER 2013-21
 CITY OF MANDAN
 MORTON COUNTY, NORTH DAKOTA

REVISIONS:
 MACKOVSKI CONSULTING
 7745 MAGGIE BELLE CT.
 LAS VEGAS, NV 89123
 (702) 648-9690 Phone/Fax
 (702) 499-8961 Cell
 MB@MBinvestors.com

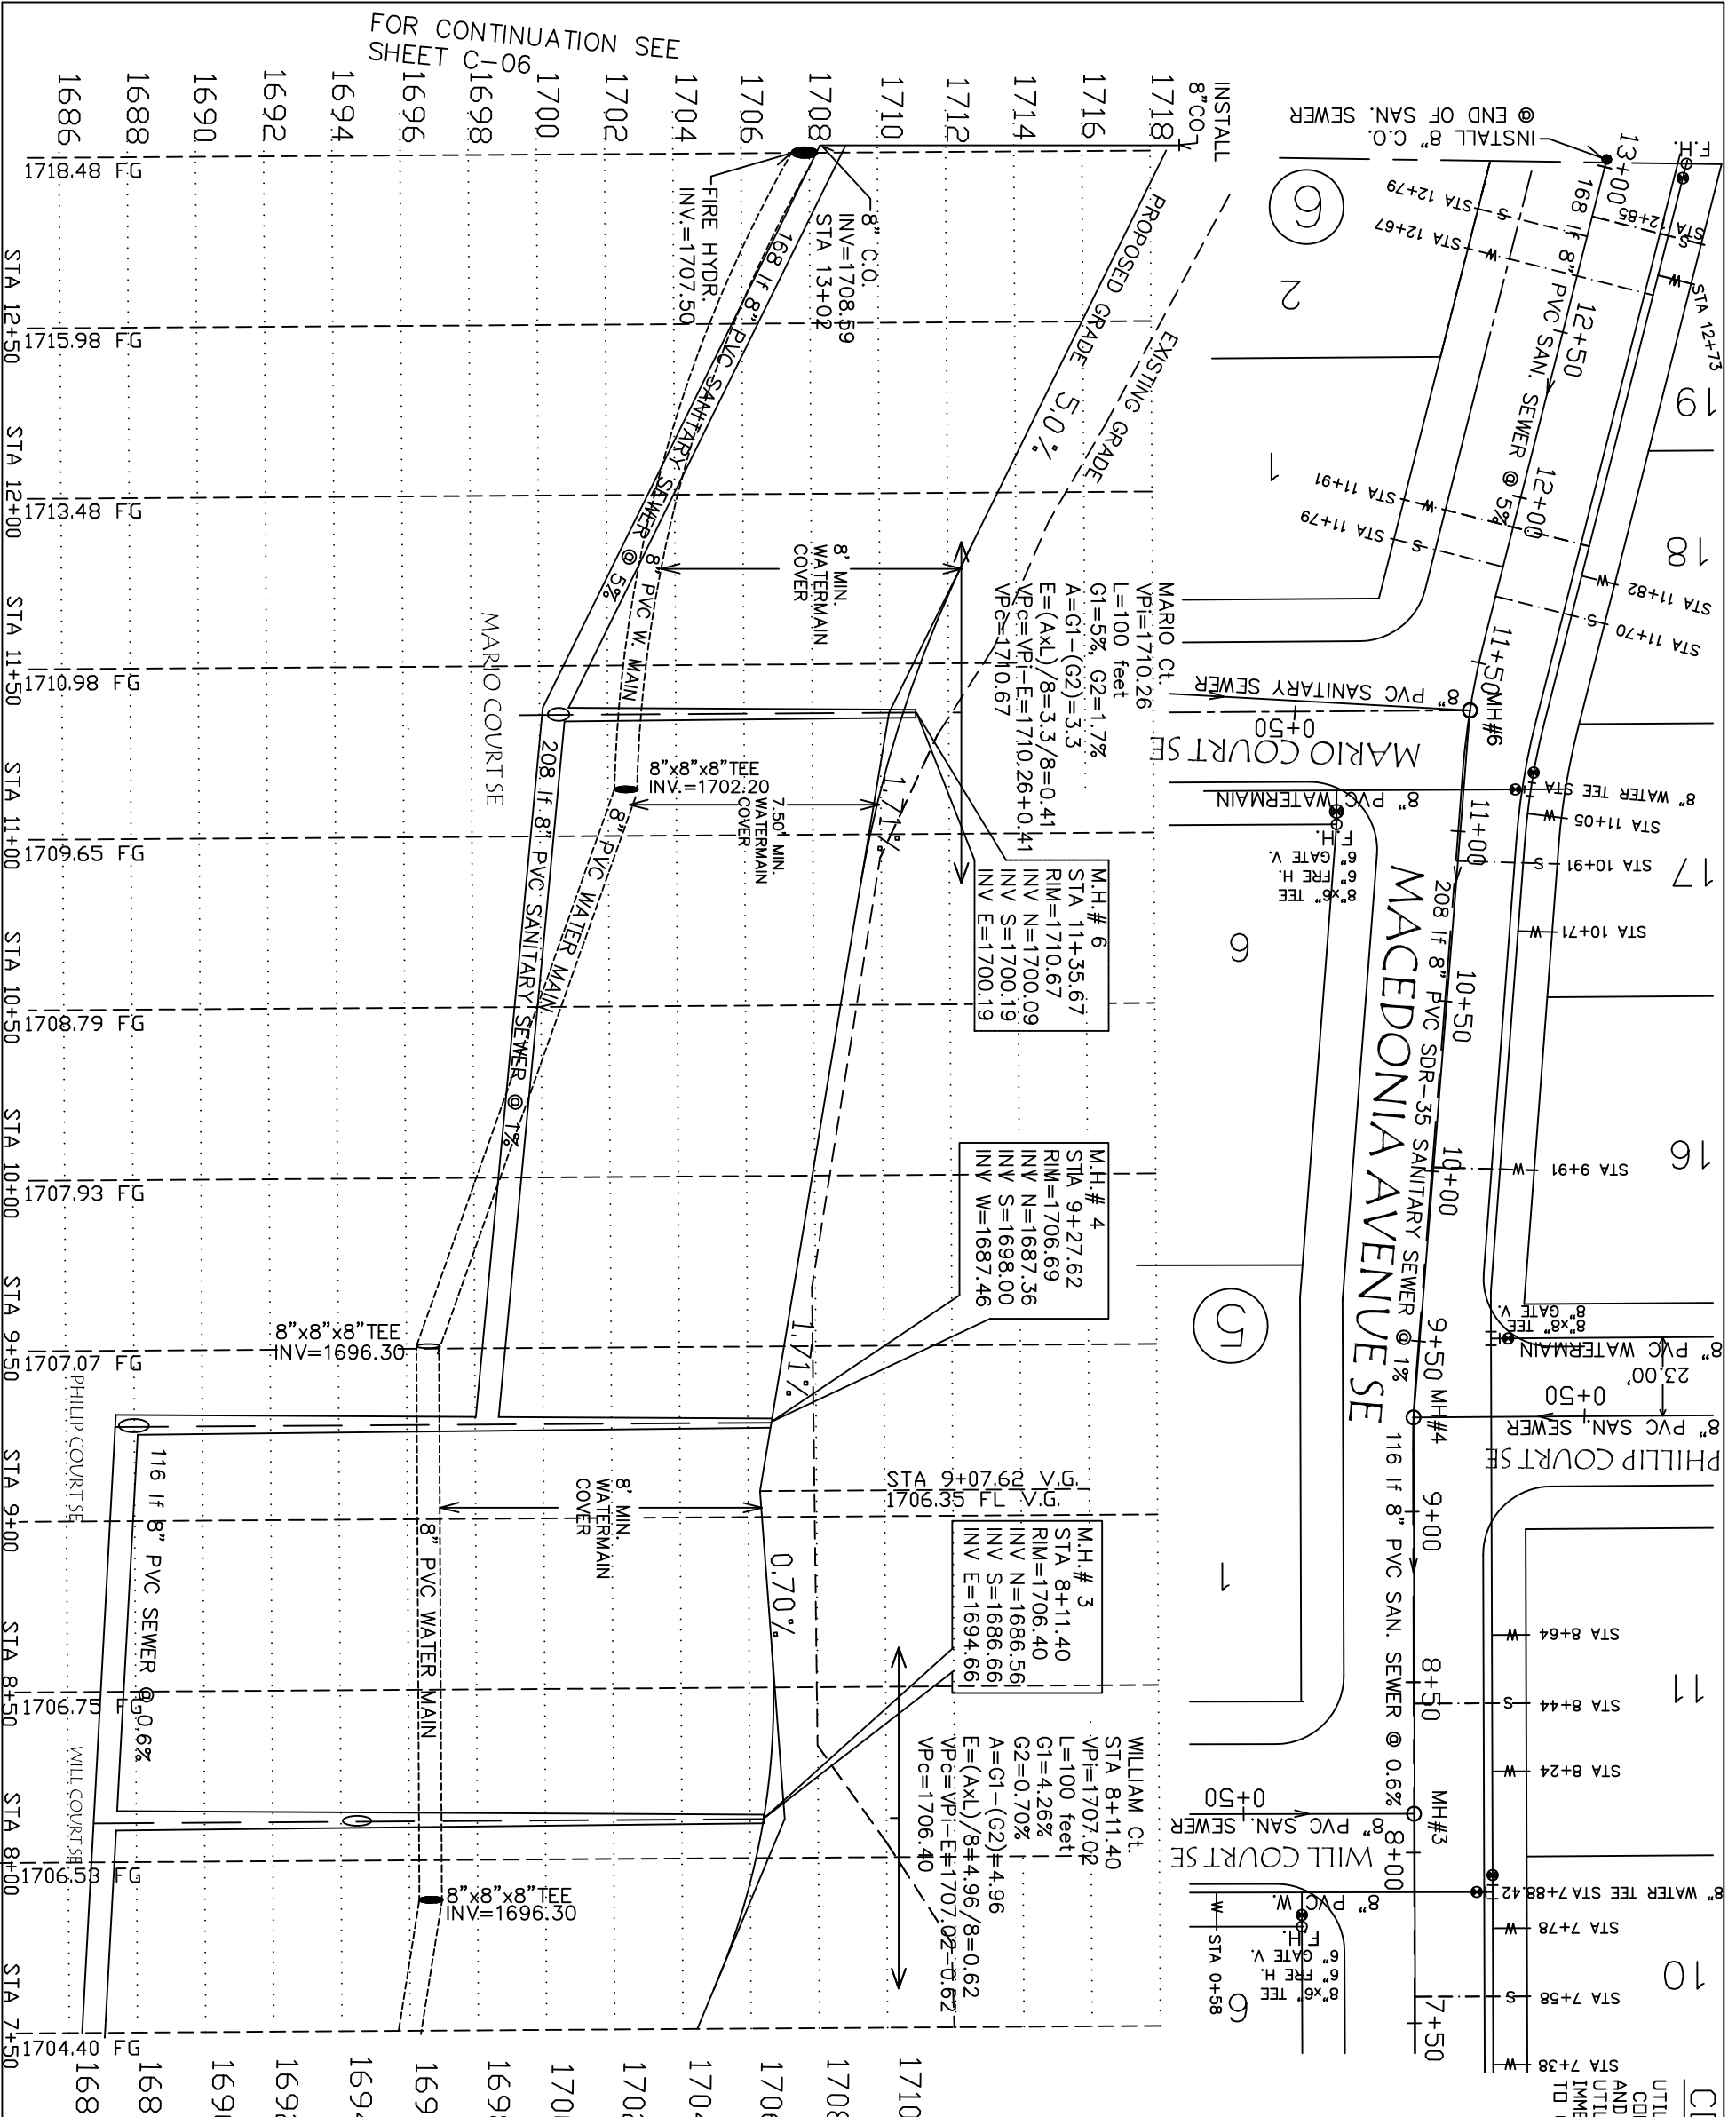

SHEET
C-05
5 of 14