


FHWA REGION	STATE	FED. AID PROJ. NO.	SHEET NO.
8	N.D.	RRS-1-006(005)066	86

① Revised 1-18-91

PULL BOX  
736+98-24' Lt. 1 EA.

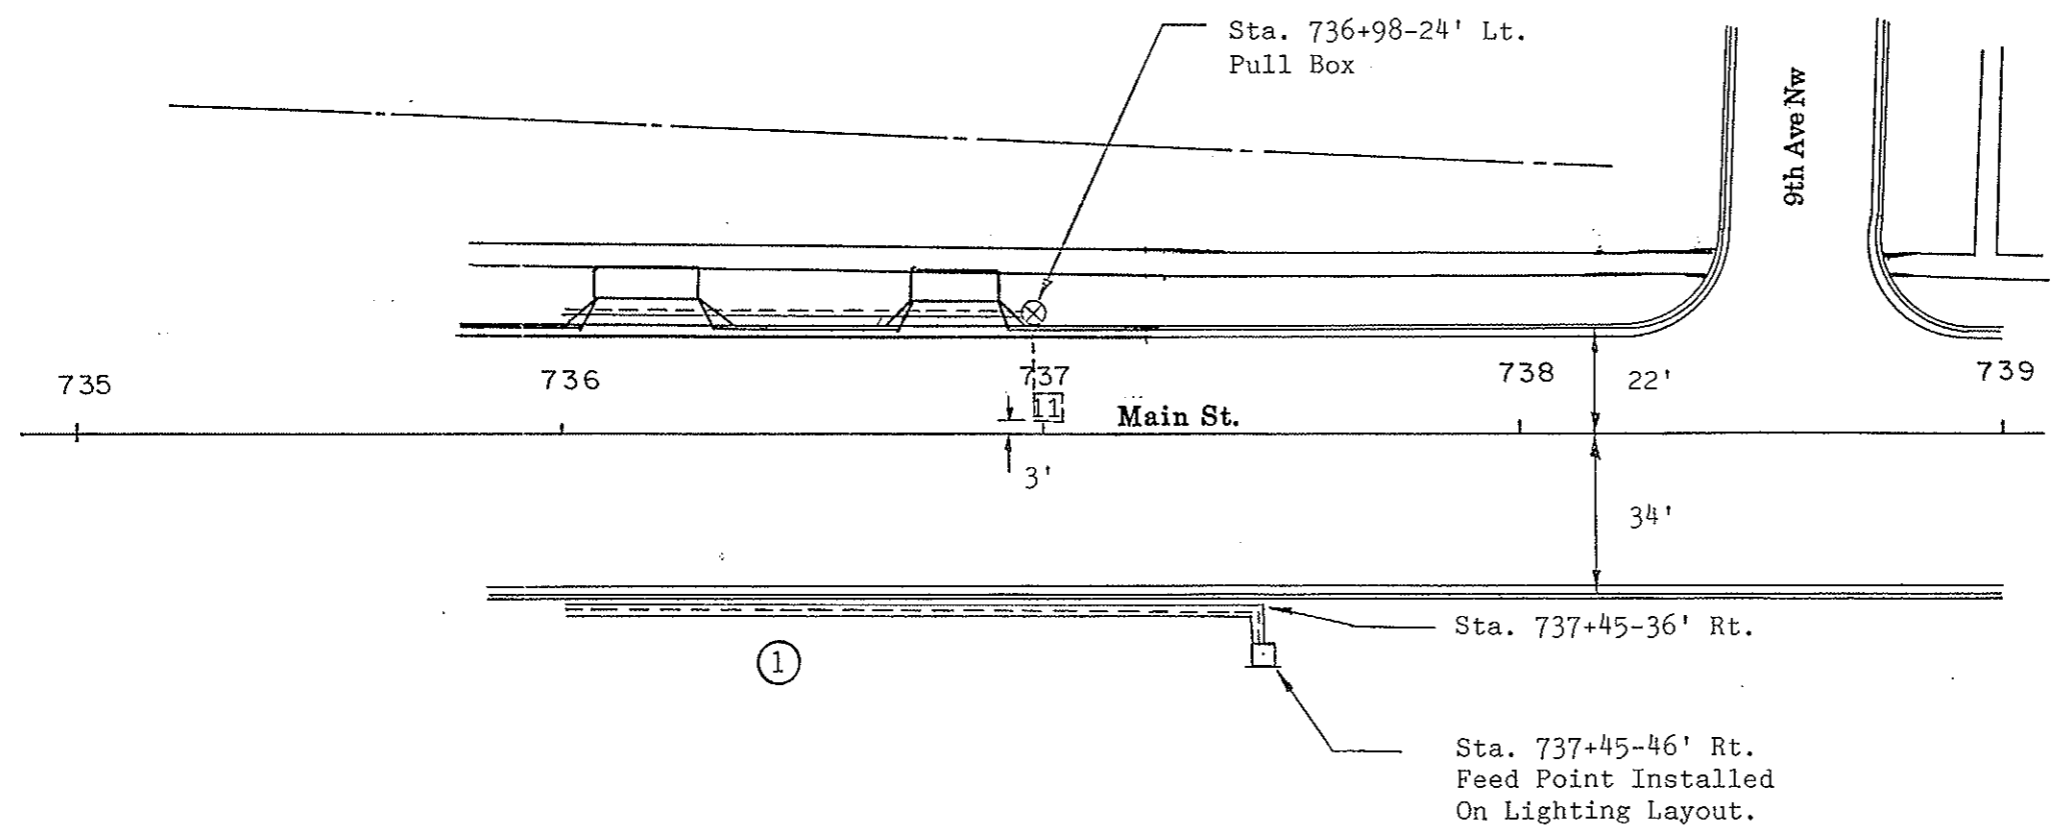

**TRAFFIC CONTROL SYSTEM**  
CONDUIT AND CONDUCTOR LAYOUT  
  
10th Ave. sw ( ND Hwy. 6 )  
Mandan N.D.