
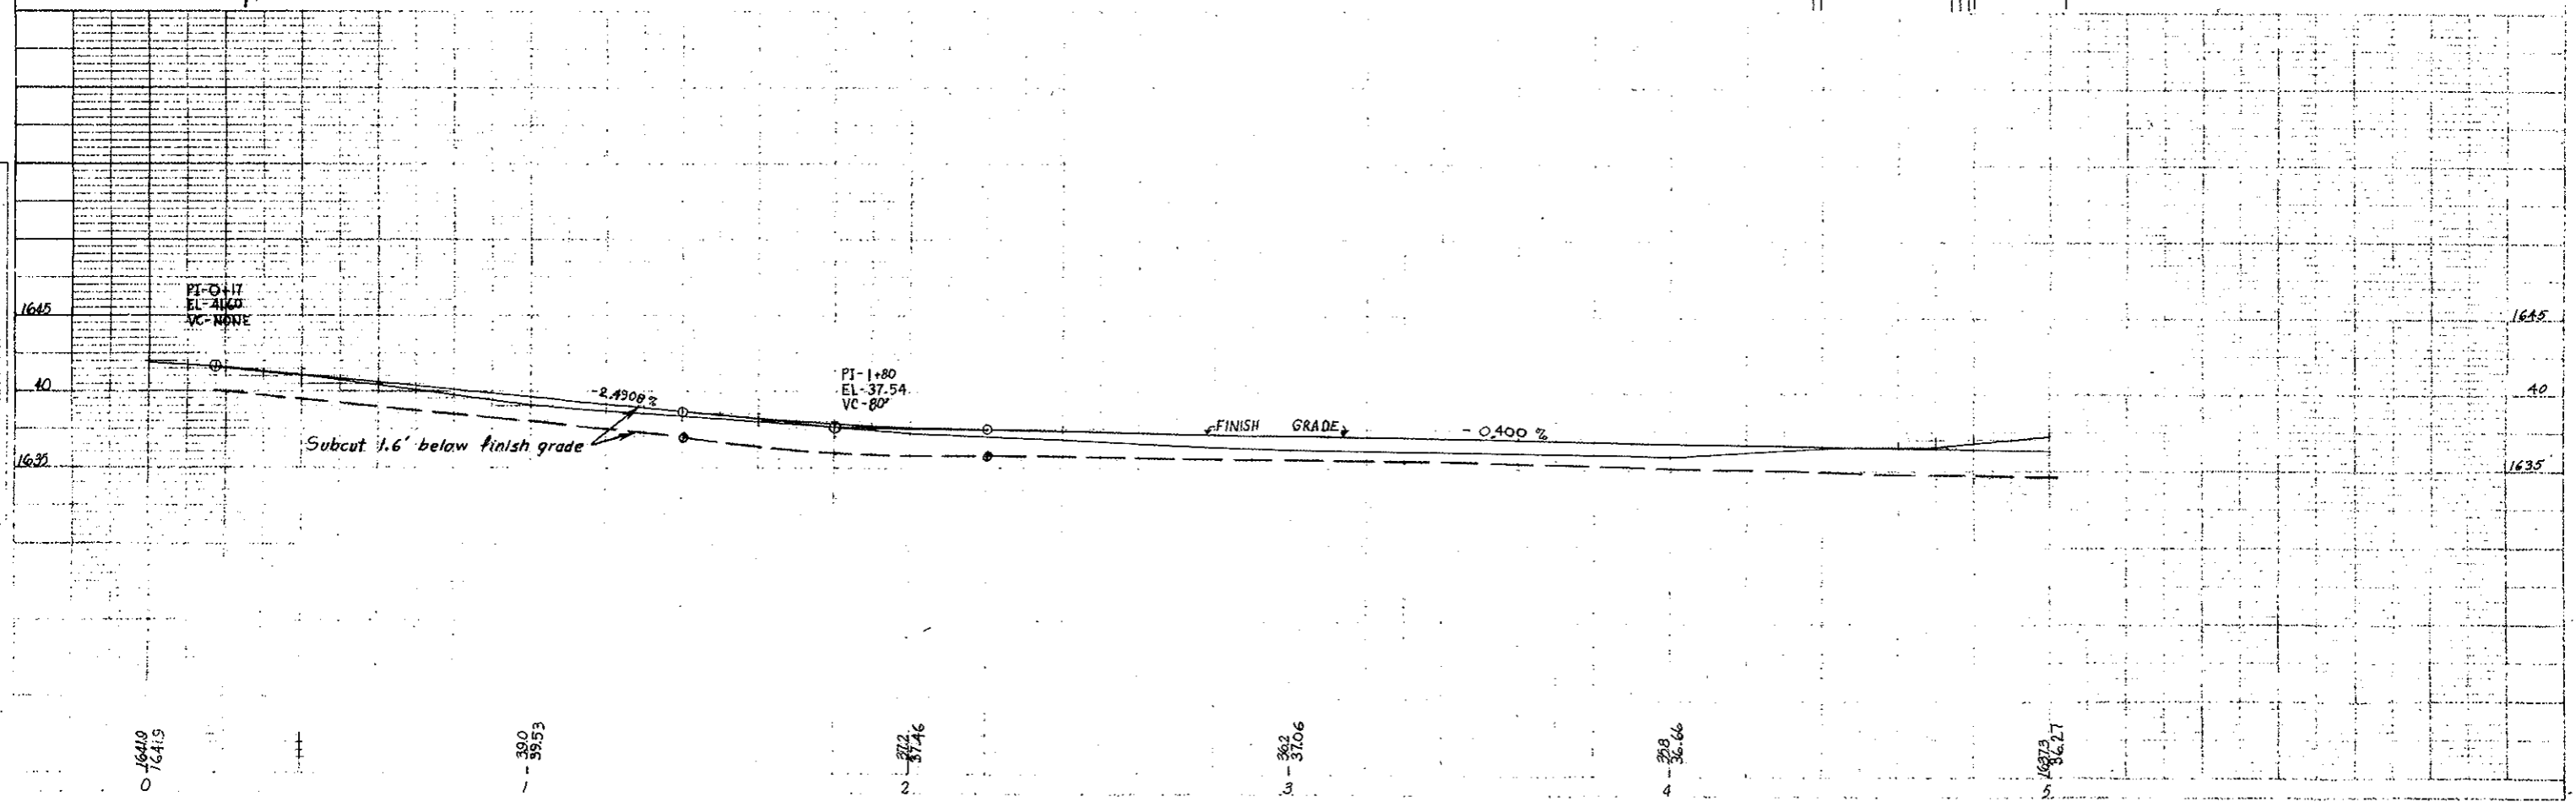


ENR REGION	STATE	FED. AID PROJ. NO.	SHEET NO.
8	N.D.	M-1-988(02)000	18

INSTALL CURB + GUTTER TYPE - I	
0+20 To 5+00 Lt.	491.4 L.F.
0+35.2 To 4+68 Rt.	443.6 L.F.
4+83.3 To 5+00 Rt.	36.1 L.F.
INSTALL CONG. SIDEWALK	
0+35.7 To 4+47.5 Rt.	211.4 S.Y.
4+83.8 To 5+00 Rt.	14.4 S.Y.
REMOVAL OF CONCRETE	
0+39.5 To 5+00 Rt.	1595.1
INSTALL 72" VALLEY GUTTER	
4+28 To 5+03 Rt.	47.2 S.Y.
ADJUST MANHOLE	
2+00.9 ~ 11.5 Rt.	1 Ea.
4+75.8 ~ 14.7 Rt.	1 Ea.

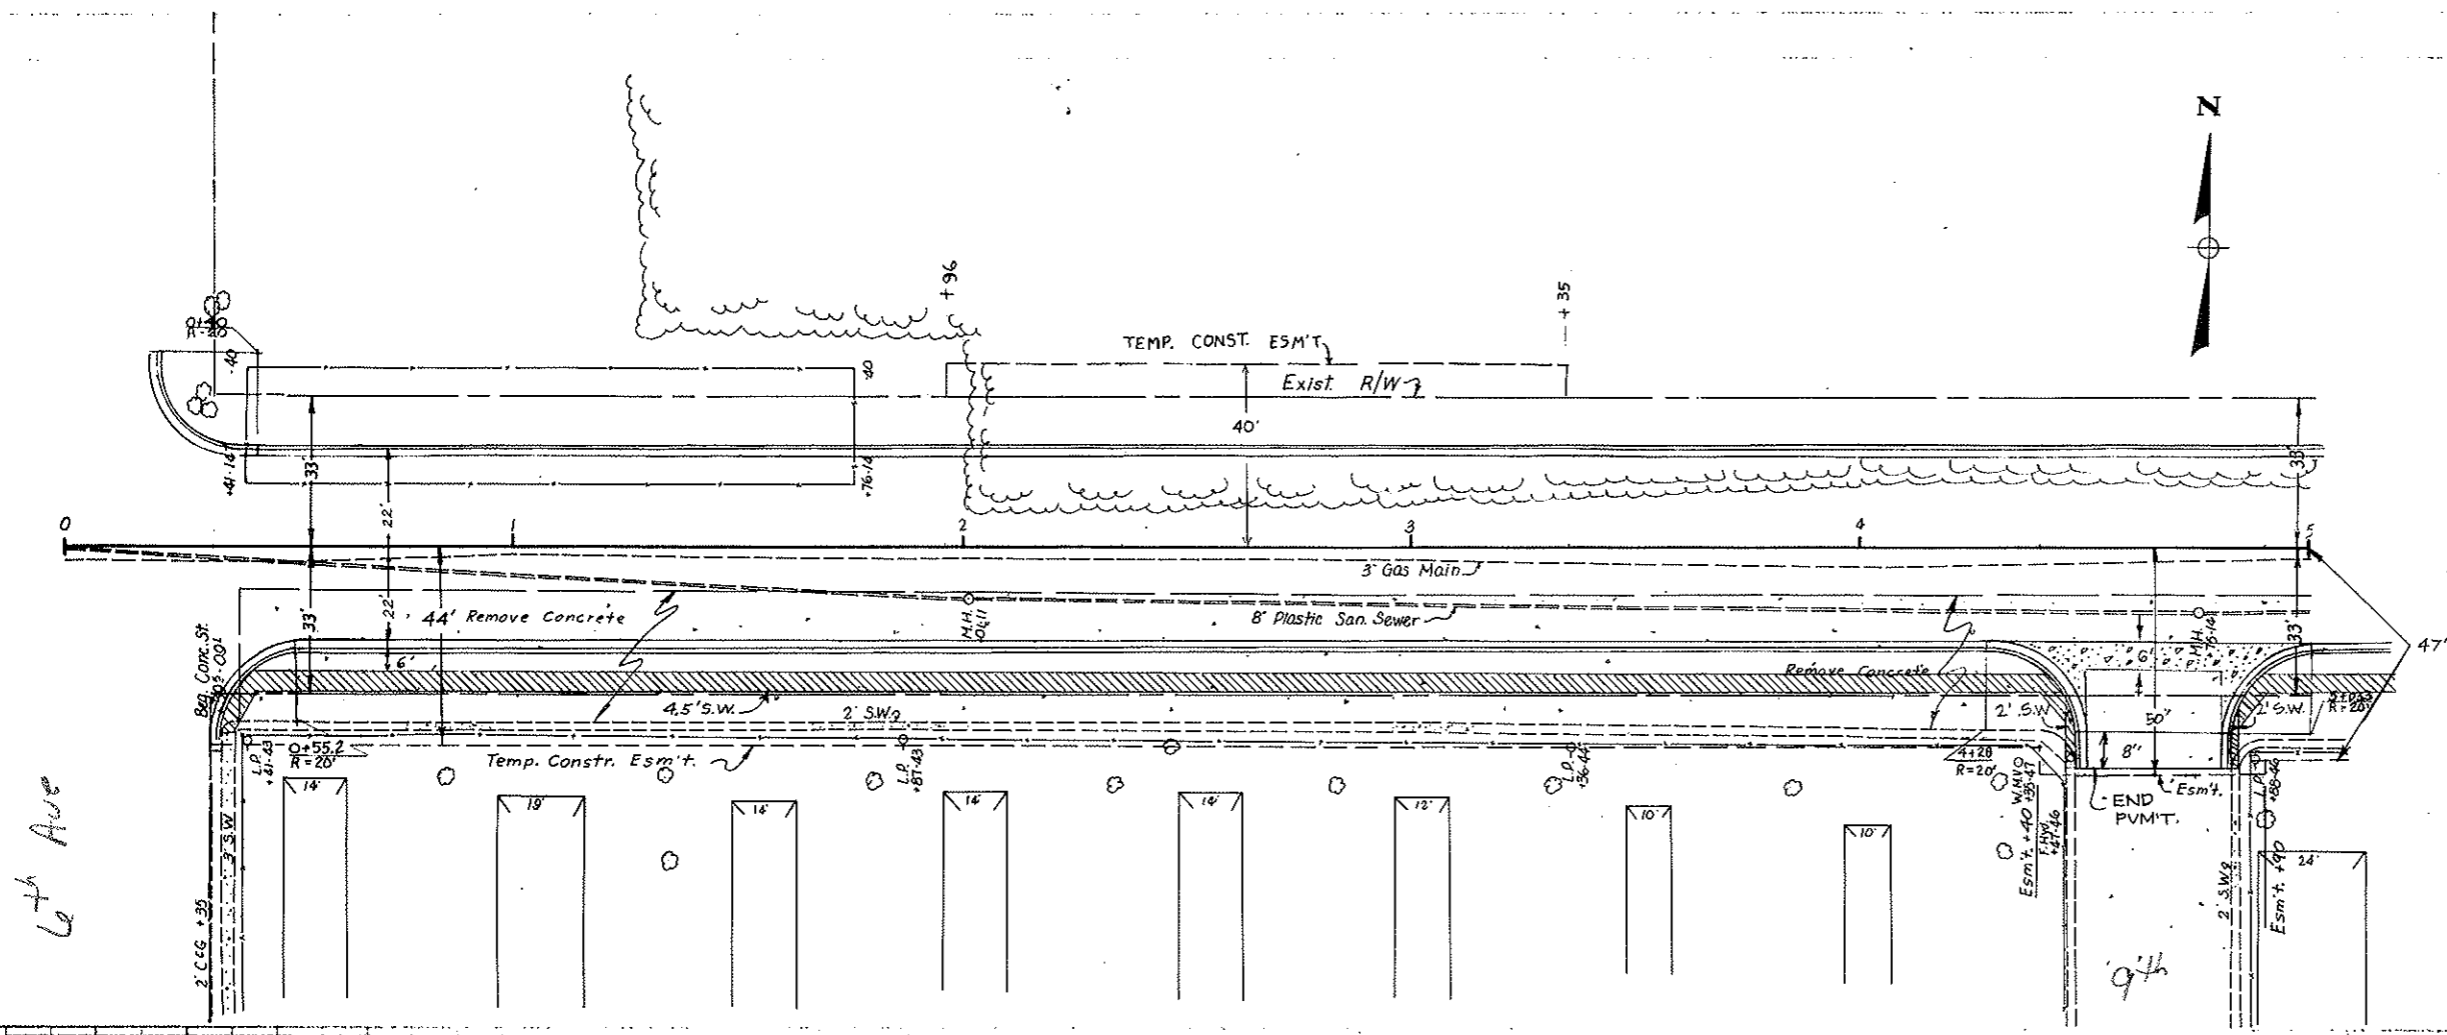

NOTE: BRINK, AT SIGNMENT ENTERED SET UP WAY LOCATED

CHECKED BY: [Signature] DATE: [Date]

16410
16415

390
393

372
3746

362
3706

368
3666

16373
16377