



47TH AVENUE NW PLAN & PROFILE AS-BUILT

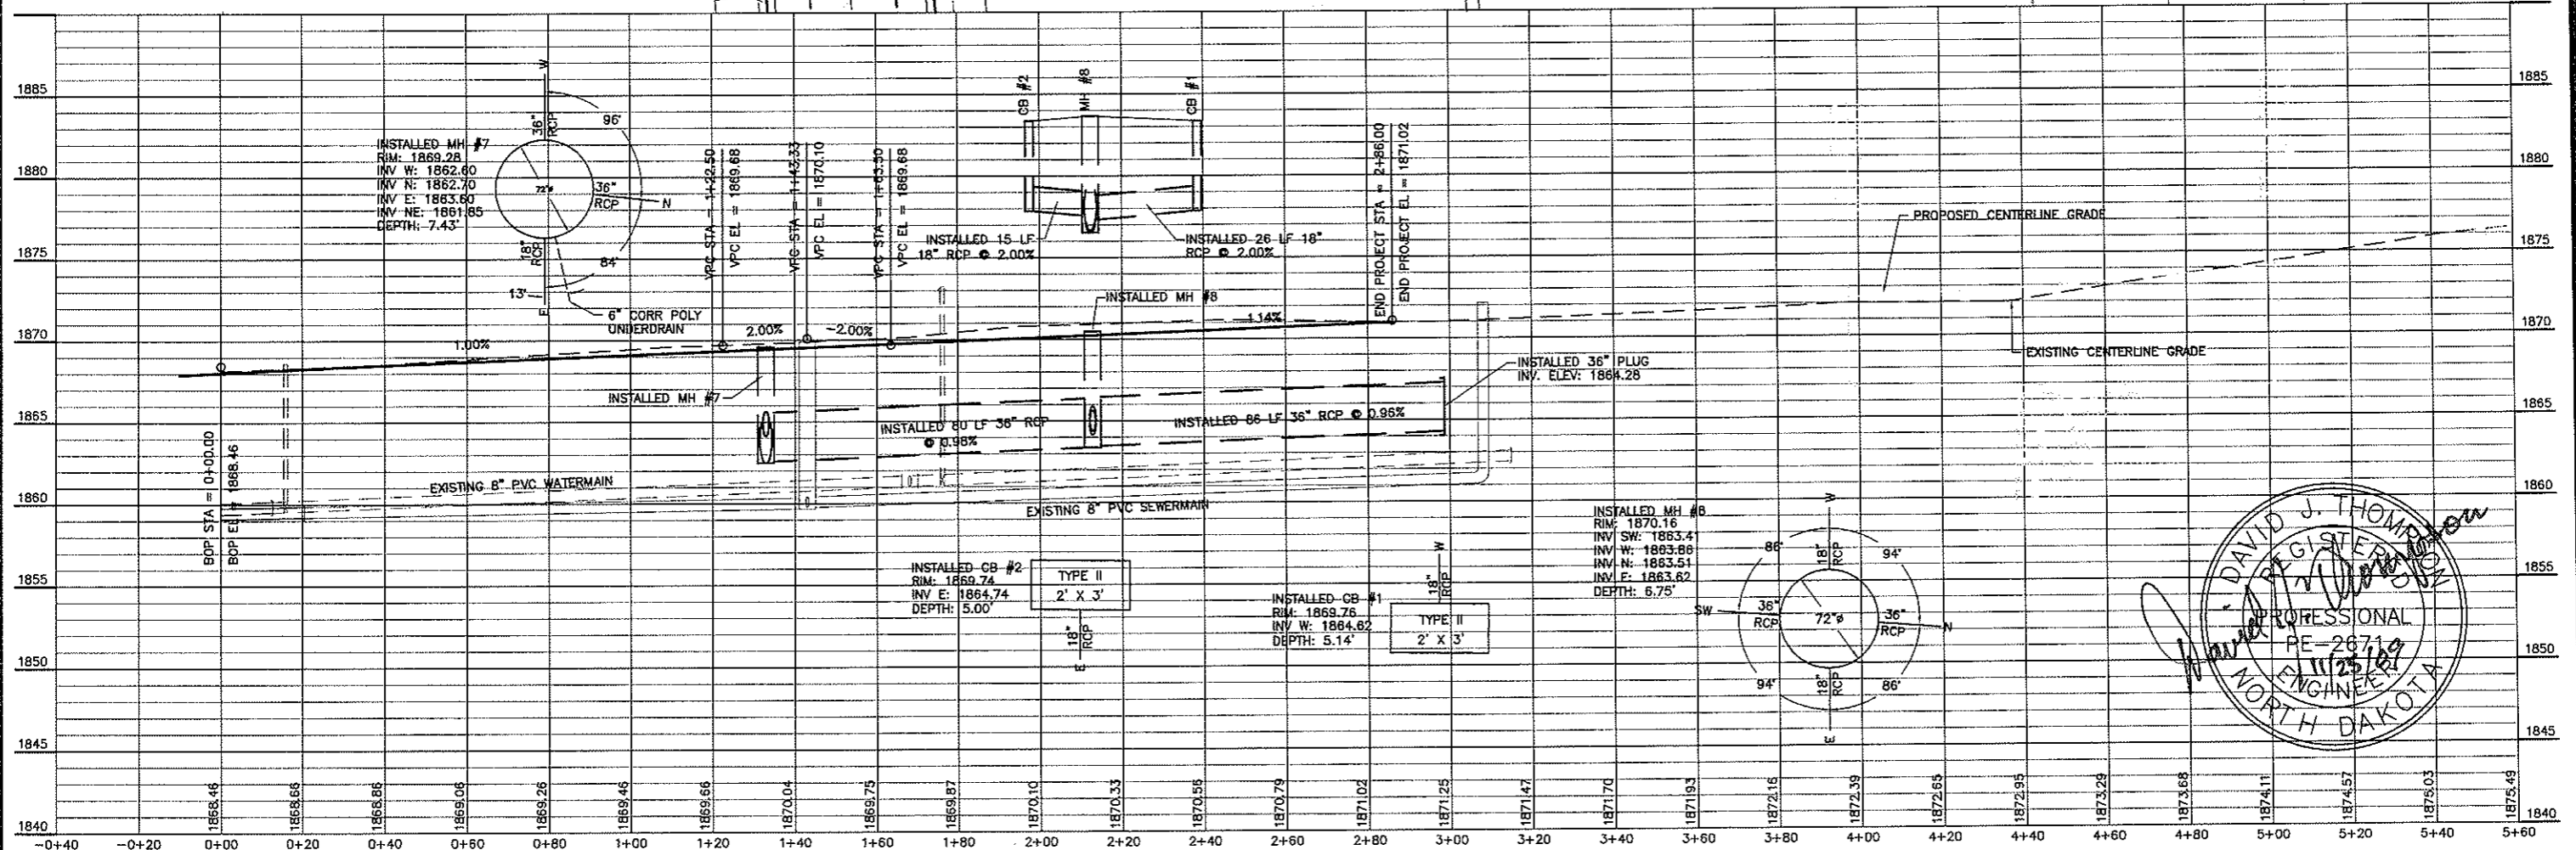

TOMAN ENGINEERING COMPANY
 CONSULTING CIVIL ENGINEERS
 501 1ST ST. N.W. • WANDAK, NORTH DAKOTA 58554 • (701) 685-6683


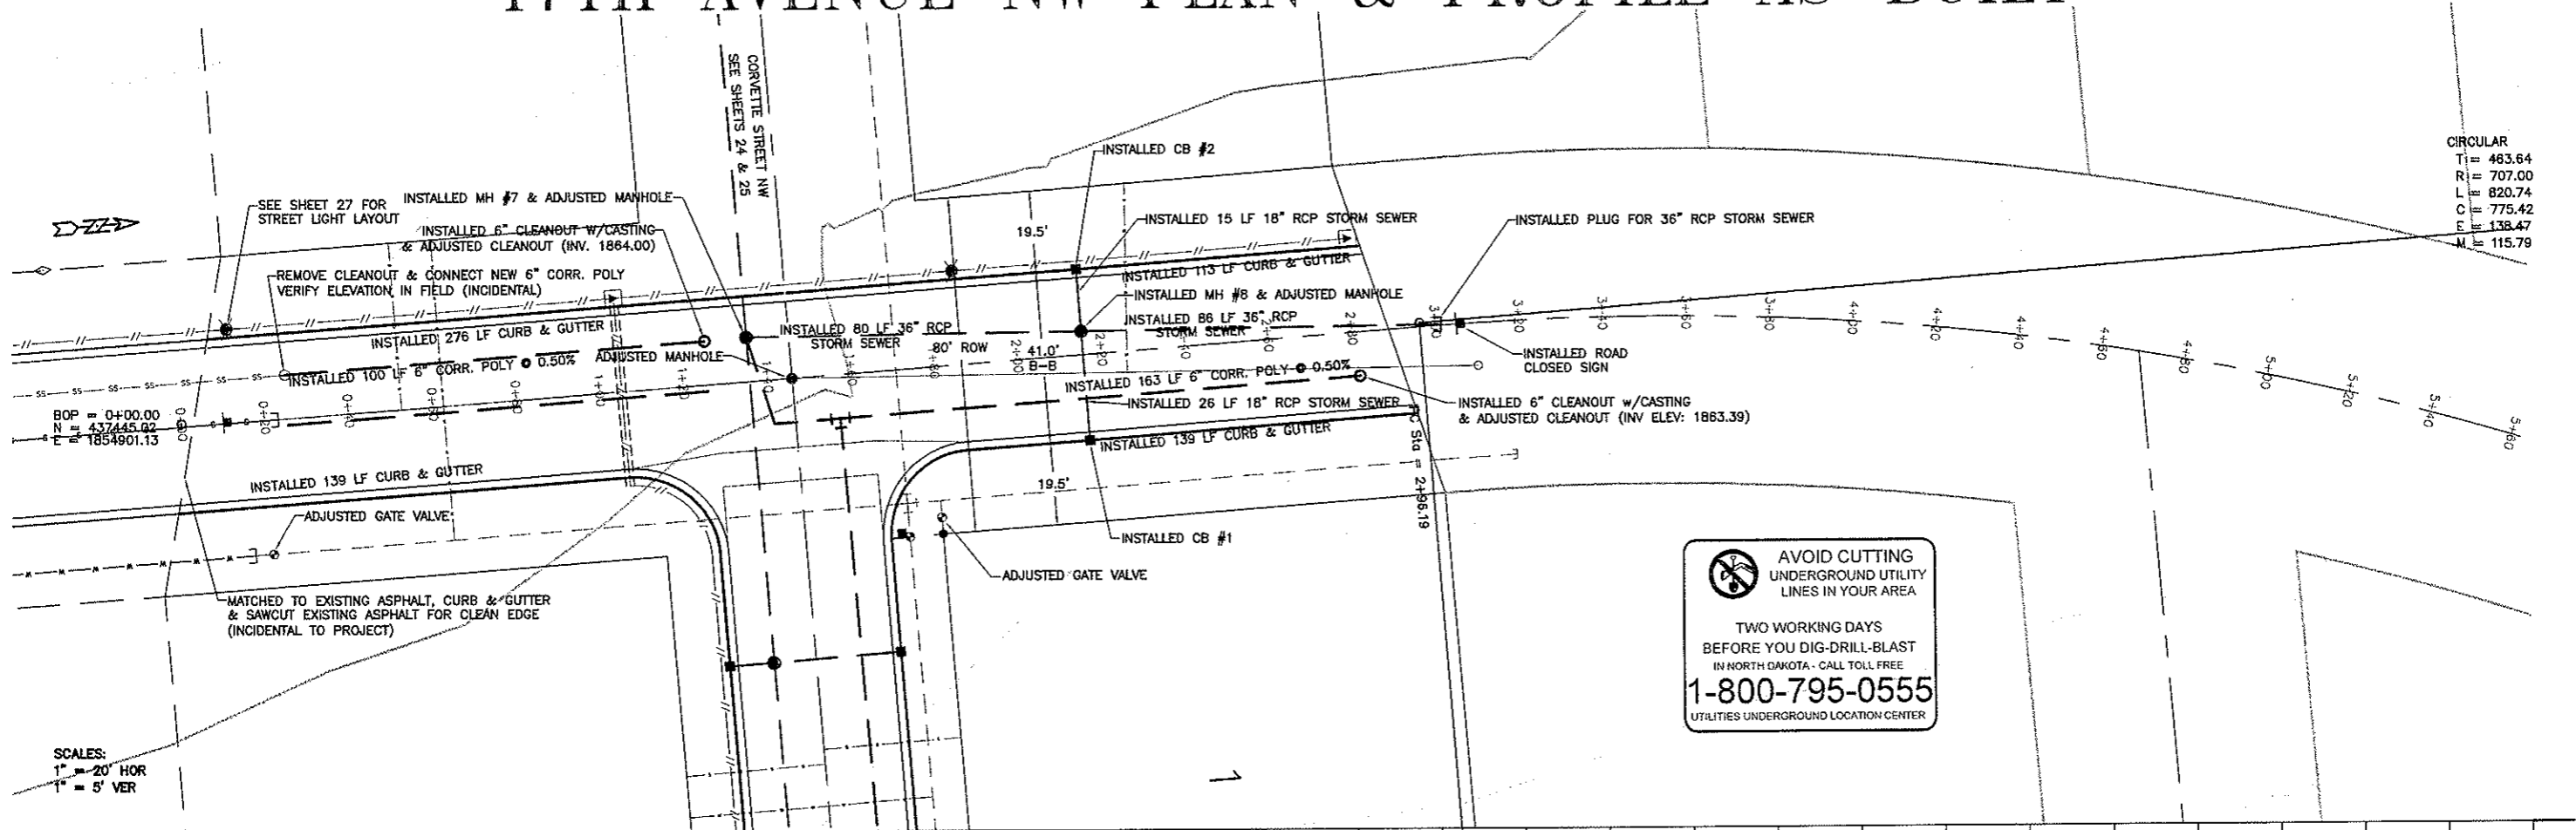


PROJECT: STREET IMP. DIST. NO. 153 - AREA "C"
 WEST HILLS ESTATES 2ND ADDITION
 47TH AVENUE NW PLAN & PROFILE AS-BUILT

NO.	REVISIONS	DATE	BY	DATE	BY


SHEET NUMBER
23
 OF 29 SHEETS

CORVETTE STREET NW PLAN & PROFILE AS-BUILT

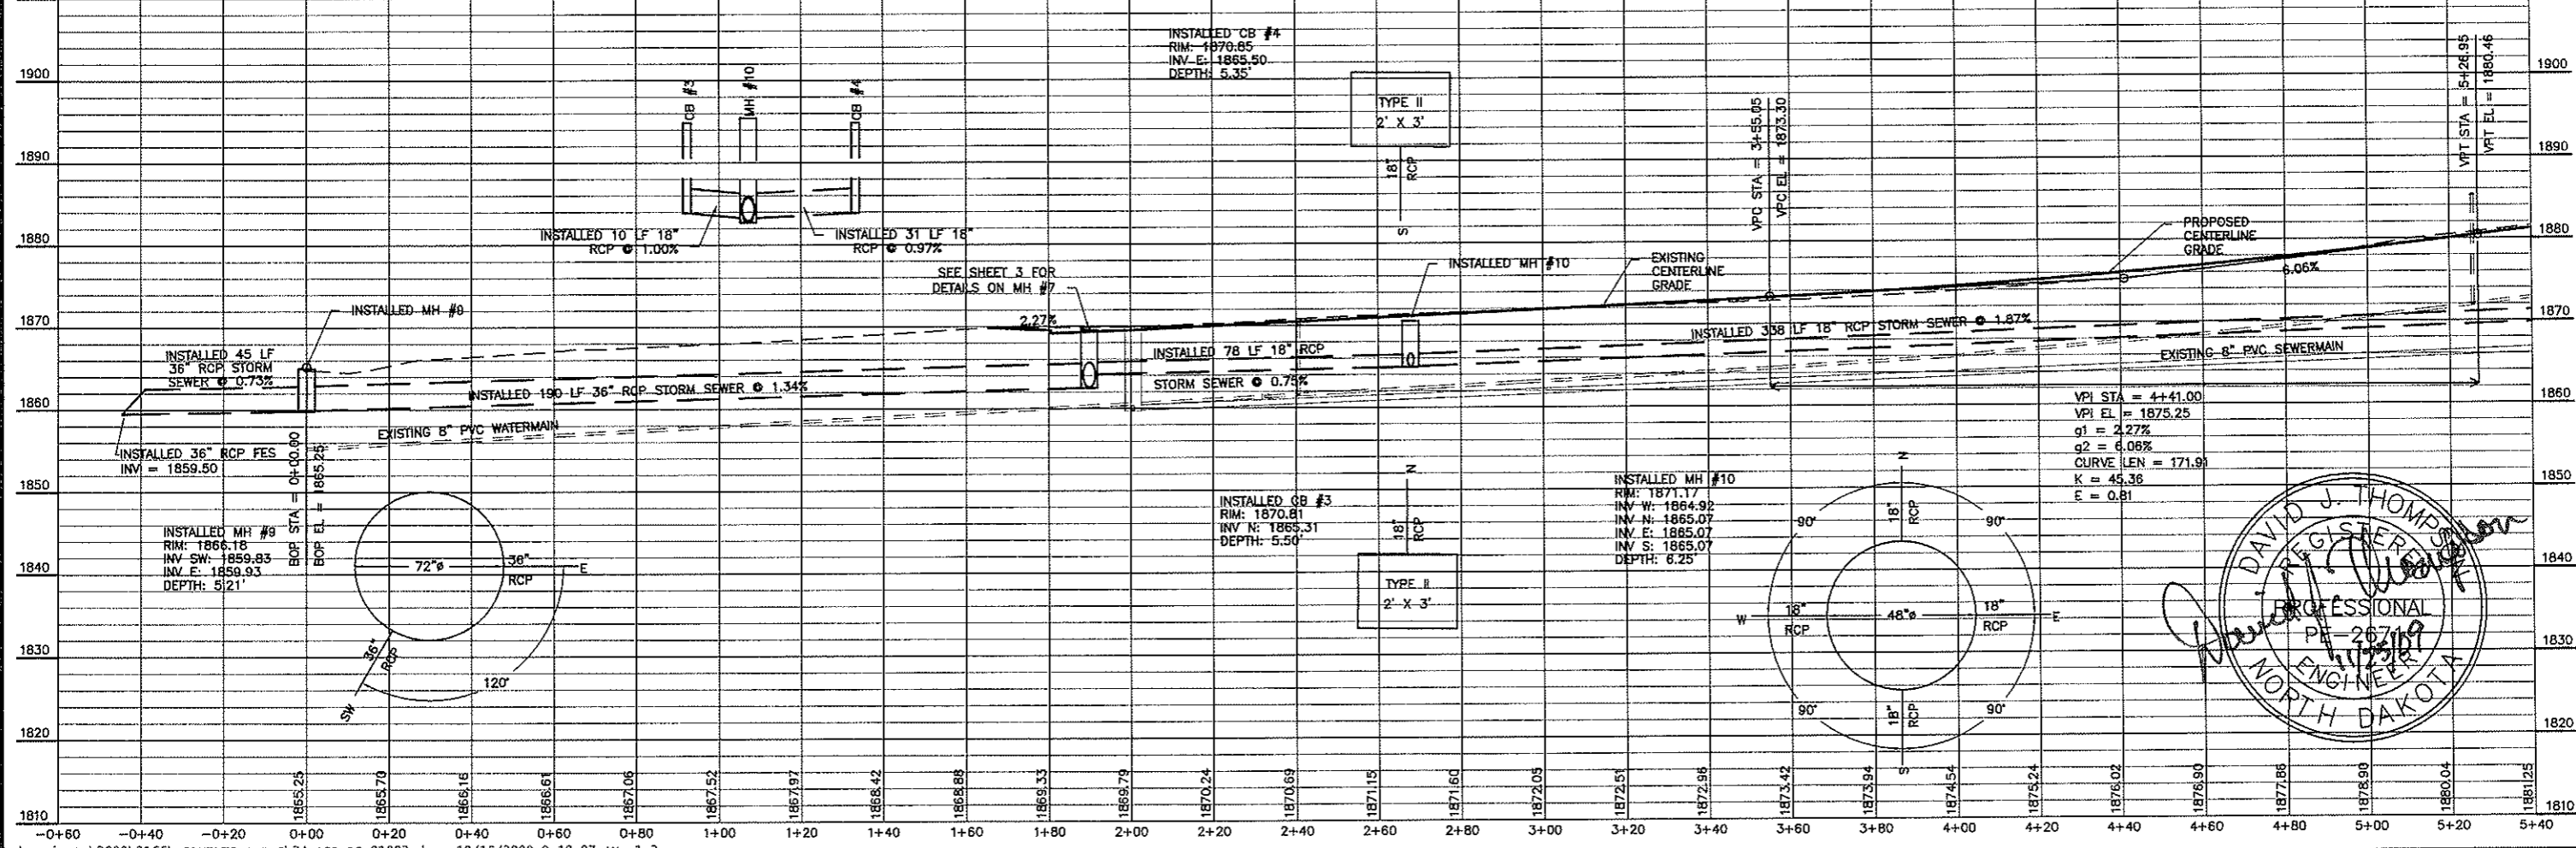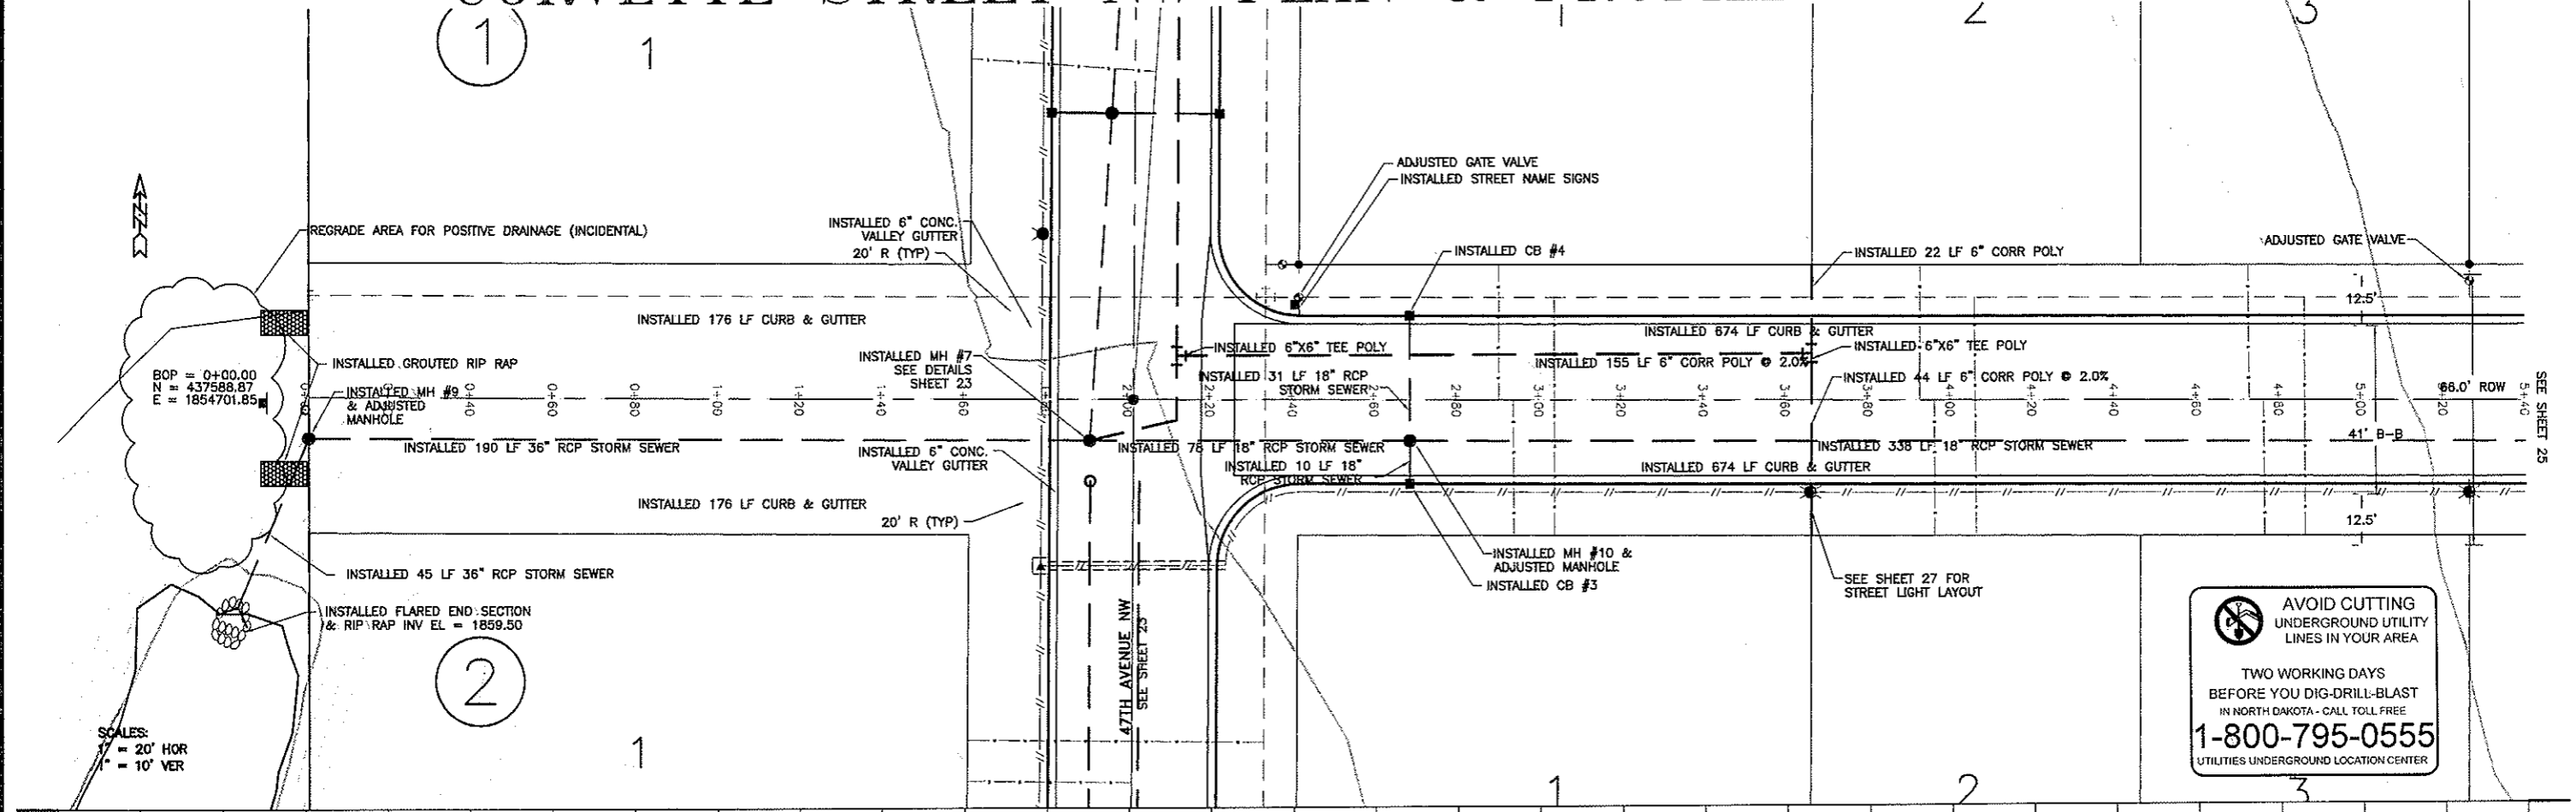

AVOID CUTTING UNDERGROUND UTILITY LINES IN YOUR AREA

TWO WORKING DAYS BEFORE YOU DIG-DRILL-BLAST IN NORTH DAKOTA - CALL TOLL FREE **1-800-795-0555** UTILITIES UNDERGROUND LOCATION CENTER

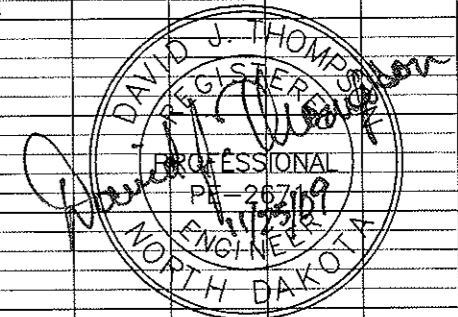


TOMAY ENGINEERING COMPANY
CONSULTING CIVIL ENGINEERS
501 1ST ST. N.W. • MADAWASKA, NORTH DAKOTA 58554 • (701) 663-4463

PROJECT: STREET IMP. DIST. NO. 153 - AREA "C"
STREET IMP. DIST. NO. 153 - AREA "C"
WEST HILLS ESTATES 2ND ADDITION AS-BUILT
CORVETTE STREET NW PLAN & PROFILE

NO.	REVISIONS	DATE	BY	DATE	BY
1		5/2008			



TITLE: STREET IMP. DIST. NO. 153 - AREA "C"
BY DATE 5/2008
NO. 2165
SHEET NUMBER **24**
OF 29 SHEETS

CORVETTE STREET NW PLAN & PROFILE CONT. AS-BUILT

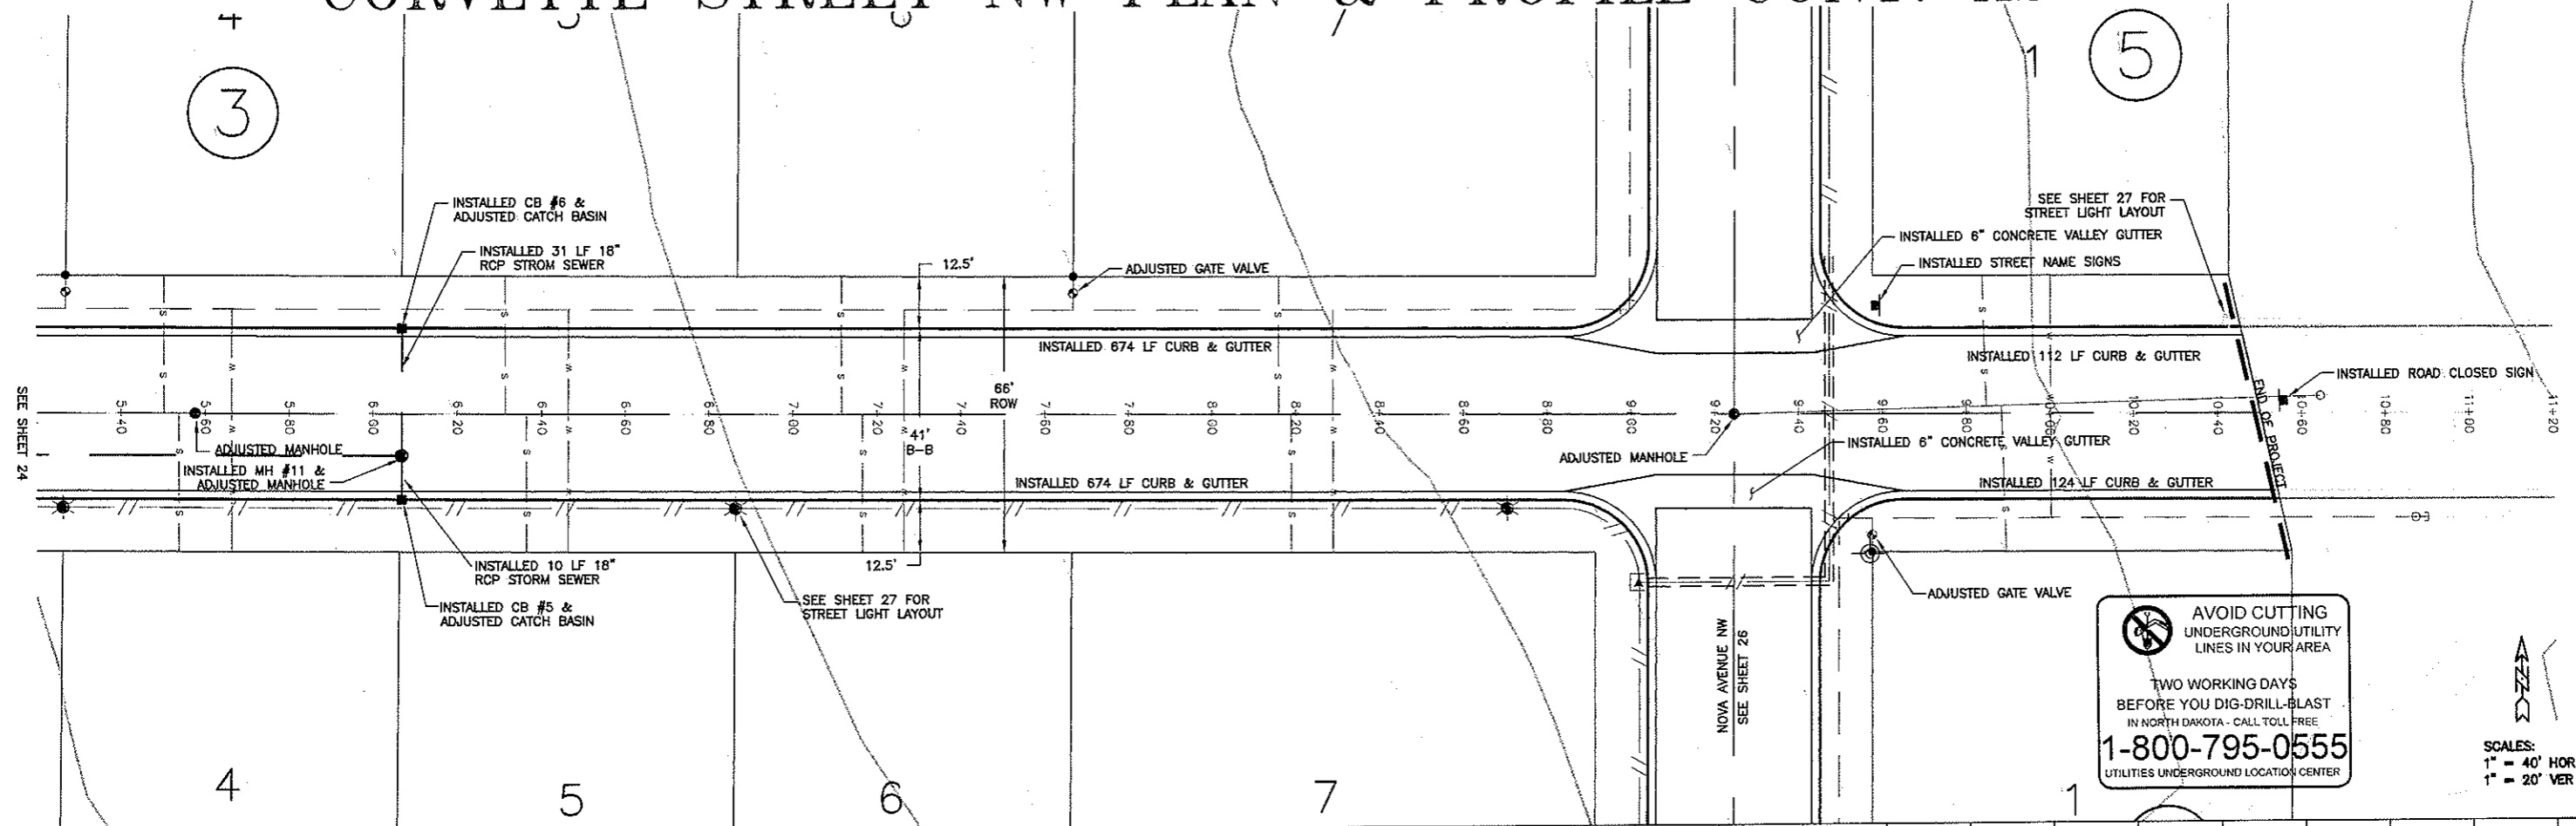

AVOID CUTTING UNDERGROUND UTILITY LINES IN YOUR AREA
 TWO WORKING DAYS BEFORE YOU DIG-DRILL-BLAST IN NORTH DAKOTA - CALL TOLL FREE
1-800-795-0555
 UTILITIES UNDERGROUND LOCATION CENTER

SCALES:
 1" = 40' HOR
 1" = 20' VER

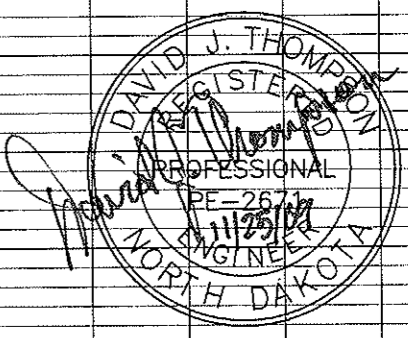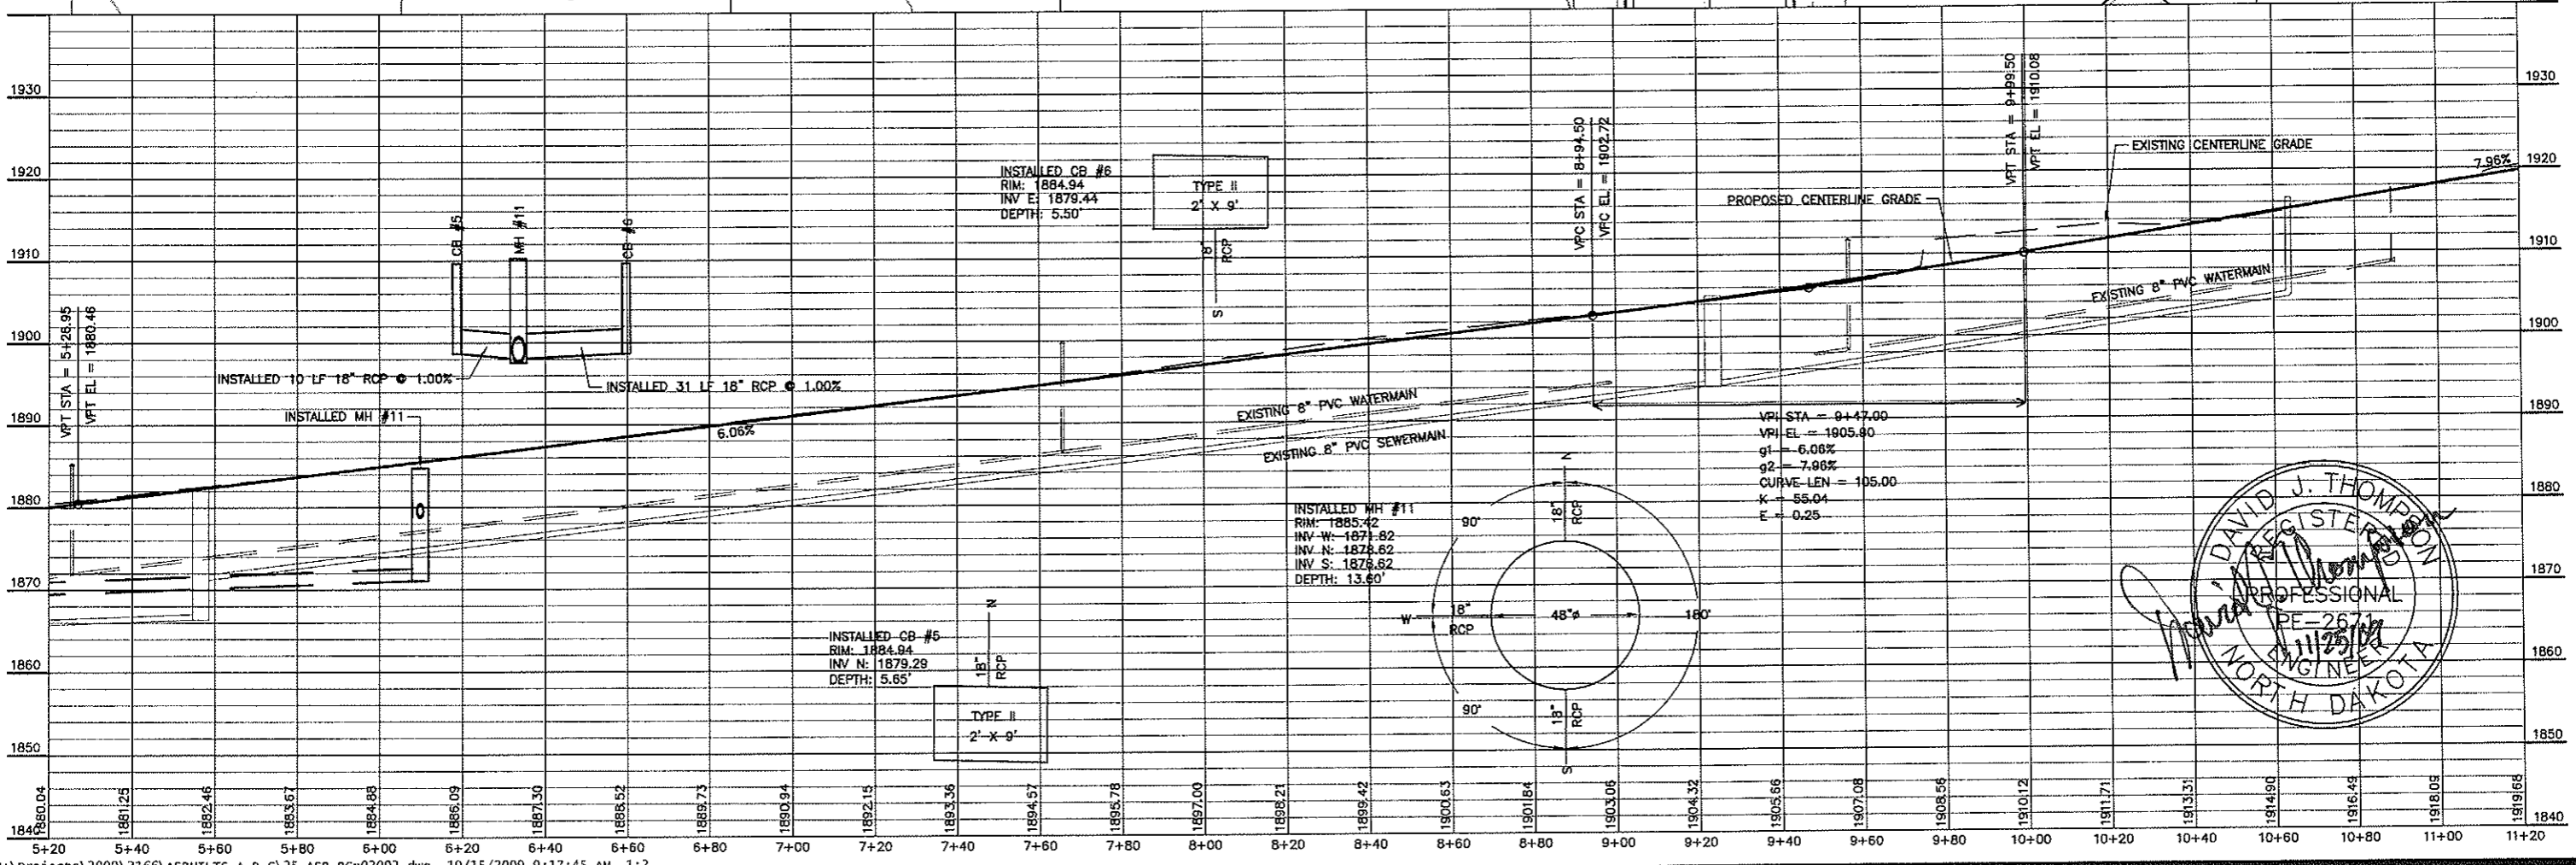

TOMAN ENGINEERING COMPANY
 CONSULTING CIVIL ENGINEERS
 501 1ST ST. N.W. • WAGNAN, NORTH DAKOTA 58554 • (701) 465-9483



PROJECT:
 STREET IMP. DIST. NO. 153 - AREA "C"
 STREET HILLS ESTATES 2ND ADDITION AS-BUILT
 CORVETTE STREET NW PLAN & PROFILE CONT.

NO.	DATE	BY	REVISIONS
1	5/2008		
2			
3			
4			
5			

SHEET NUMBER
25
 OF 29 SHEETS