

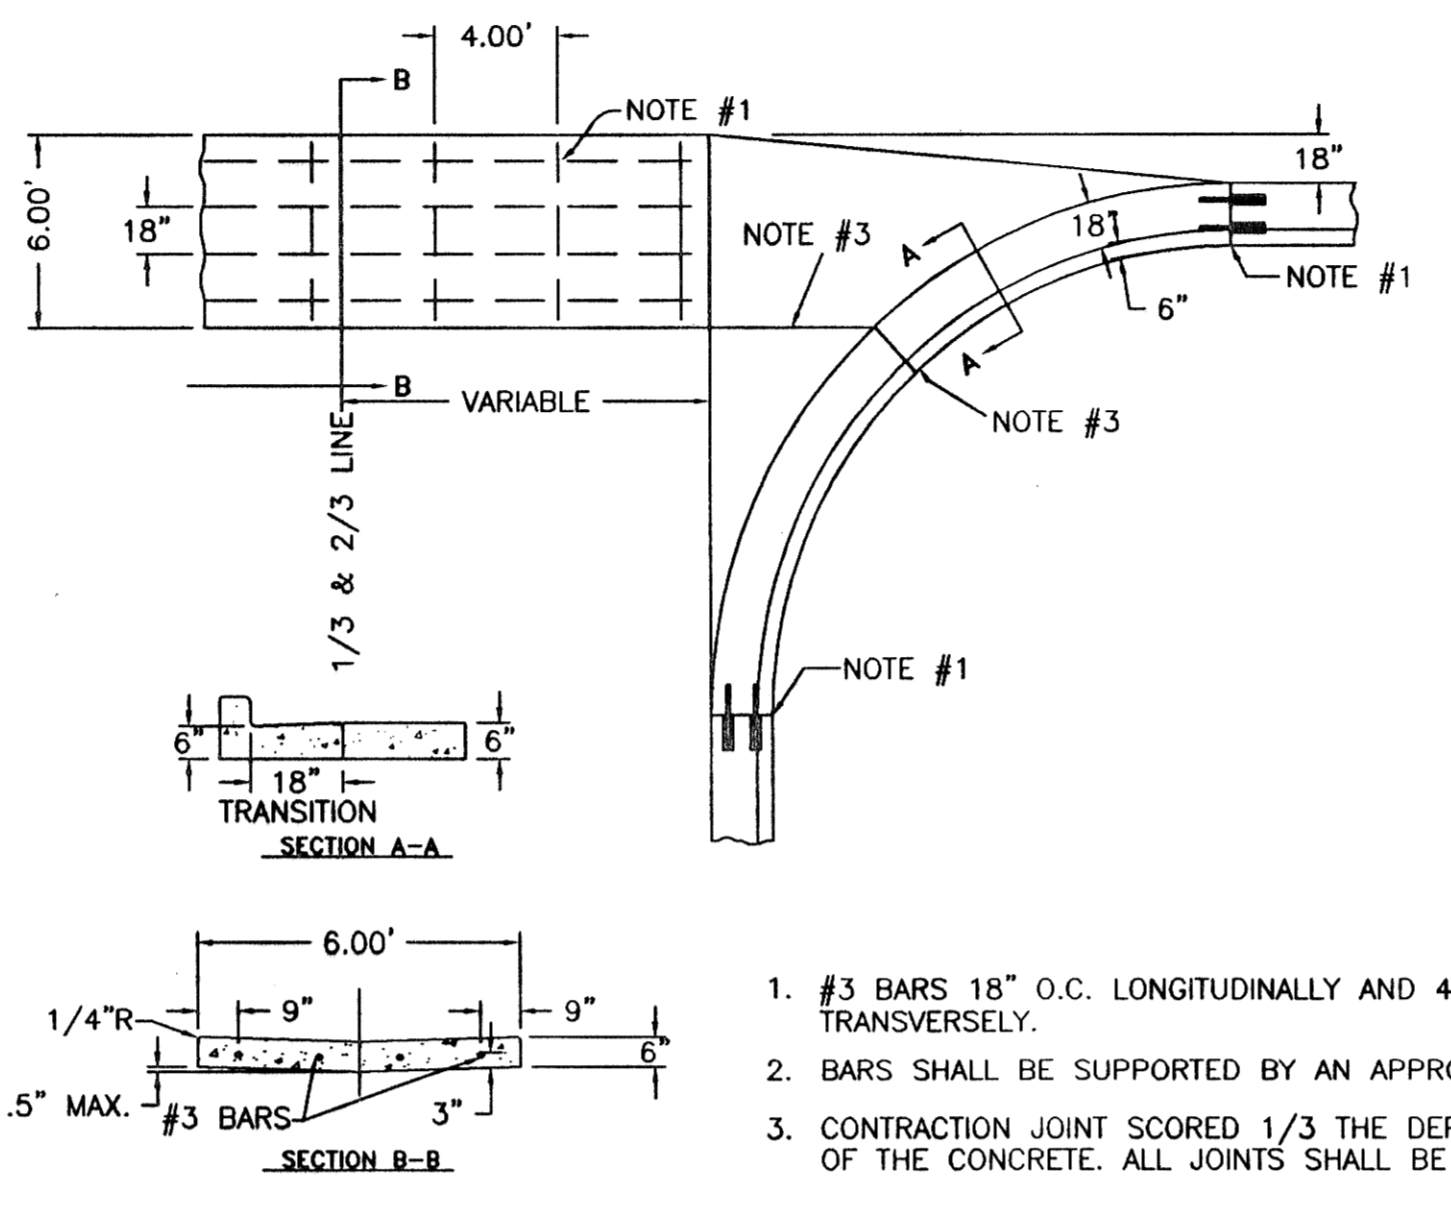


**TYPE III BARRICADE**  
NO SCALE

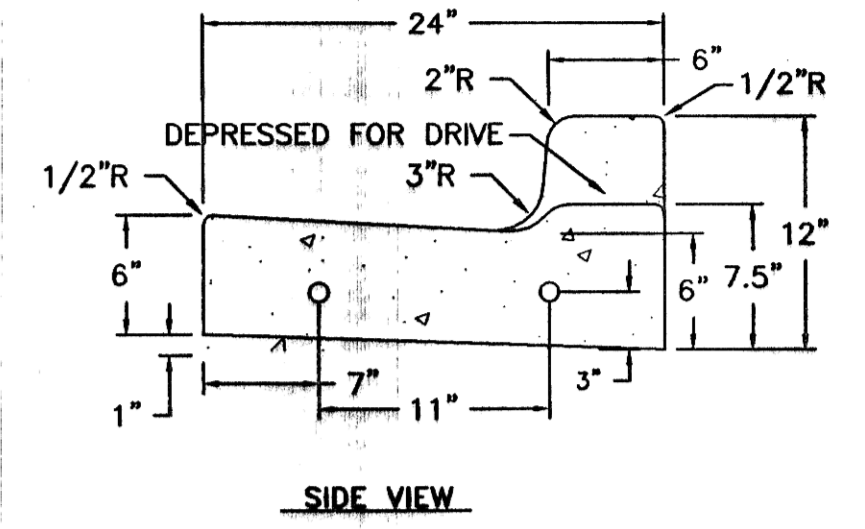


**6" REINFORCED CONCRETE VALLEY GUTTER DETAIL**  
NO SCALE

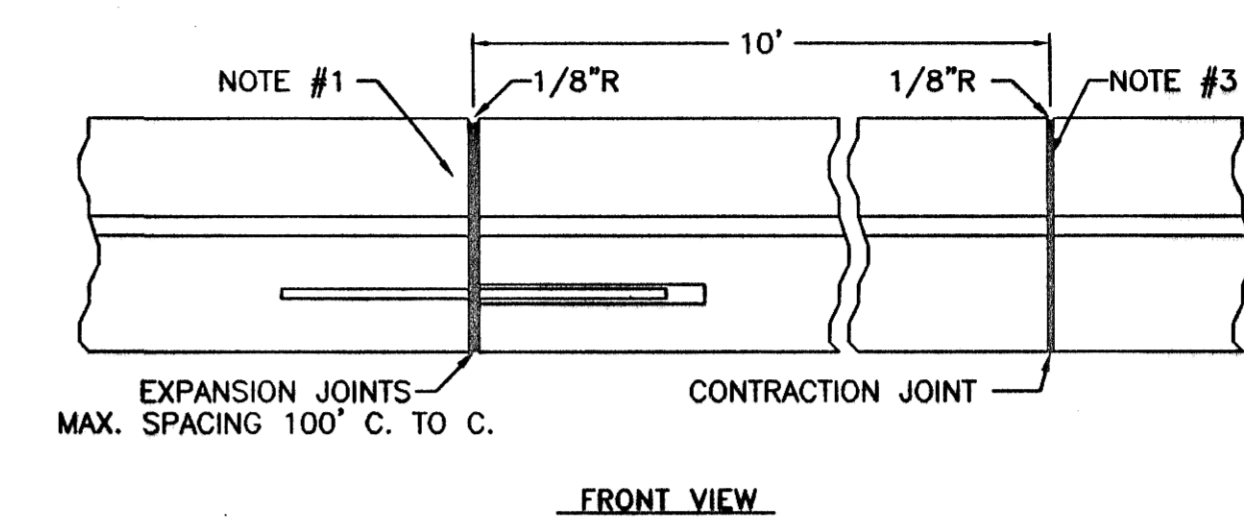


**STANDARD CURB & GUTTER DETAIL**  
NO SCALE


- 3/4" EXPANSION JOINT WITH 3/4"x24" SMOOTH DOWELS & 16" PAPER TUBES. DOWELS SHALL BE GREASED THE FULL LENGTH. ALL PAPER TUBES SHALL BE PLUGGED OR CRIMPED ON ONE END. ALL JOINTS SHALL BE SEALED.
- DOWELS SHALL BE SUPPORTED BY AN APPROVED SUPPORT
- CONTRACTION JOINT SCORED 1/3 THE DEPTH OF THE CONCRETE. ALL JOINTS SHALL BE SEALED

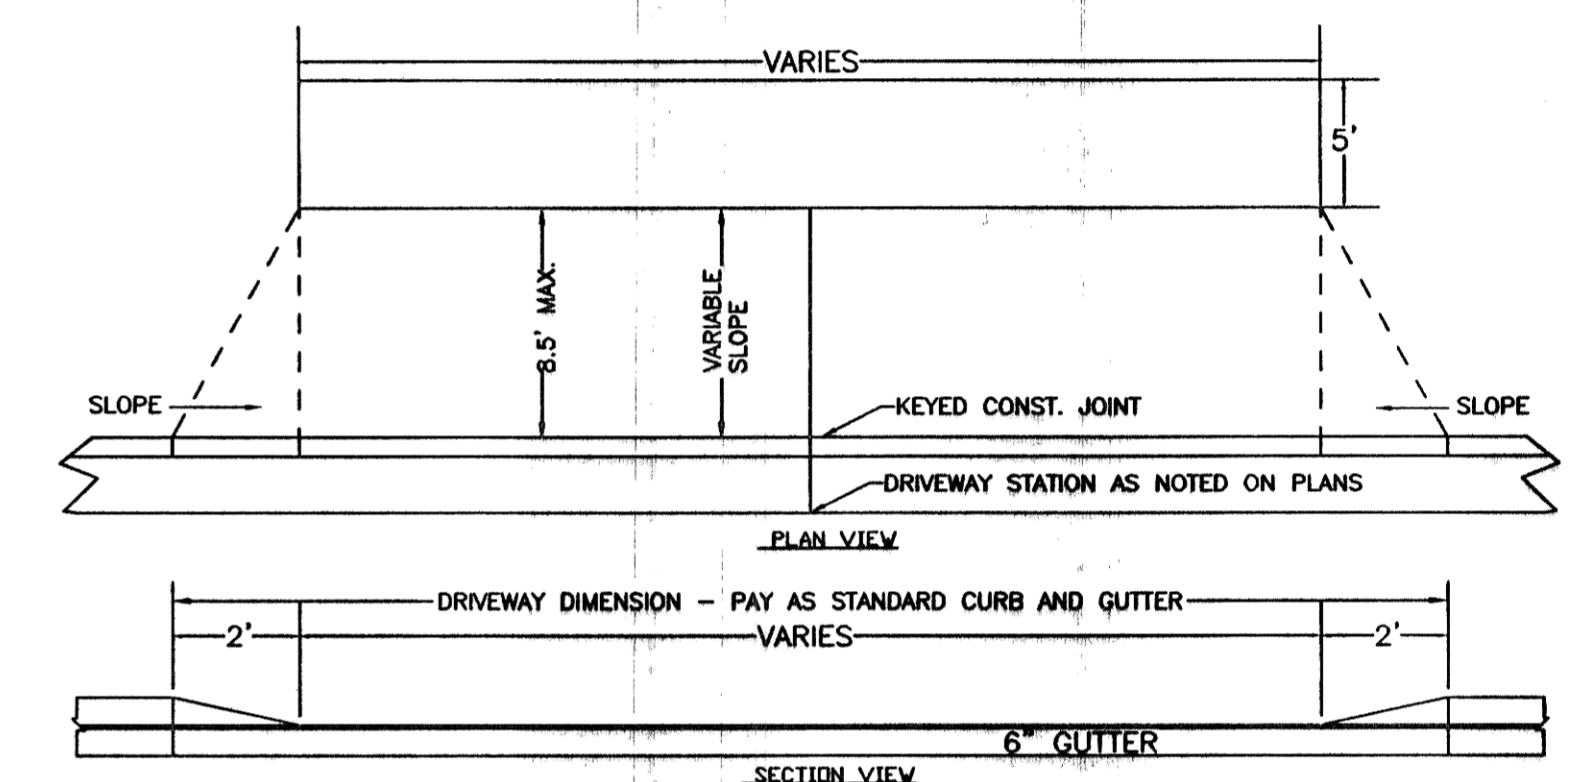


**RESIDENTIAL DRIVEWAY**  
NO SCALE

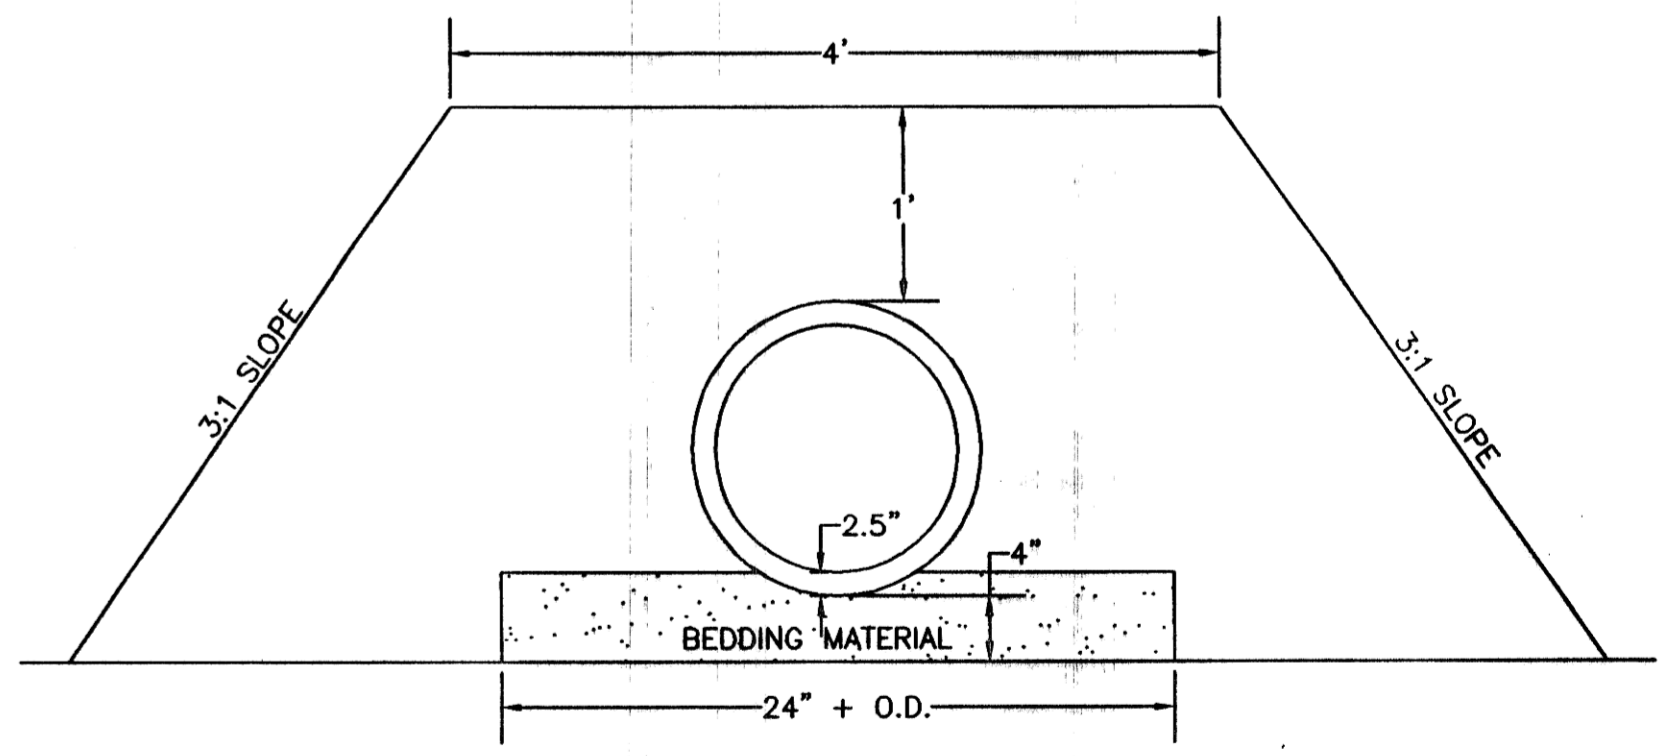

**STORM SEWER BURIAL DETAIL**  
NO SCALE  
STA 0+80.14 TO STA 1+80.22 STORM SEWER EASEMENT  
SEE SHEET 7

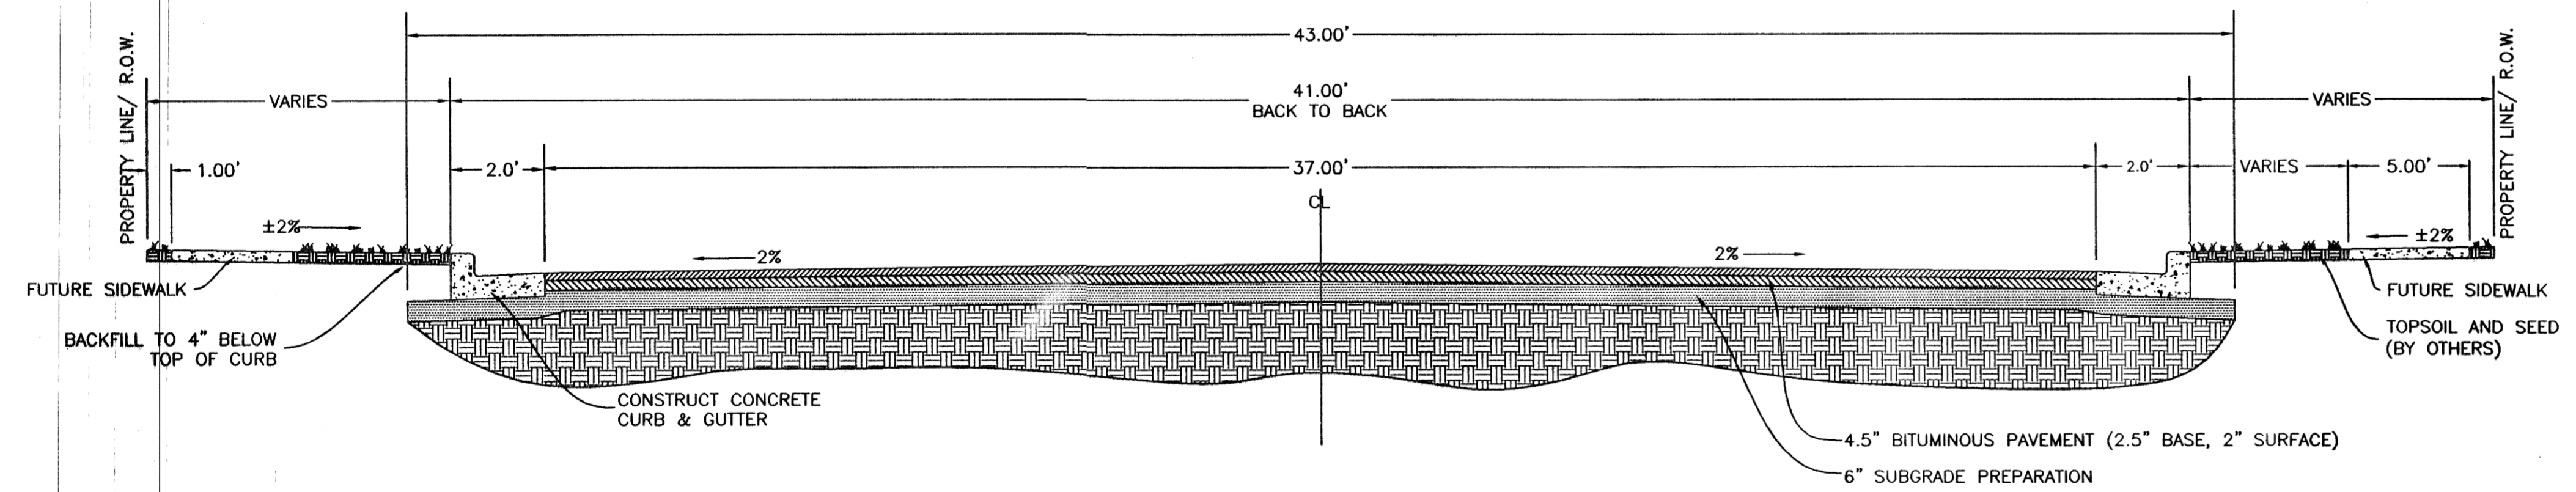

**PLAINVIEW DRIVE AND 27TH STREET SECTION**  
NO SCALE

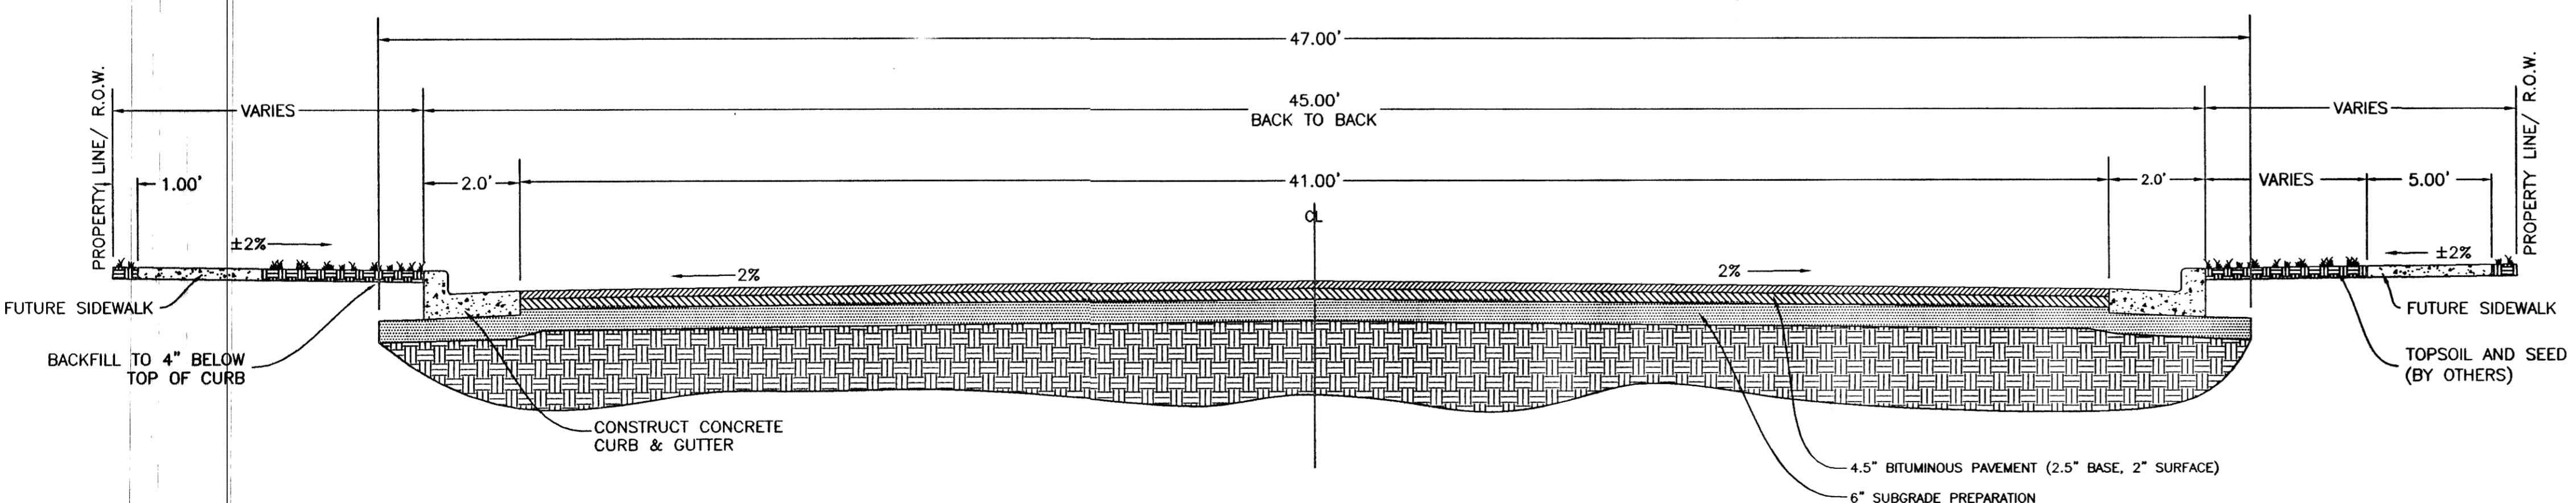

**8TH AVENUE SECTION**  
NO SCALE



RECORD DRAWING

Rev'd.	PLAINVIEW HEIGHTS TENTH ADDITION STREET IMPROVEMENT DISTRICT NO. 2006-01 MANDAN, NORTH DAKOTA	SHEET NO. <b>2</b>
<b>Kadmas Lee &amp; Jackson</b> Engineers Surveyors Planners	DETAILS	
DRWN. BY ADA	CHK'D BY TK	CNTR. NO. 1406104
DATE 05/05/06		
J:\municipal\1406104 - Plainview 10th Streets\CADD\EP\1406104bas.DWG		
© Kadmas, Lee & Jackson, Inc. 2006		