


DELETED  
AREA I

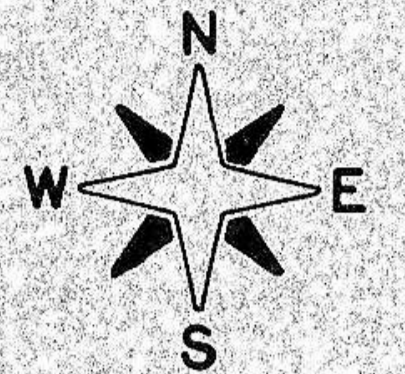

SCALE: 1"=1200'

CITY OF MANDAN N.D

NOTE: AREAS 2, 7 & 12 WERE REMOVED FROM PROJECT PRIOR TO BID LETTING.

LEGEND

- ⊕ = EXISTING POWER POLE
- ⊙ = EXISTING STREET LIGHT
- ⊗ = EXISTING MANHOLE
- ⊠ = EXISTING GAS LINE BOX
- ⊚ = EXISTING STOP SIGN
- ⊙ = EXISTING TREE
- +—+— = EXISTING FENCE
- ⊙ = EXISTING HYDRANT
- ⊙ = EXISTING GATE VALVE
- ▨ = EXISTING ASPHALT
- ▩ = EXISTING CONCRETE
- +—+— = EXISTING GAS MAIN (APPROX. LOCATION)
- +—+— = EXISTING OVERHEAD CABLE (APPROX. LOCATION)

AREA 3

AREA 4

AREA 13

AREA 6

AREA 5

AREA 8

AREA II

AREA IO

AREA 9

NOTE: ALL ASPHALT & CONCRETE REMOVED TO BE HAULED TO CITY LAND FILL.

LEWIS & CLARK GRADE SCHOOL

MANDAN JUNIOR HIGH SCHOOL

ROOSEVELT GRADE SCHOOL

MANDAN ATHLETIC FIELD

PROJECT AND WASTE AREA LAYOUT

STREET IMPROVEMENT DISTRICT NO. 56 MANDAN

SHEET NO. 1 OF 23 SHEETS

