
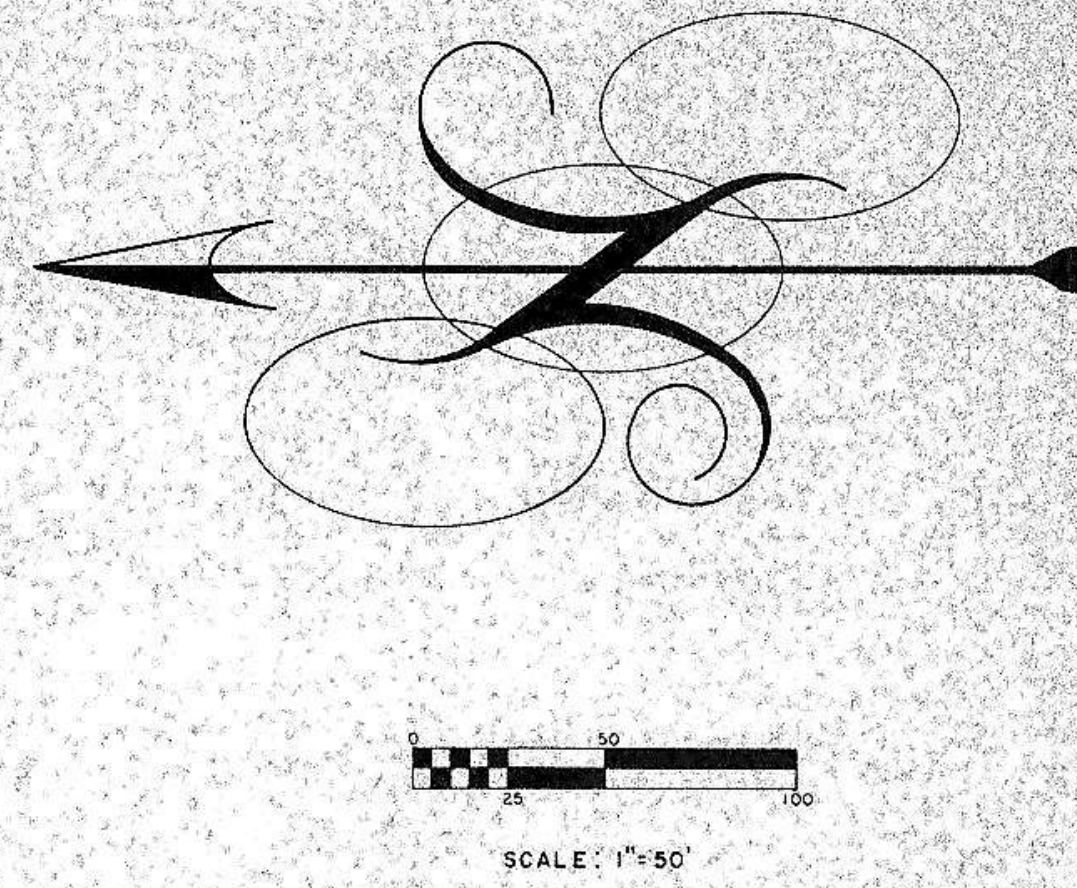


PLAN
 SURVEYED BY _____ DATE _____
 PLOTTED BY _____
 NOTE BOOK NO. _____
 CHECKED BY _____
 DATE _____
 NO. OF REVISIONS _____


PROFILE
 SURVEYED BY _____ DATE _____
 PLOTTED BY _____
 NOTE BOOK NO. _____
 CHECKED BY _____
 DATE _____
 NO. OF REVISIONS _____

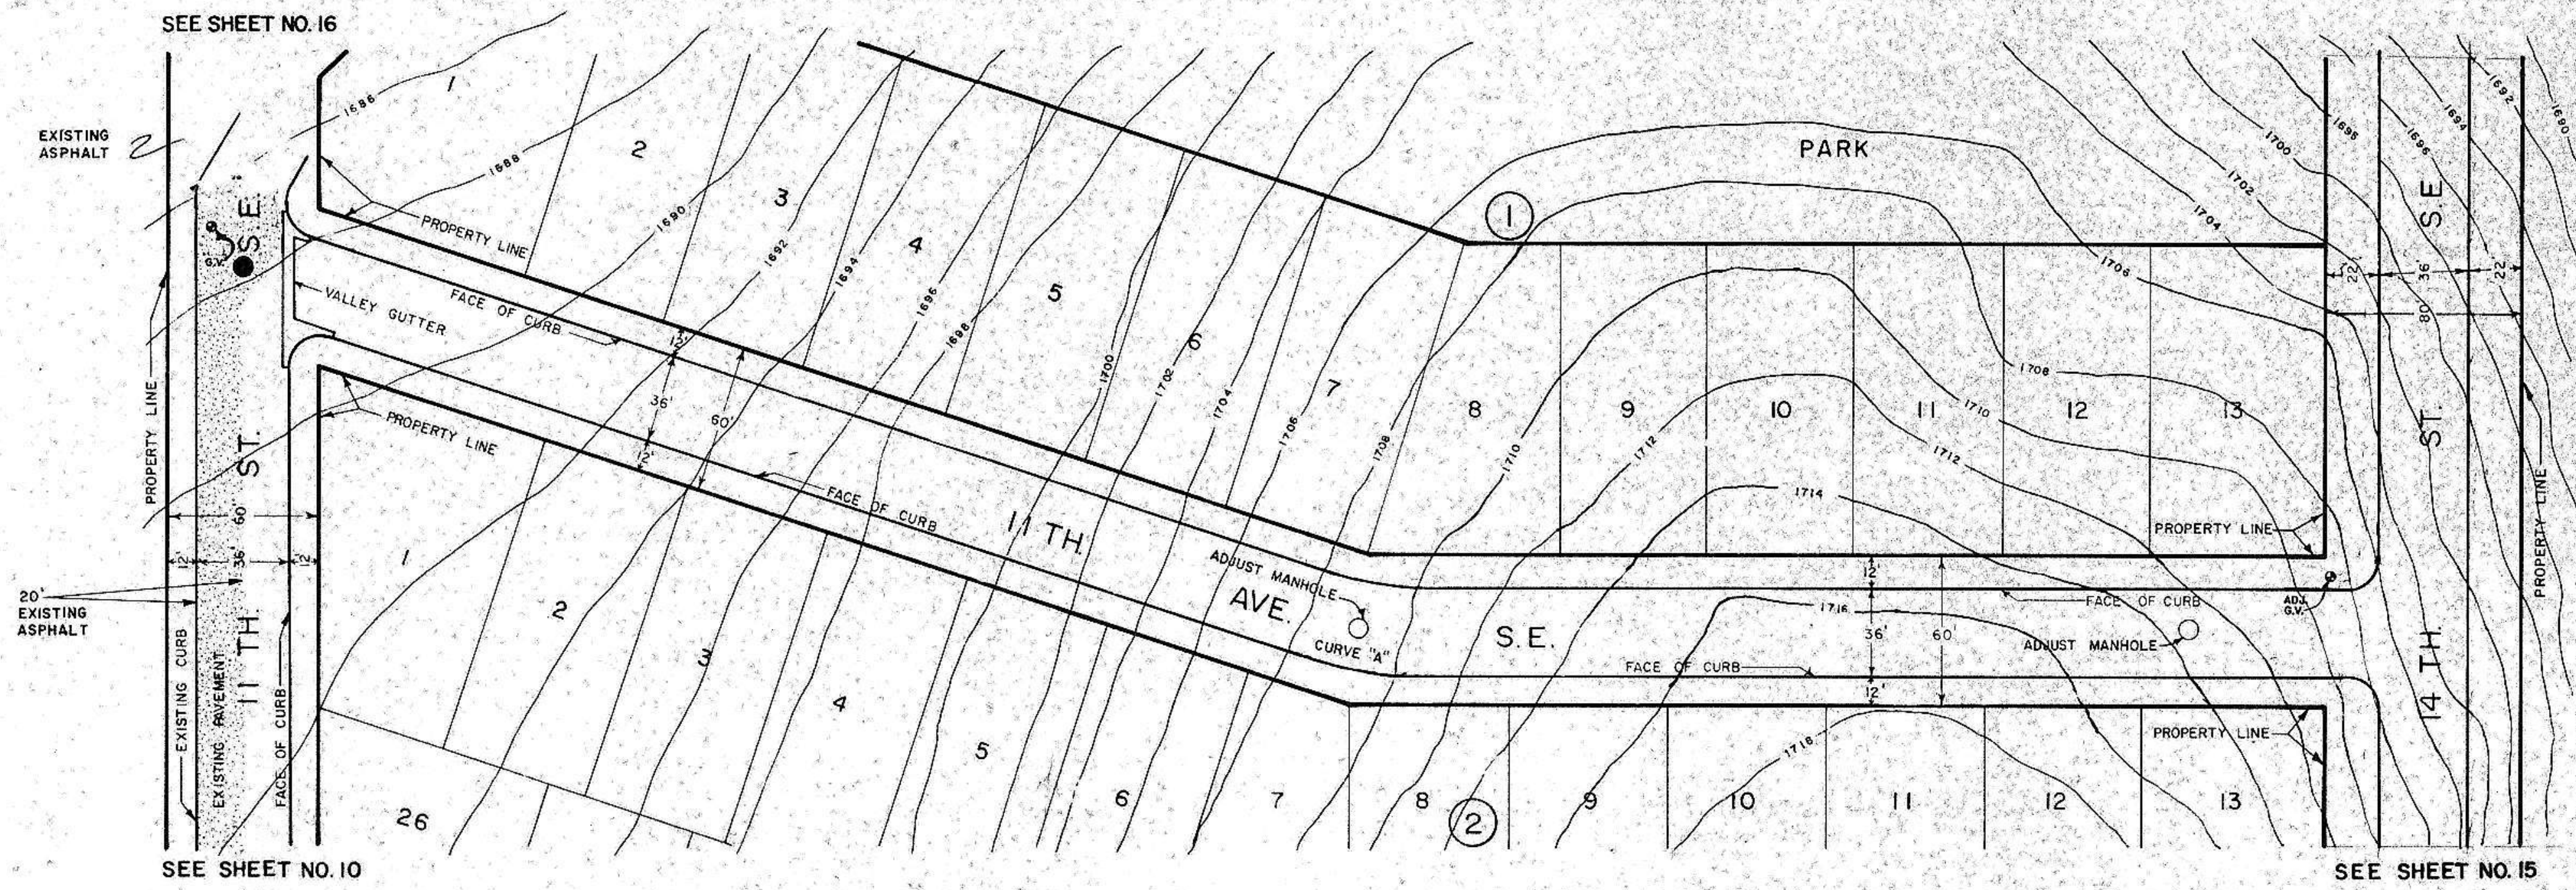

NOTE:
 ALL RADII 12' UNLESS OTHERWISE NOTED.

CURVE "A" - 100' RADIUS
 9th, 10th, & 11th AVENUES TO HAVE SURMOUNTABLE CURB.

NOTE: All streets on this sheet are cut or filled to within 6" of proposed street grade.

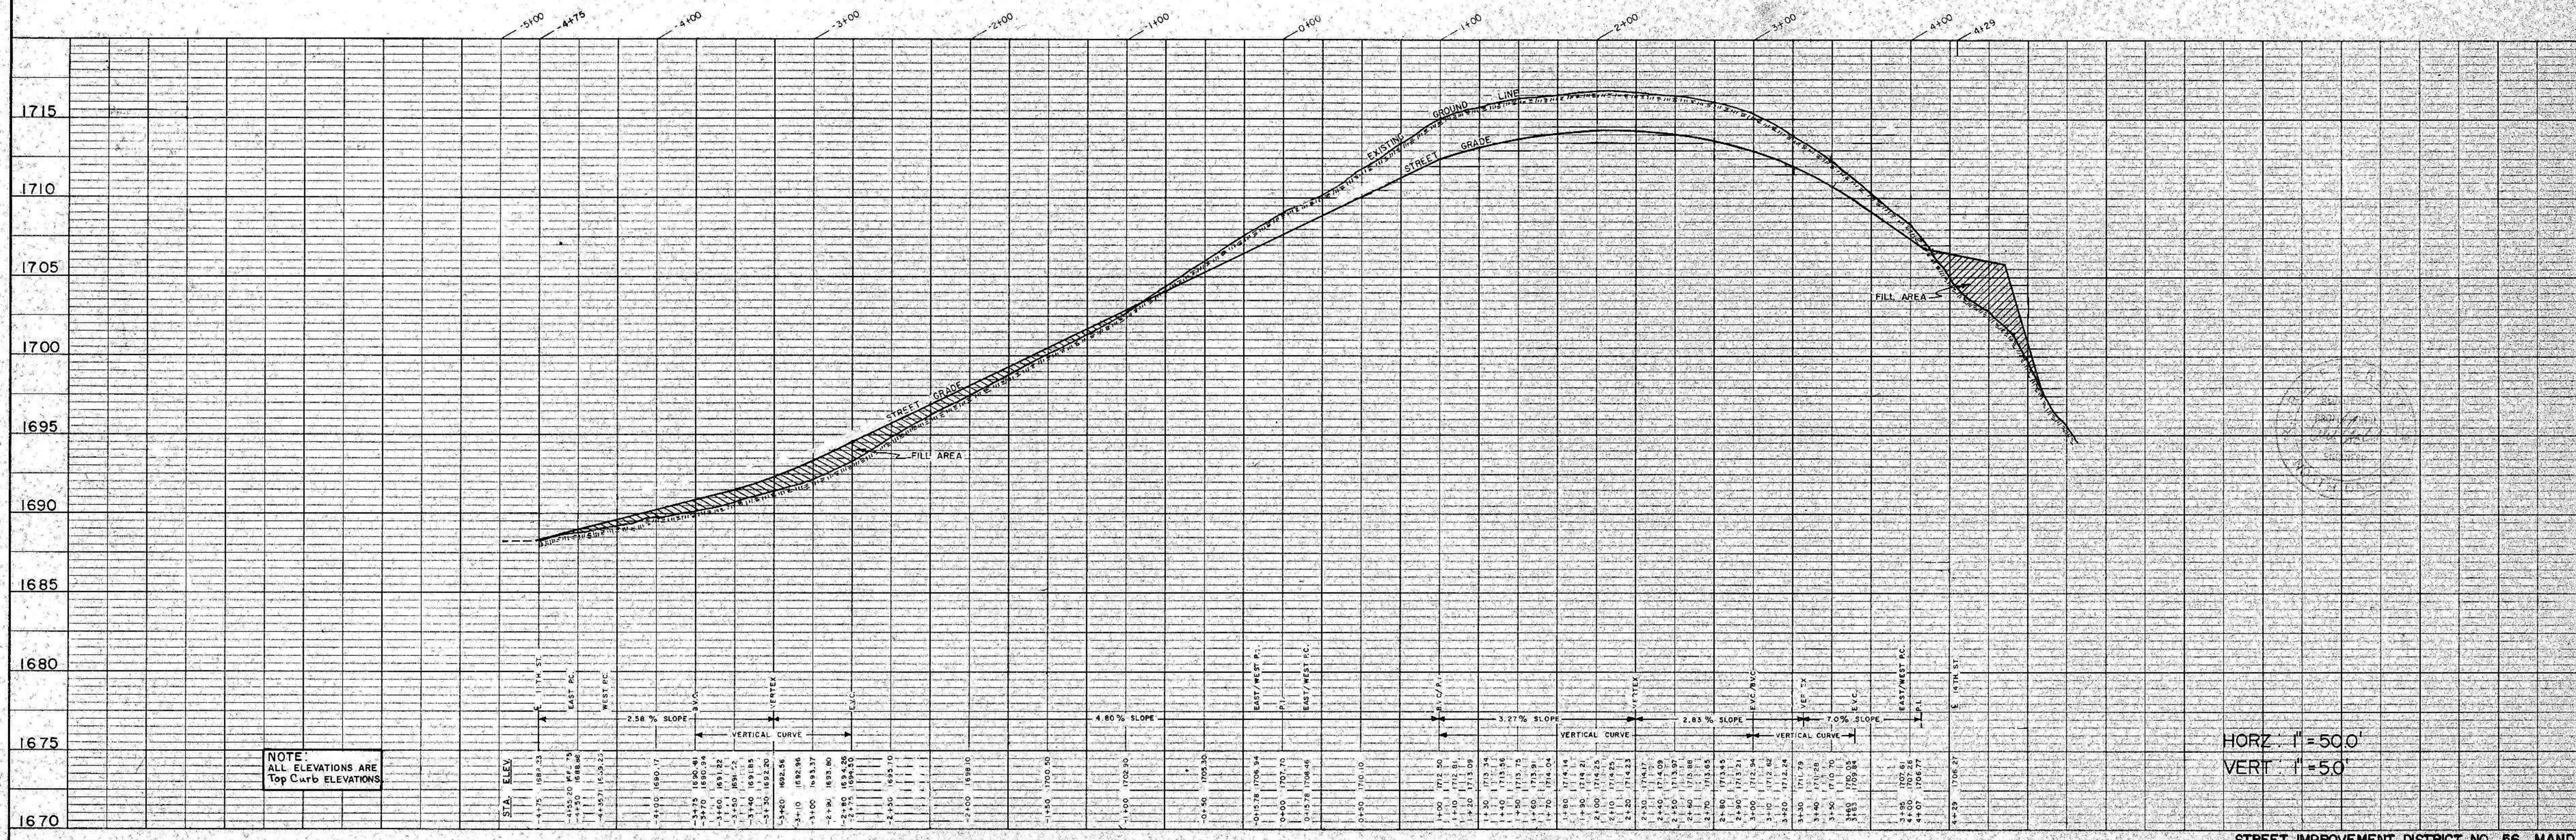

NOTE:
 ALL ELEVATIONS ARE
 Top Curb ELEVATIONS

HORIZ. 1"=50'
 VERT. 1"=50'