
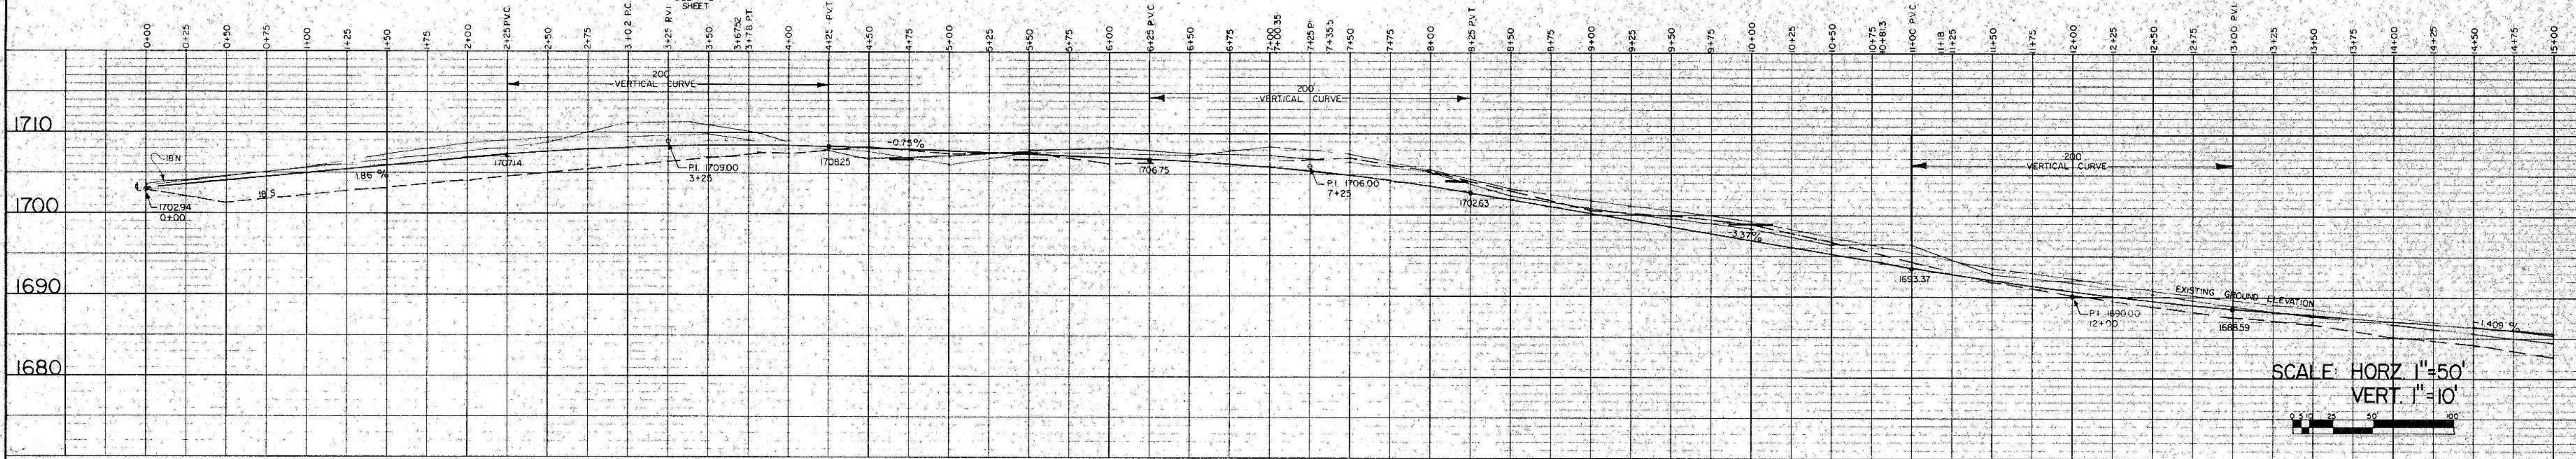


HELMSWORTH-McLEAN ADDITION
THIRD STREET N.E.



⊕ INDICATES UTILITY POLE

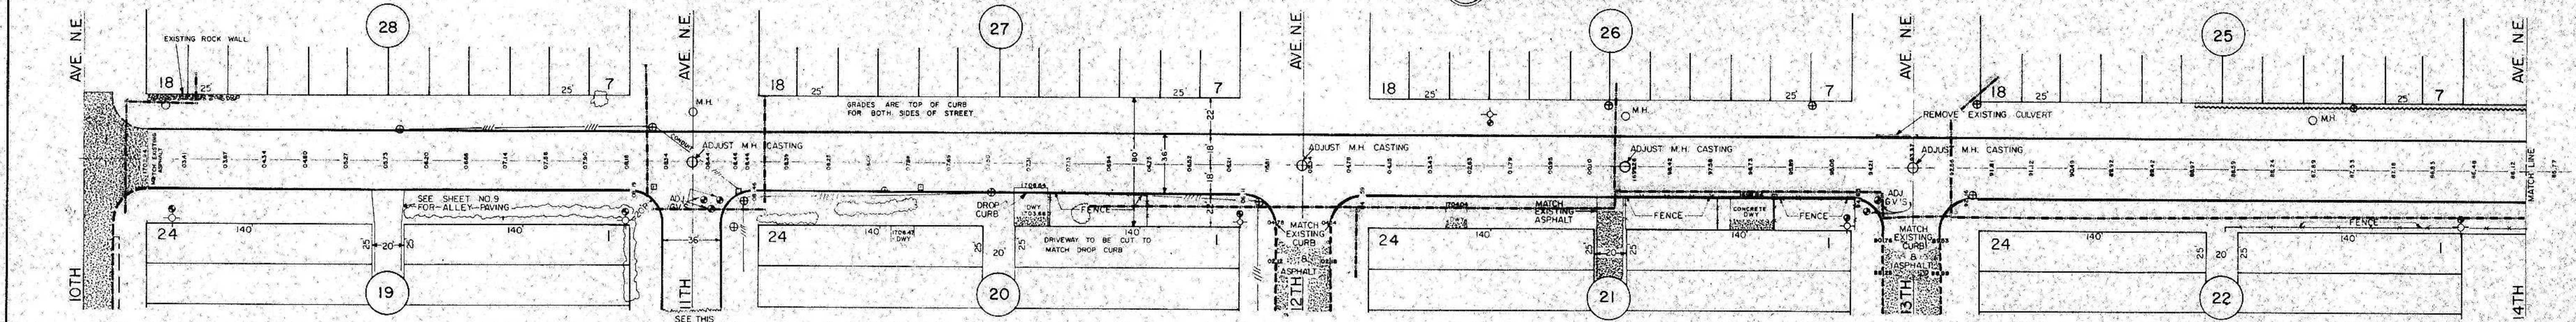

SCALE: HORZ 1"=50'
VERT. 1"=10'

11TH AVE N.E.
HELMSWORTH-McLEAN ADDITION

14TH STREET S.E.

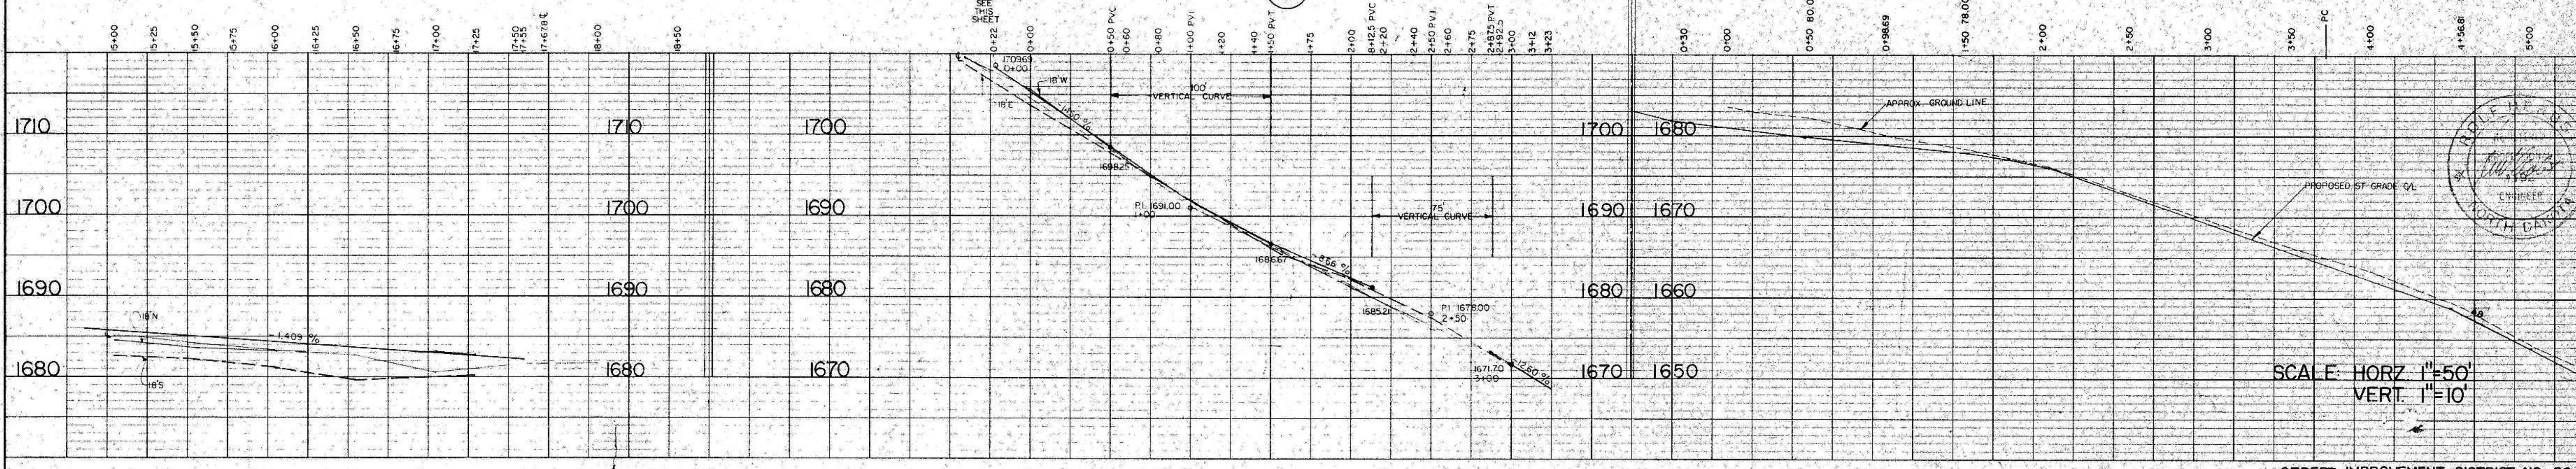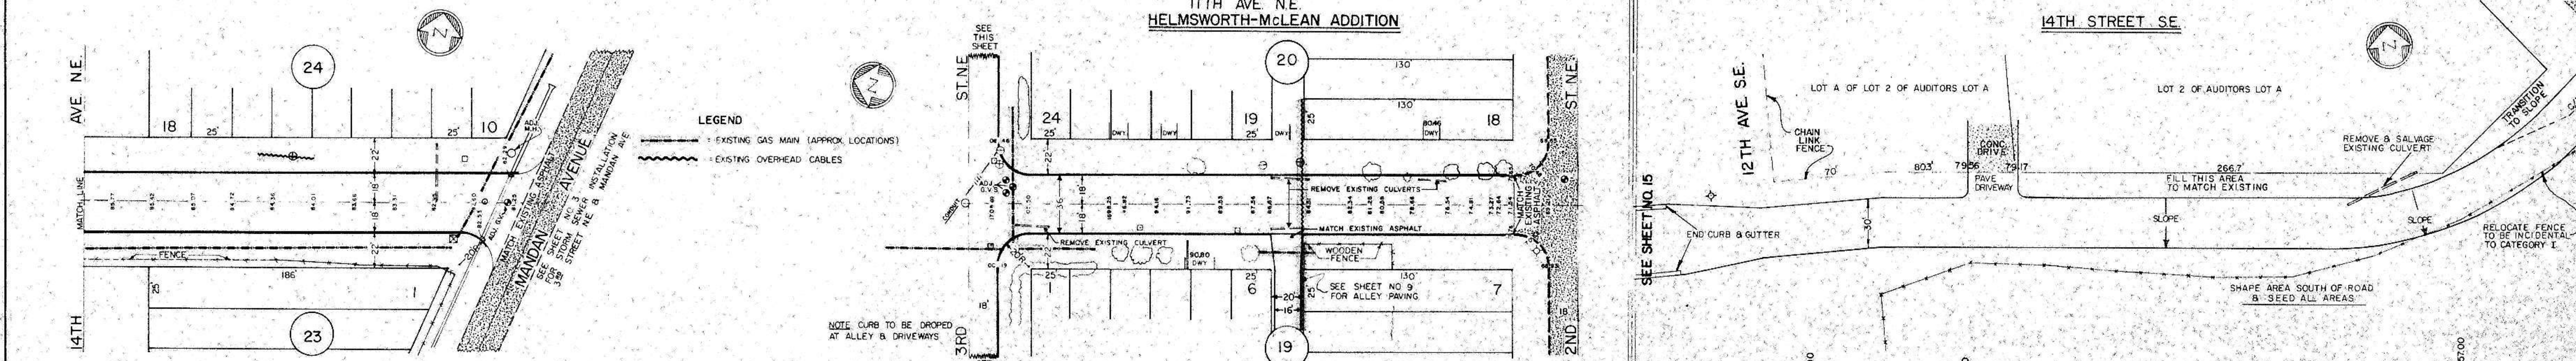

SCALE: HORZ 1"=50'
VERT. 1"=10'

DATE	
BY	
REVISION	
NO.	
PLAN	
NOTE BOOK	
No.	
ALIGNED CHECKED	
BY	
DATE	

DATE	
BY	
REVISION	
NO.	
PROFILE	
NOTE BOOK	
No.	
GRADES CHECKED	
BY	
DATE	