


**LEGEND SYMBOLS**



- NEW STREET LIGHT UNIT
- ◐ RELOCATED STREET LIGHT UNIT
- EXISTING STREET LIGHT UNIT
- ⊠ FEED POINT - NEW
- ⊞ FEED POINT - EXISTING
- UNDERGROUND CONDUCTOR (direct burial)
- UNDERGROUND CONDUCTOR (conduit encased)
- UNDERGROUND CONDUCTOR (existing)
- NUMBER OF CONDUCTORS
- B UNIT NUMBER & TYPE
- B-2 150 watt HIGH PRESSURE SODIUM
- B-1 250 watt " " "
- BR 150 watt " " "
- DRIVEWAY & WIDTH
- JUNCTION BOX

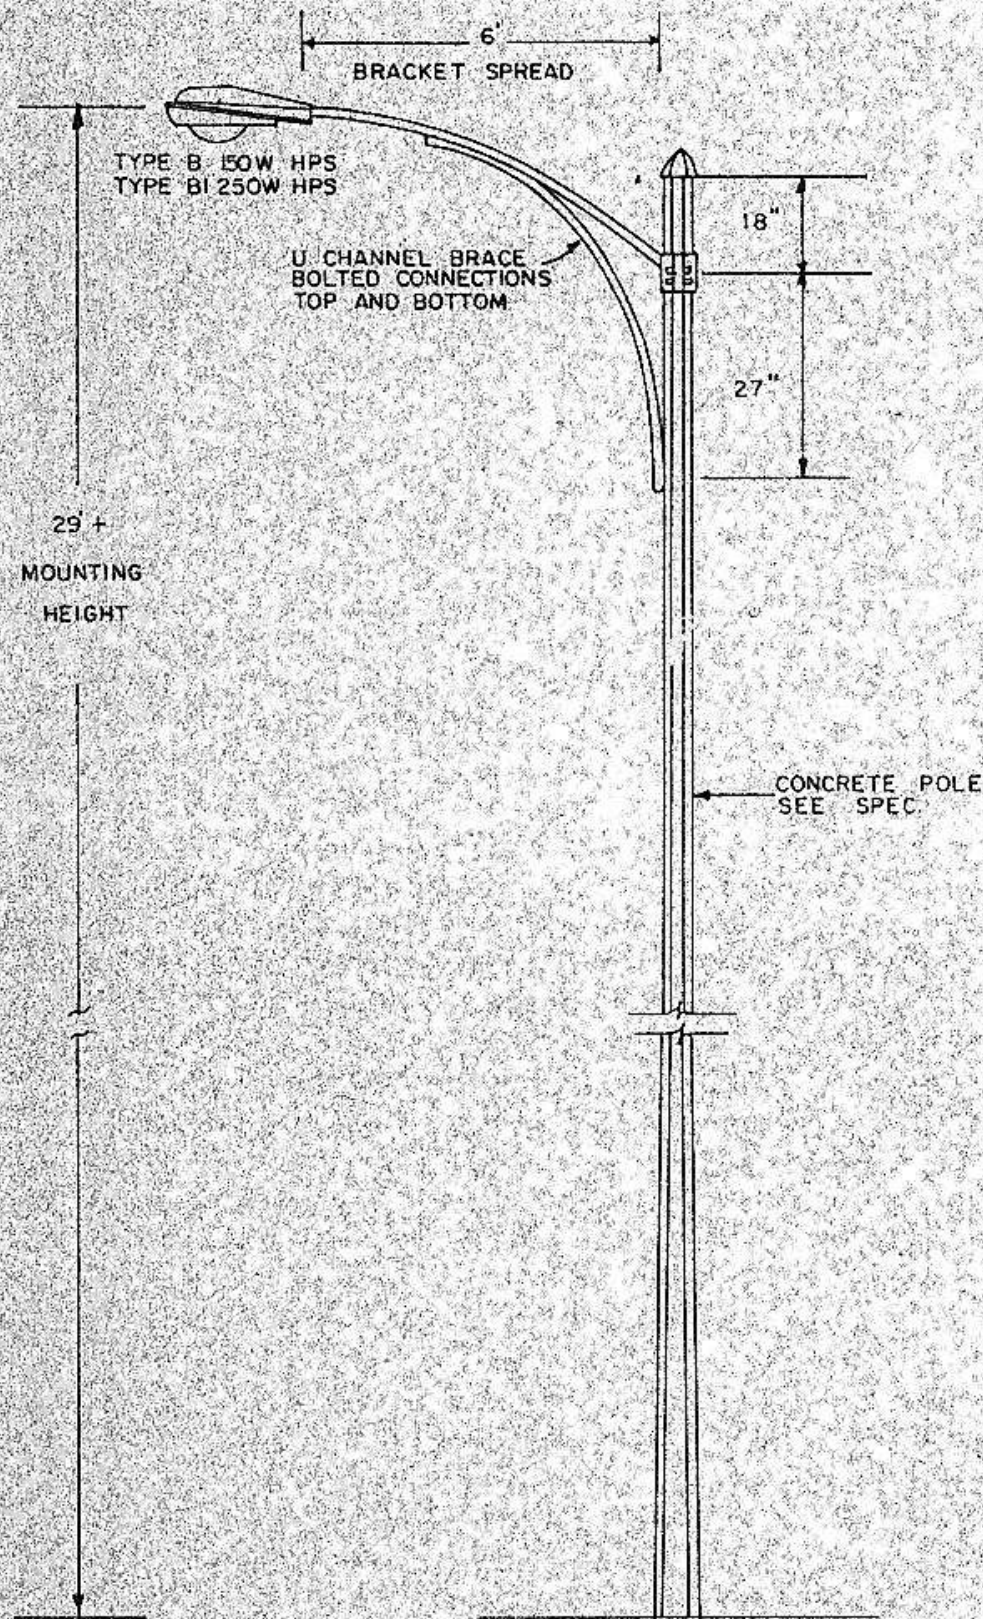


**TYPE B, B1, & B1X POLE DETAIL**  
NO SCALE



**REPLAT OF PLAINVIEW HEIGHTS FIRST ADDITION**  
STREET LIGHTING - STREET IMPROVEMENT DISTRICT 58

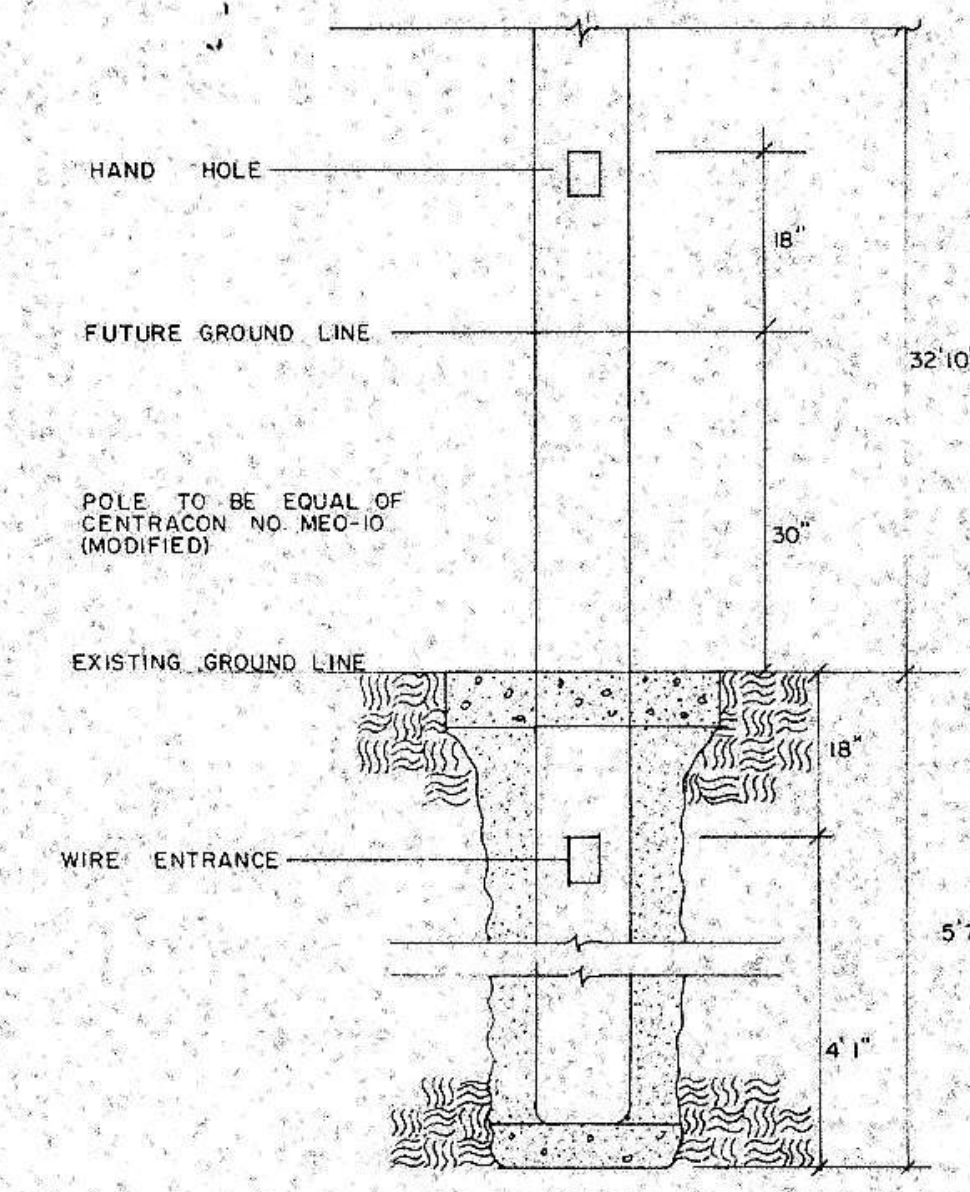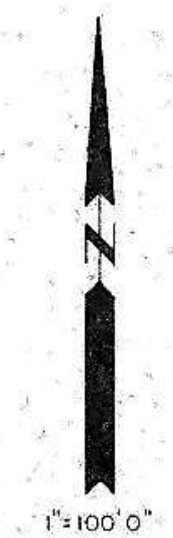

**TYPE B1X BASE DETAIL**  
NO SCALE

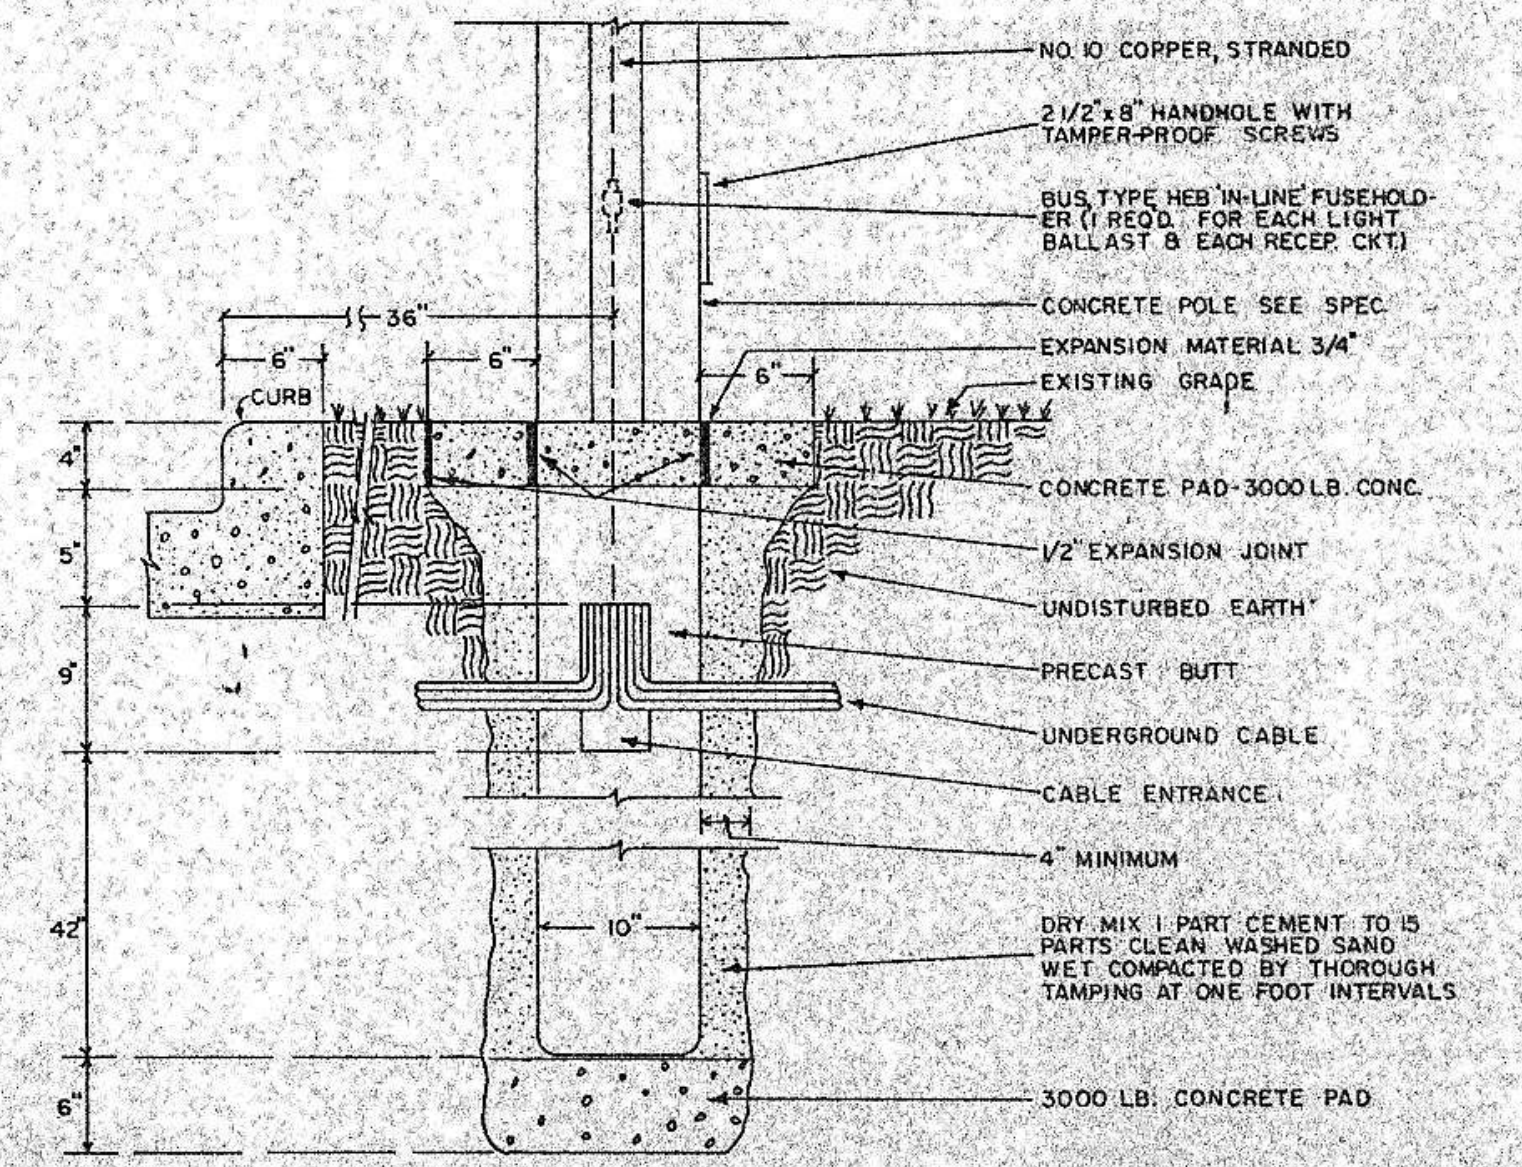

**TYPE B & B1 BASE DETAIL**  
NO SCALE