

# NORTH SHORE LOOP SE



AREA 3

SCALE:  
HOR. 1"=30'  
VERT. 1"=2'

CONSTRUCTION NOTES  
1. ALL STATIONING IS TO CENTERLINE OF STREET.

R.M. - NE FLANGE BOLT, HYDRANT; W SIDE PAVTAL LOOP SE,  
ACROSS FROM LOT 1, BACKSHORES OF MARINA BAY, 1637.70

C CURVE DATA					
	Δ	T	L	R	
C	45°00'00"	111.84	212.06	270.00	
D	75°00'00"	72.90	124.95	95.00'	

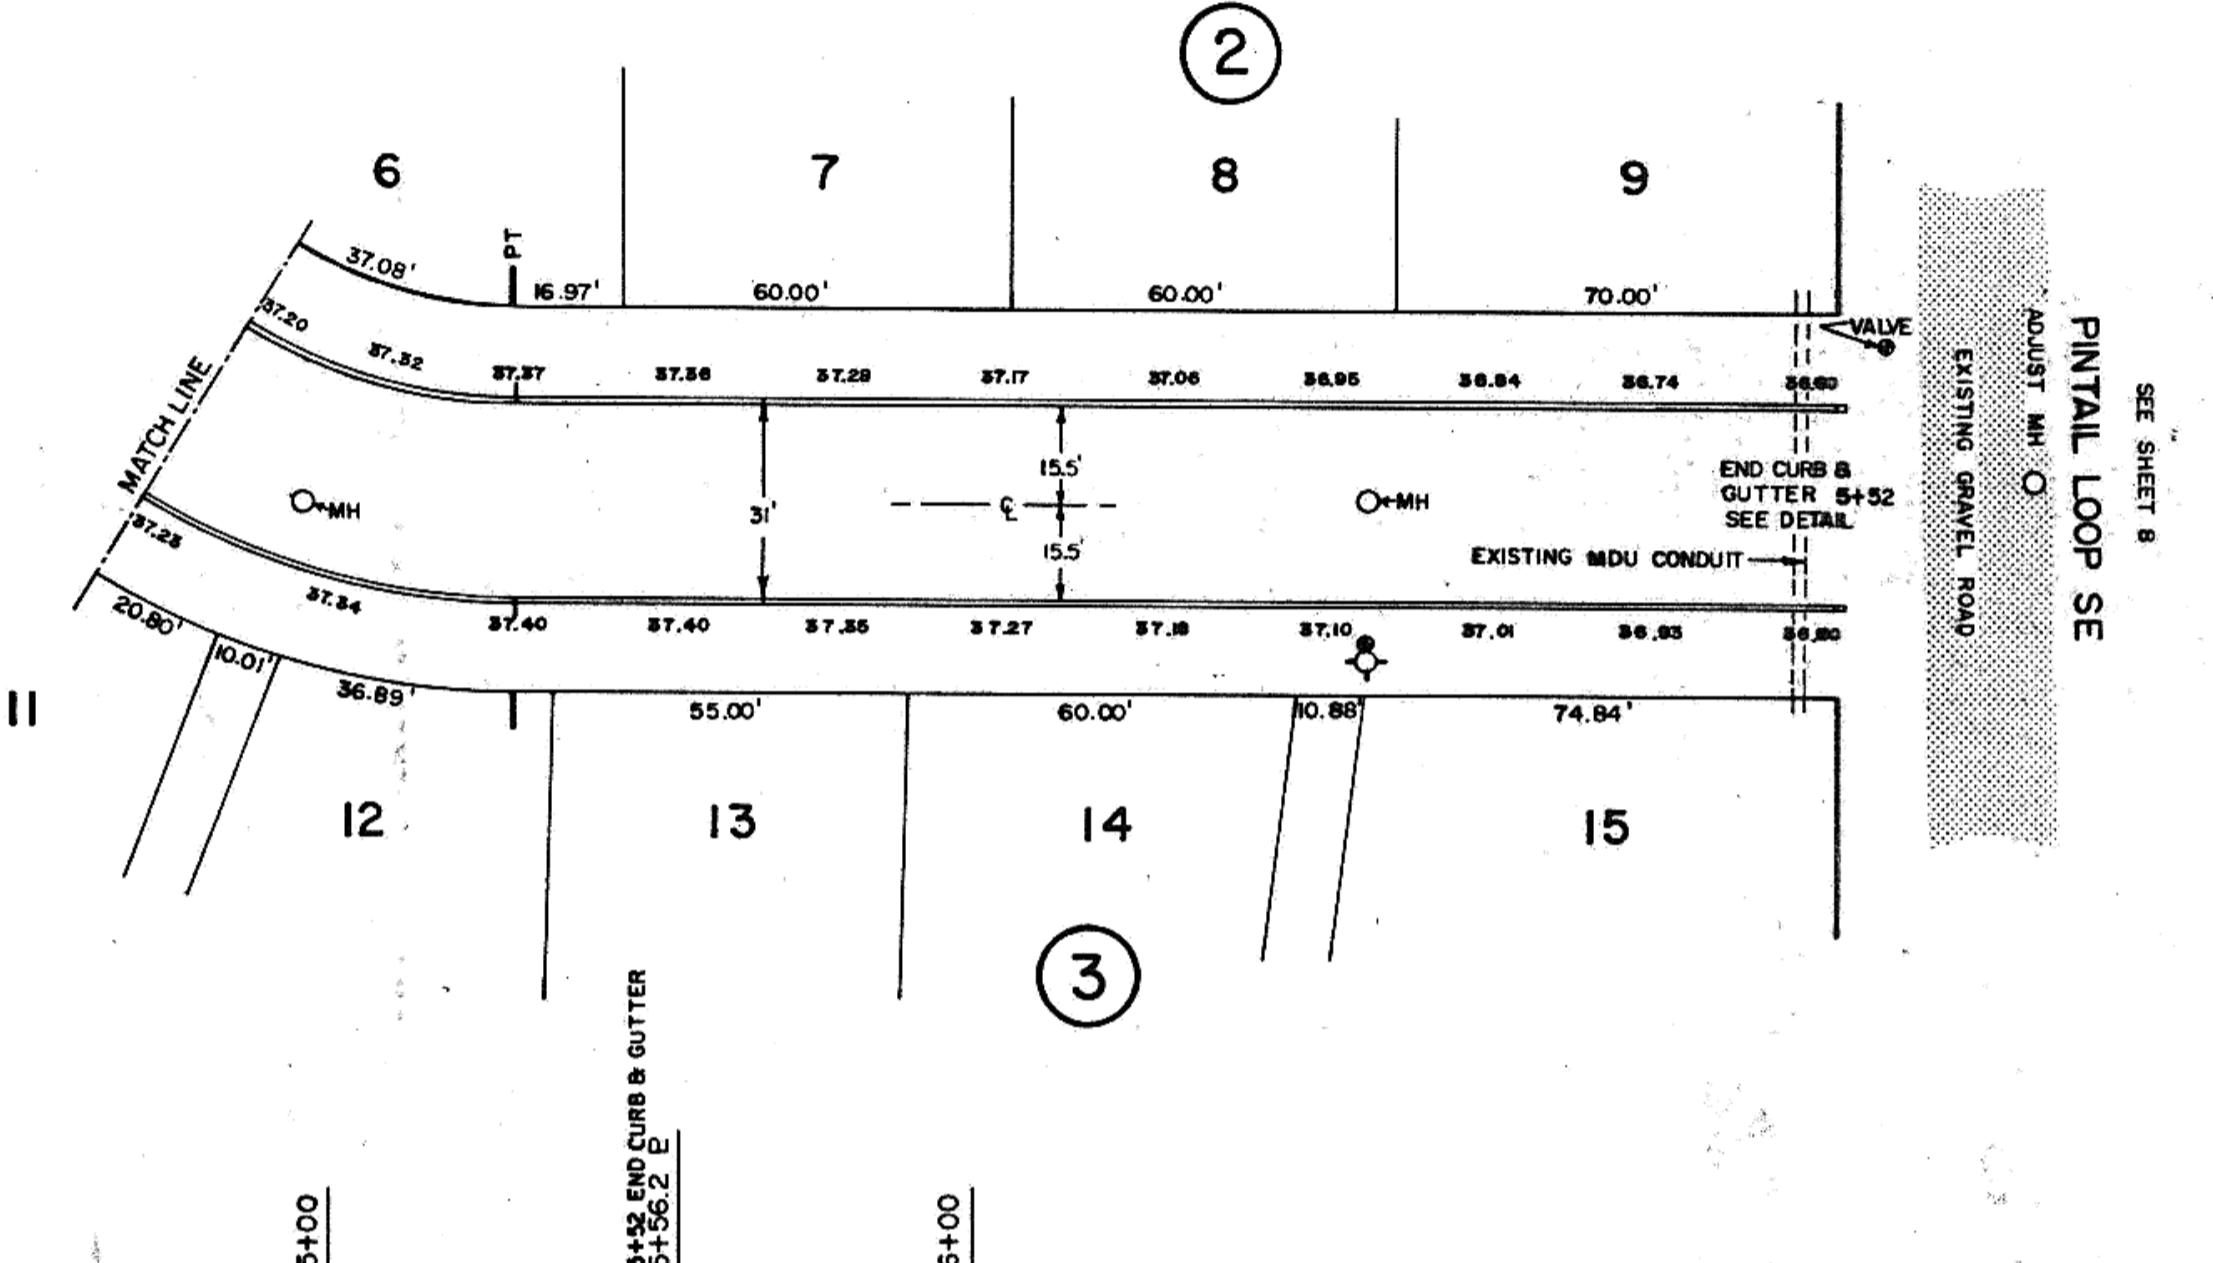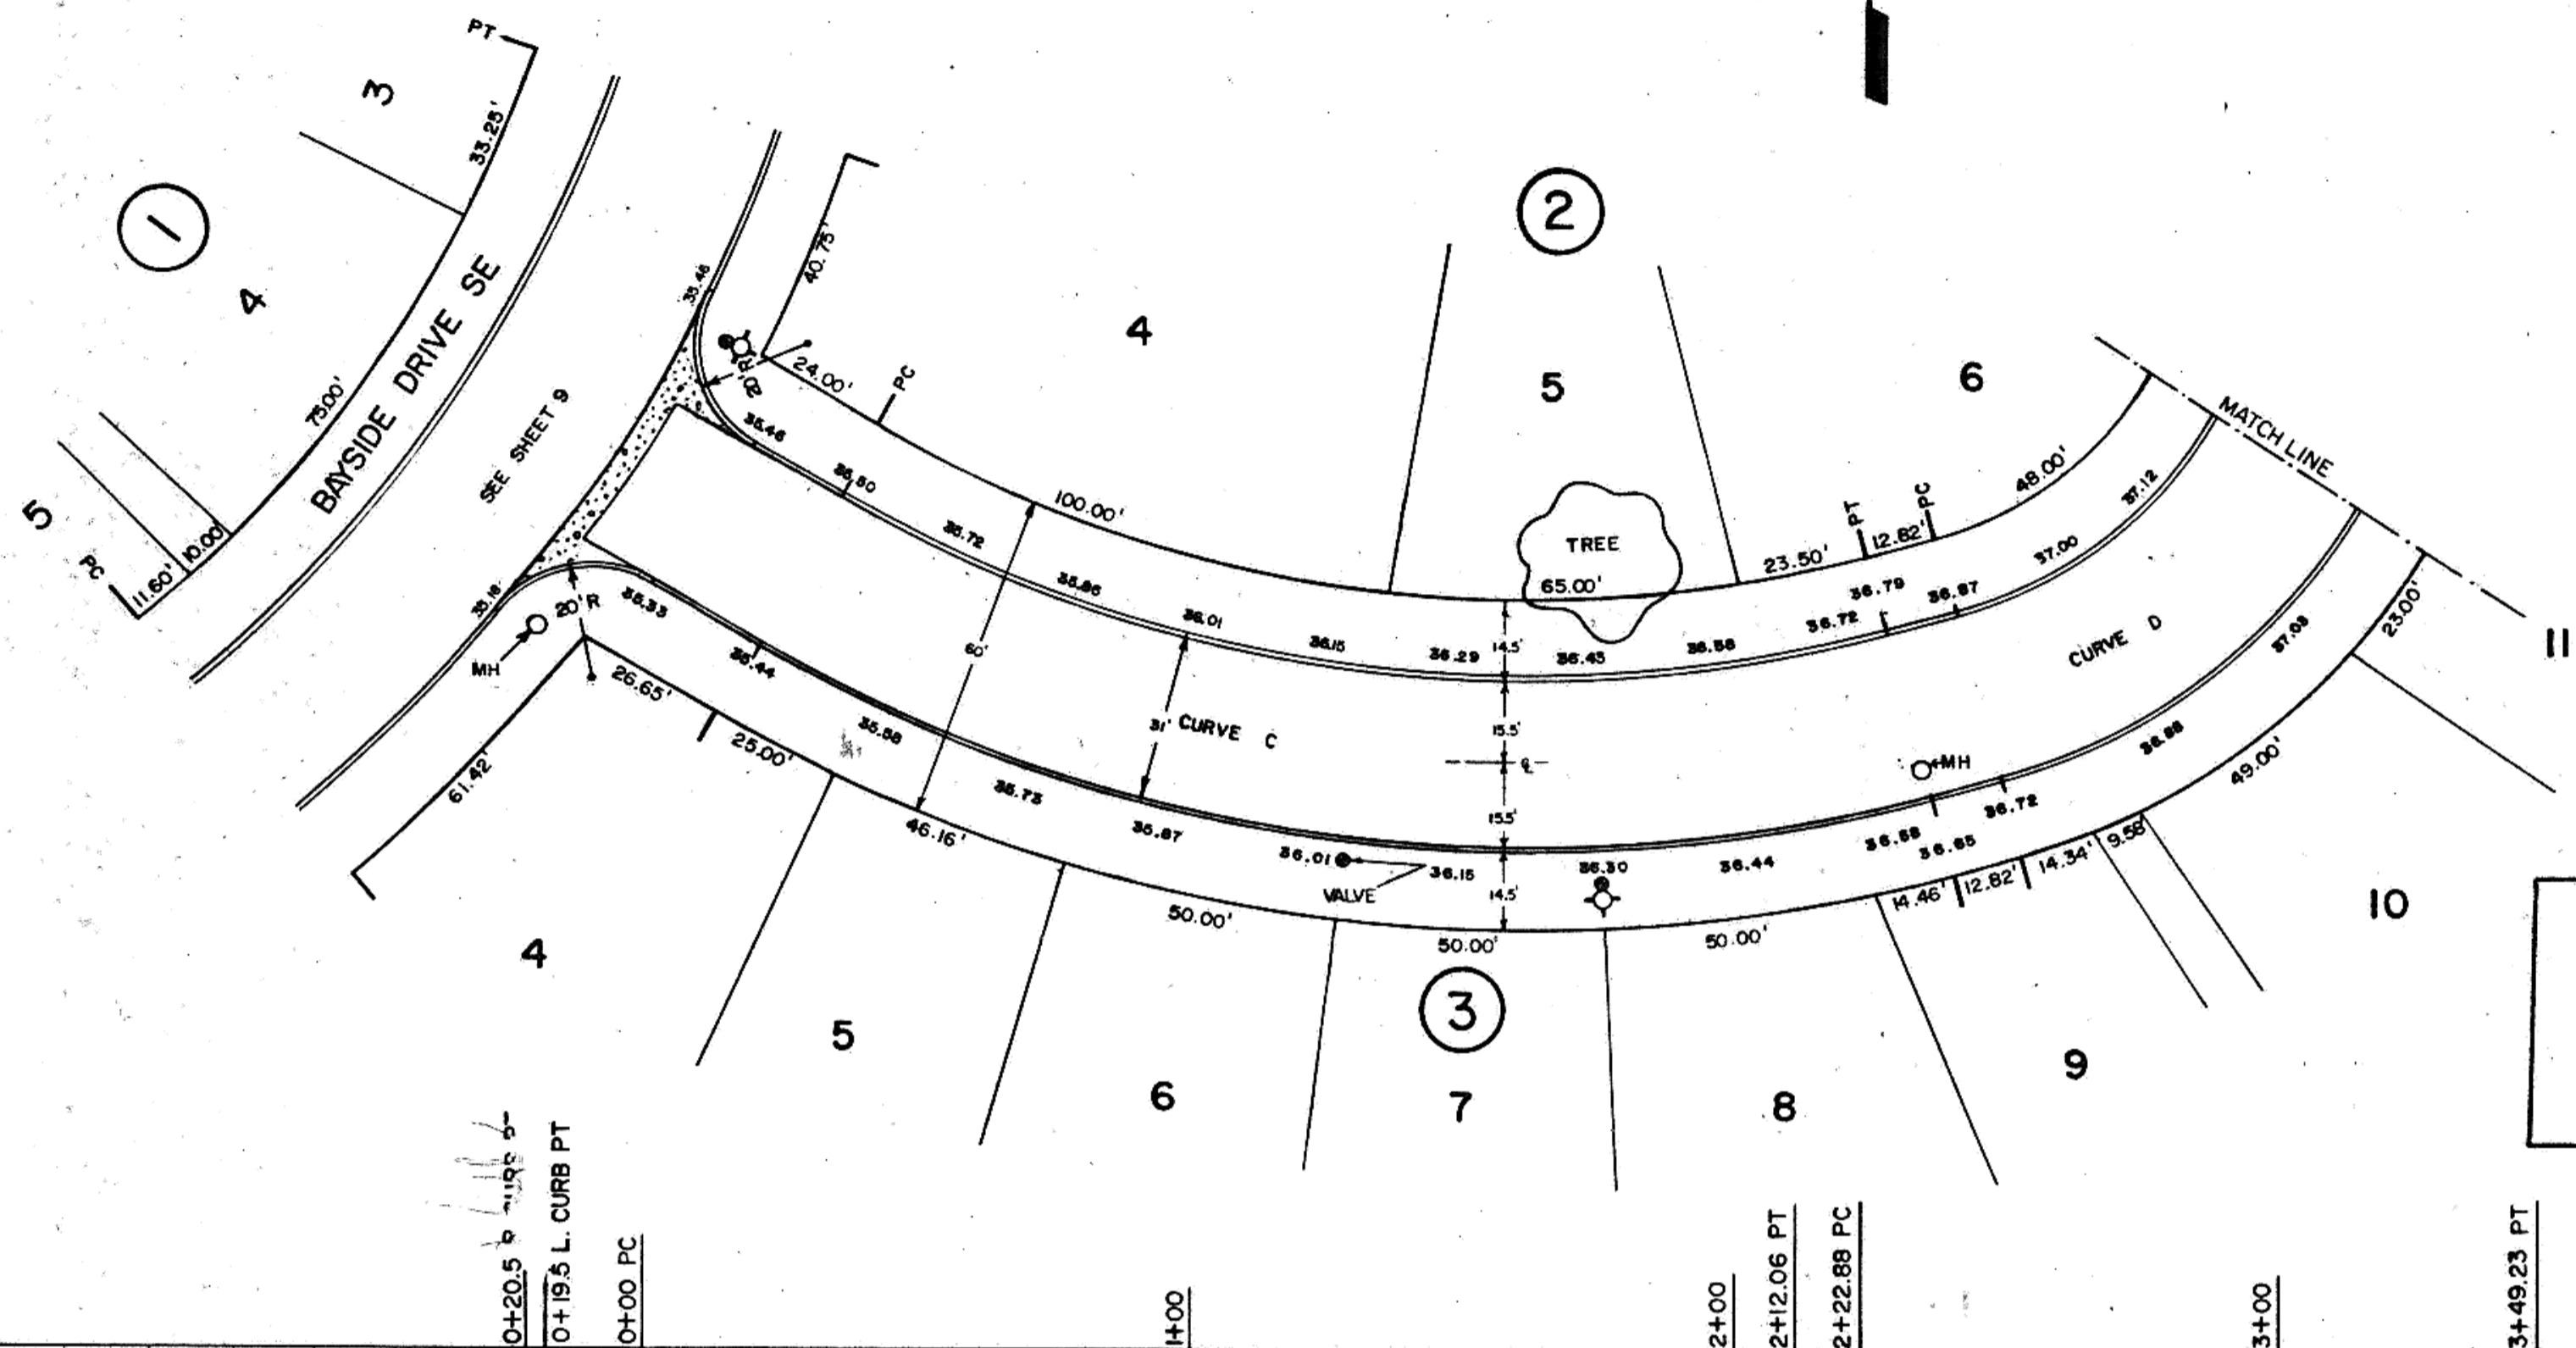

**CAUTION**  
LOCATE ALL BURIED  
UTILITIES BEFORE DIGGING.  
**OVER HEAD POWER**

**PLAN**  
 SURVEYED, AS-BUILT, CORRECTIONS BY: JPH  
 NOTE BOOK ALIGNED, CHECKED: RT. OF WAY CHECKED: NO

**PROFILE**  
 DATE: 11-91  
 BY: JPH  
 CHECKED: B. M. NOTED  
 NO. 185

