


HIGHLAND ROAD
AREA A
INTERSECTION DETAIL



LEGEND
 --- DENOTES NEW ROAD
 ▨ DENOTES EXISTING ASPHALT
 ▩ DENOTES EXISTING GRAVEL

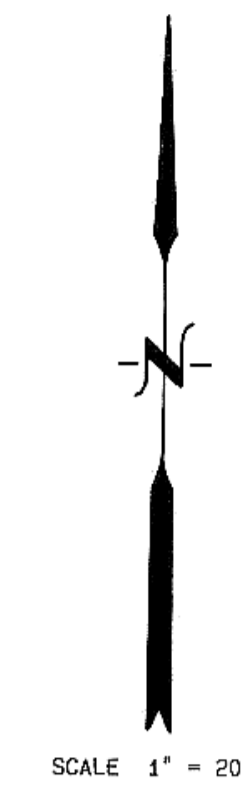