



AREA "A"

STREET IMPROVEMENT DIST. 86


MANDAN, NORTH DAKOTA

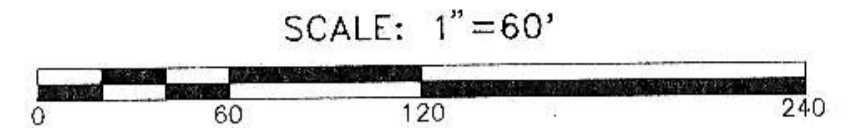

CAUTION
LOCATE ALL BURIED
UTILITIES BEFORE DIGGING
OVER HEAD POWER


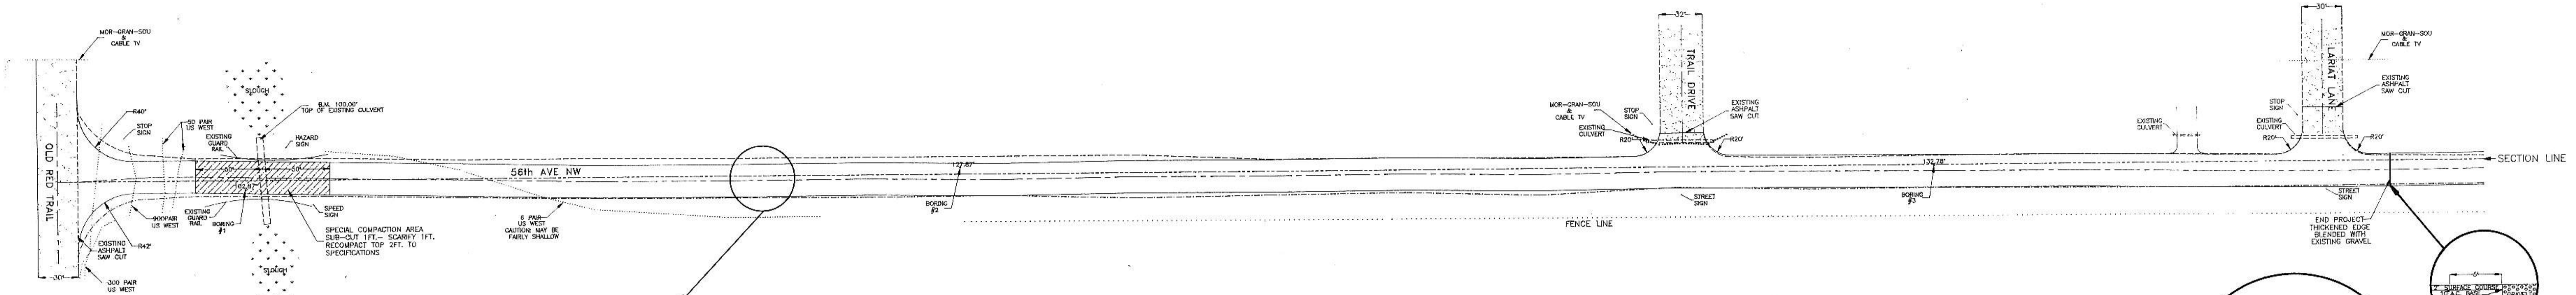


- NOTE:**
1. ALL DISTURBED AREAS TO BE SEEDED
 2. CONTRACTOR TO MAINTAIN TRAFFIC AT ALL TIMES. CONSTRUCTION SIGNING TO BE INCIDENTAL TO PROJECT

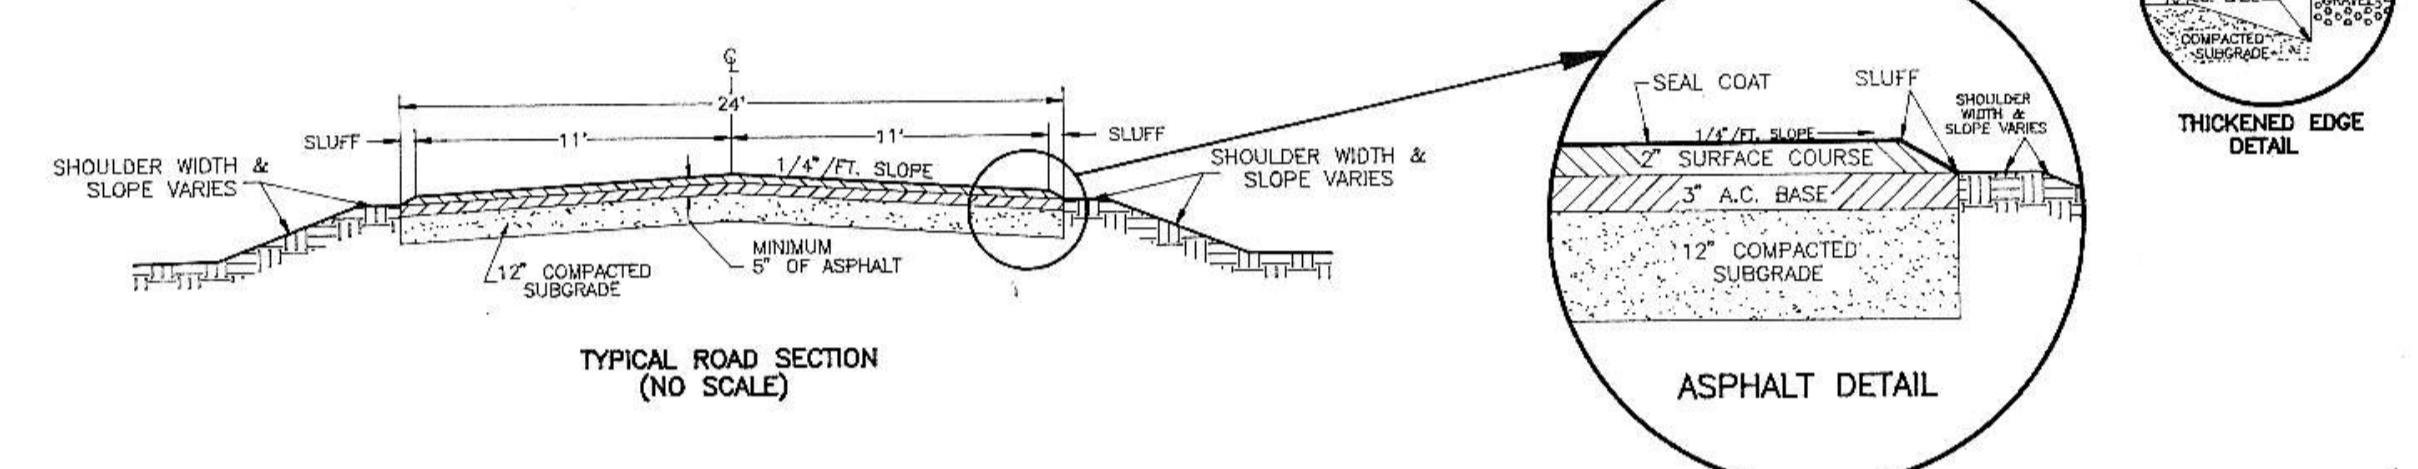

CAUTION
LOCATE ALL BURIED
UTILITIES BEFORE DIGGING
OVER HEAD POWER

SCALE: HORZ: 1"=60'
VERT: 1"=5'

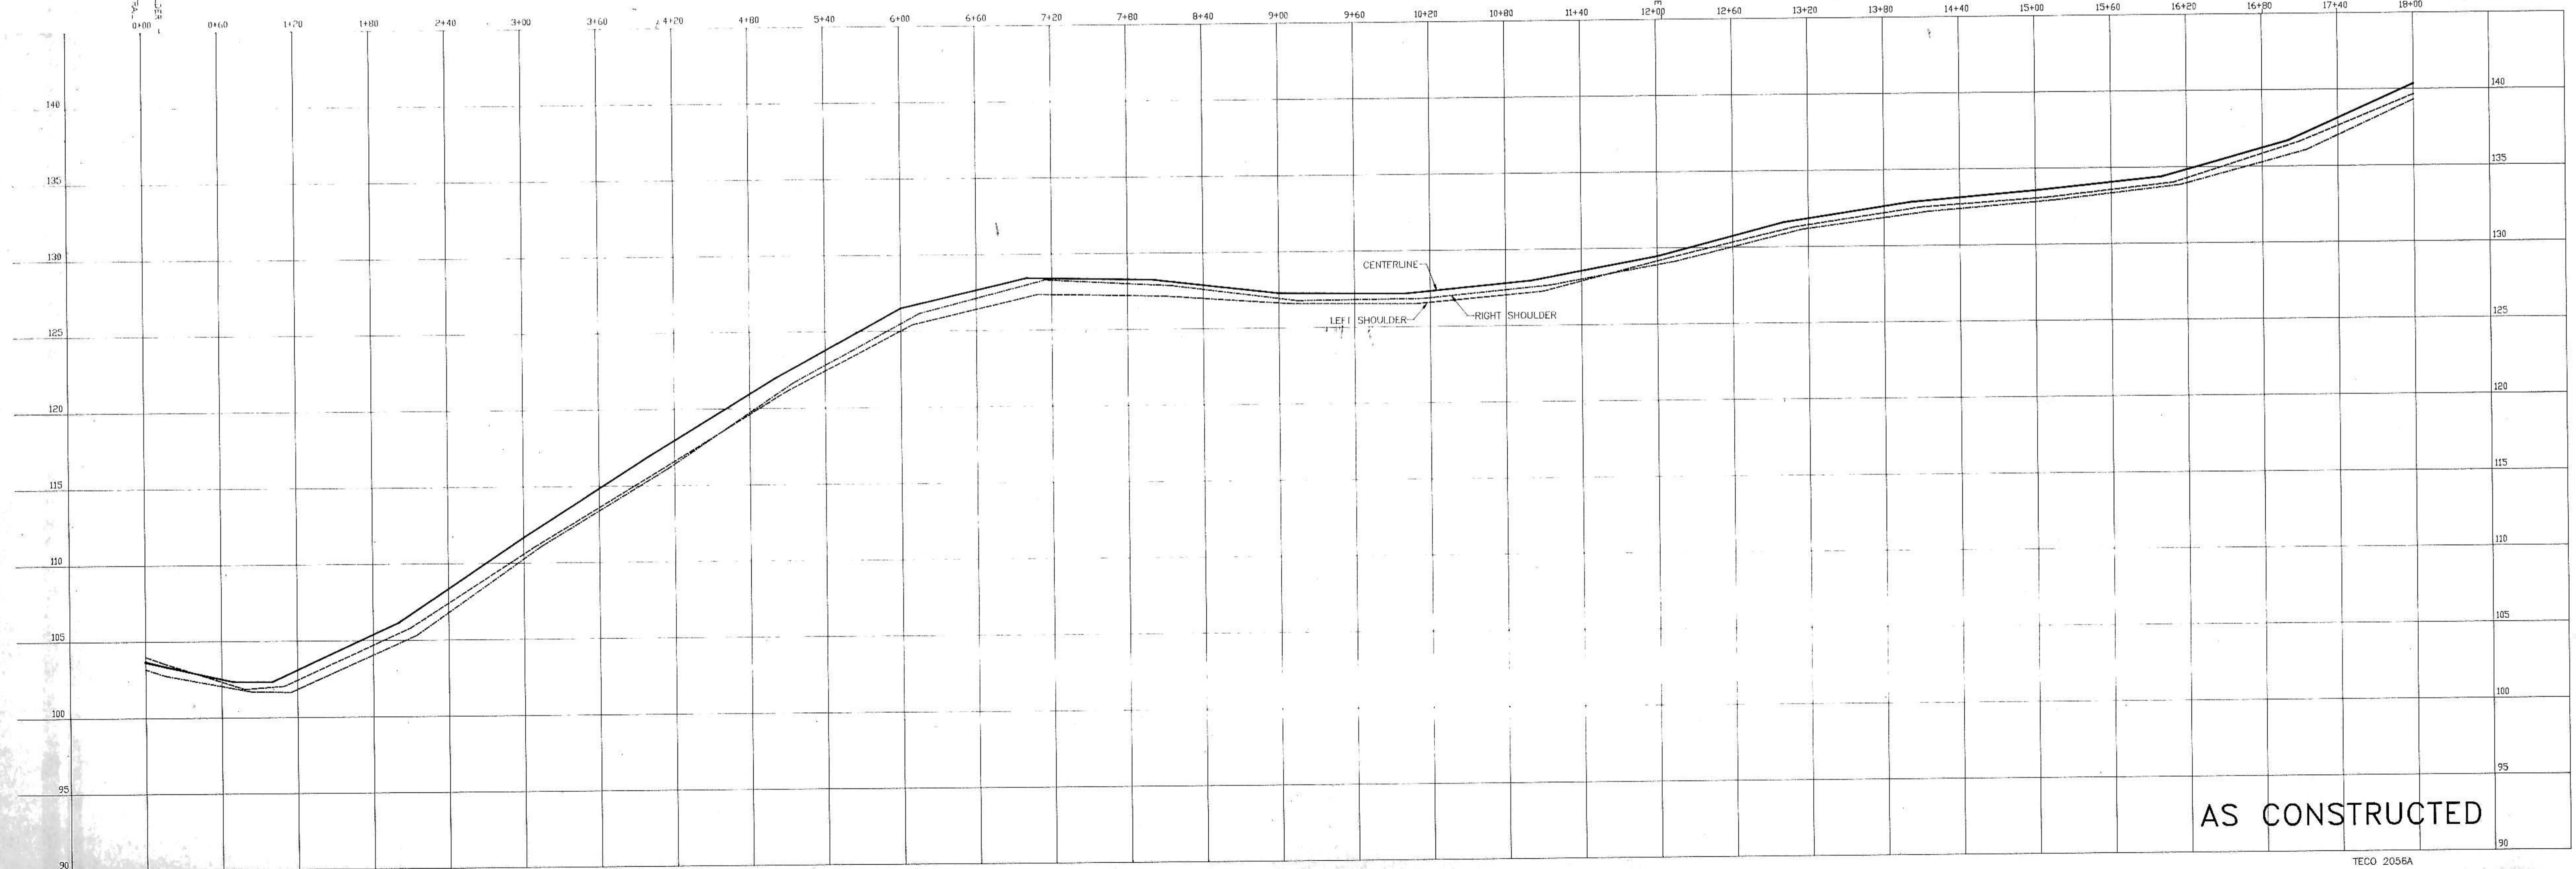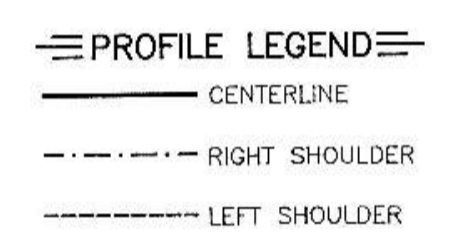

AS CONSTRUCTED