
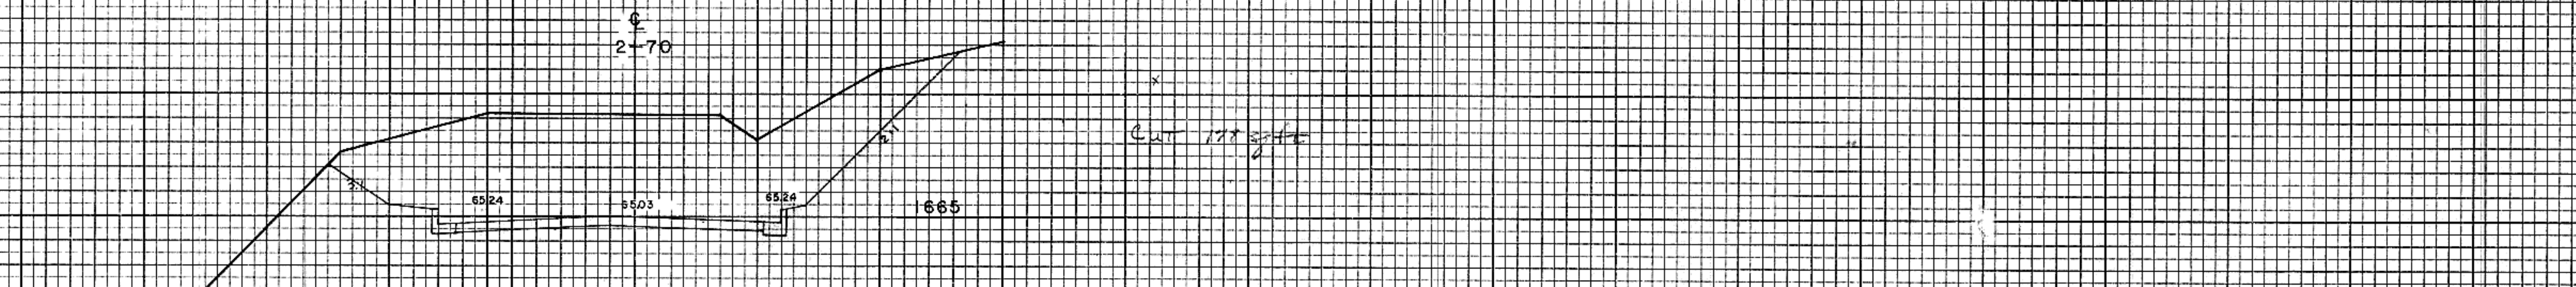
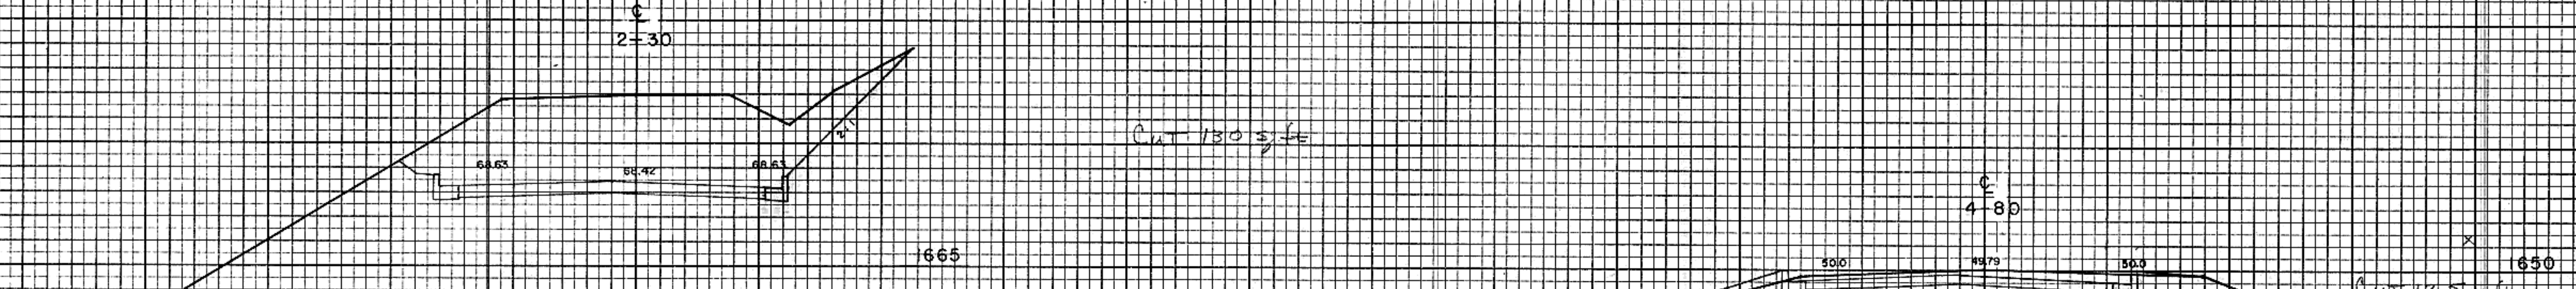
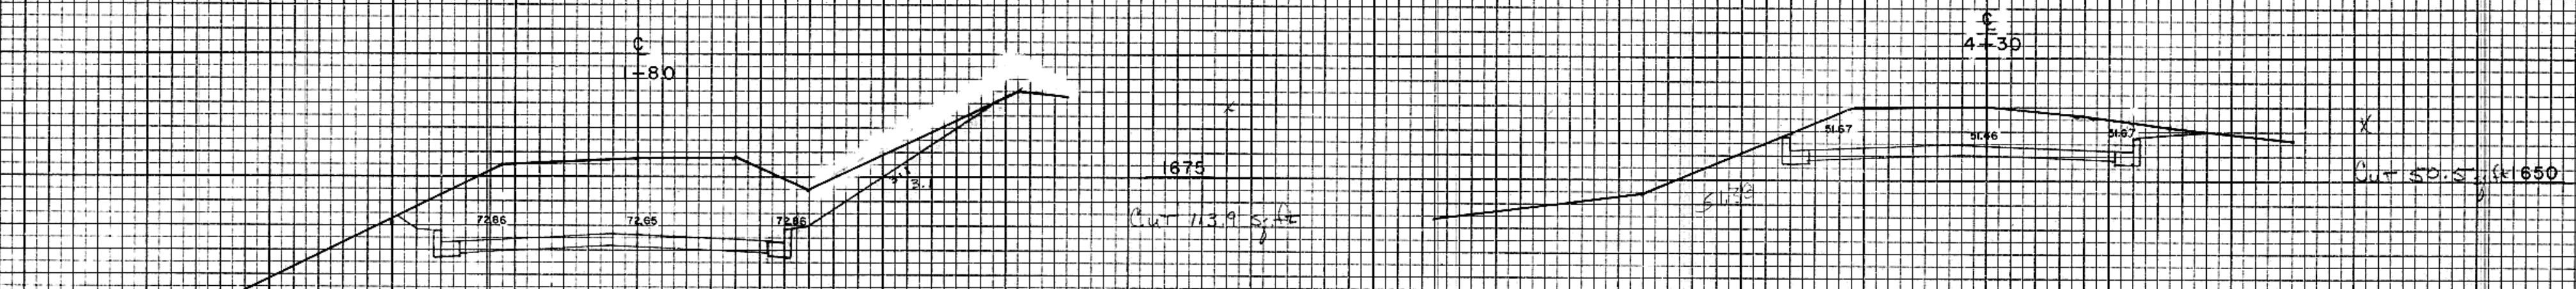
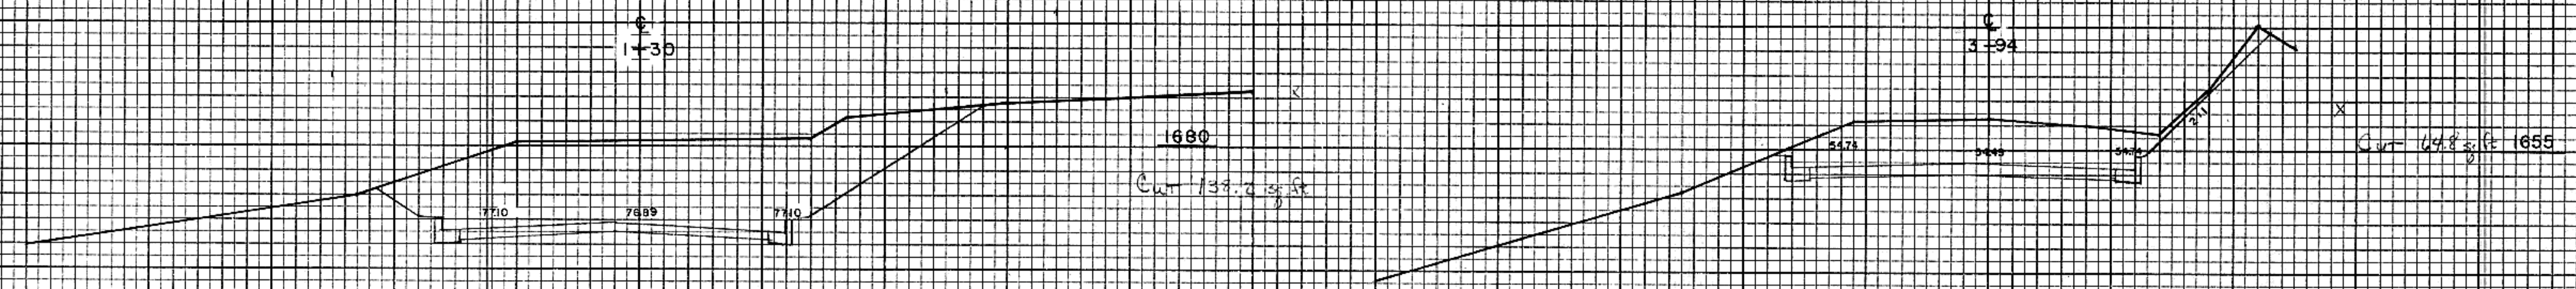


FINAL SURVEY	DATE
NOTE BOOK NO.	BY
SURVEYED	DATE
AREAS CHECKED	BY
AREAS CHECKED	DATE

ORIGINAL SURVEY	DATE
NOTE BOOK NO.	BY
SURVEYED	DATE
AREAS CHECKED	BY
AREAS CHECKED	DATE

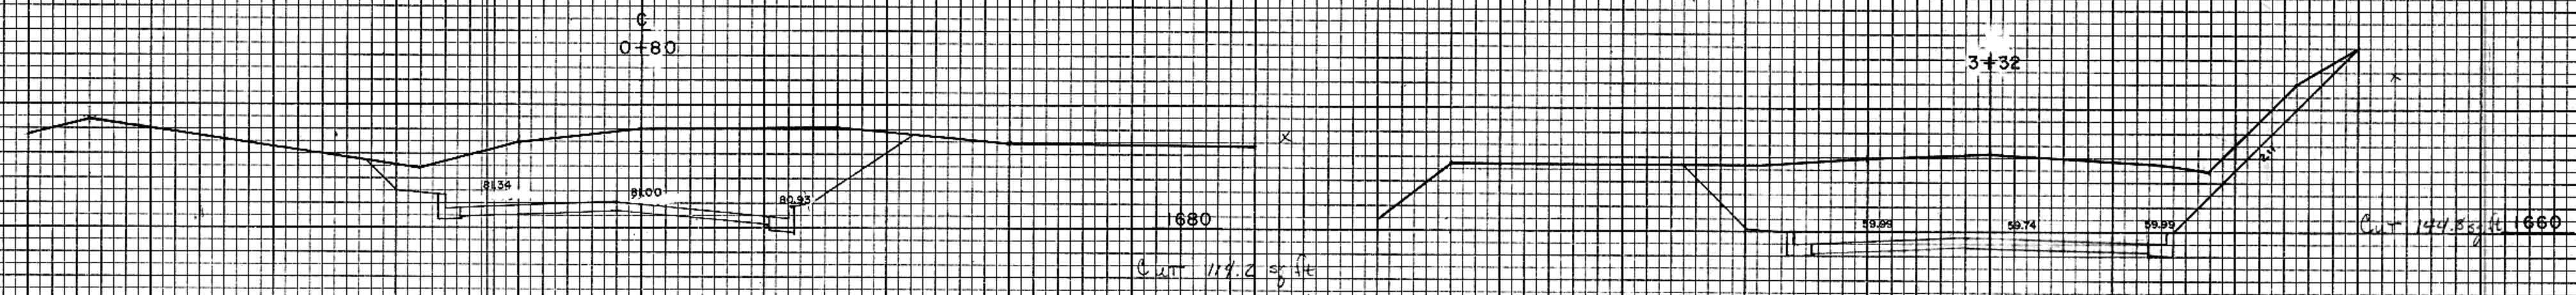

SCALE:
HORIZ. 1" = 10'
VERT. 1" = 5'