

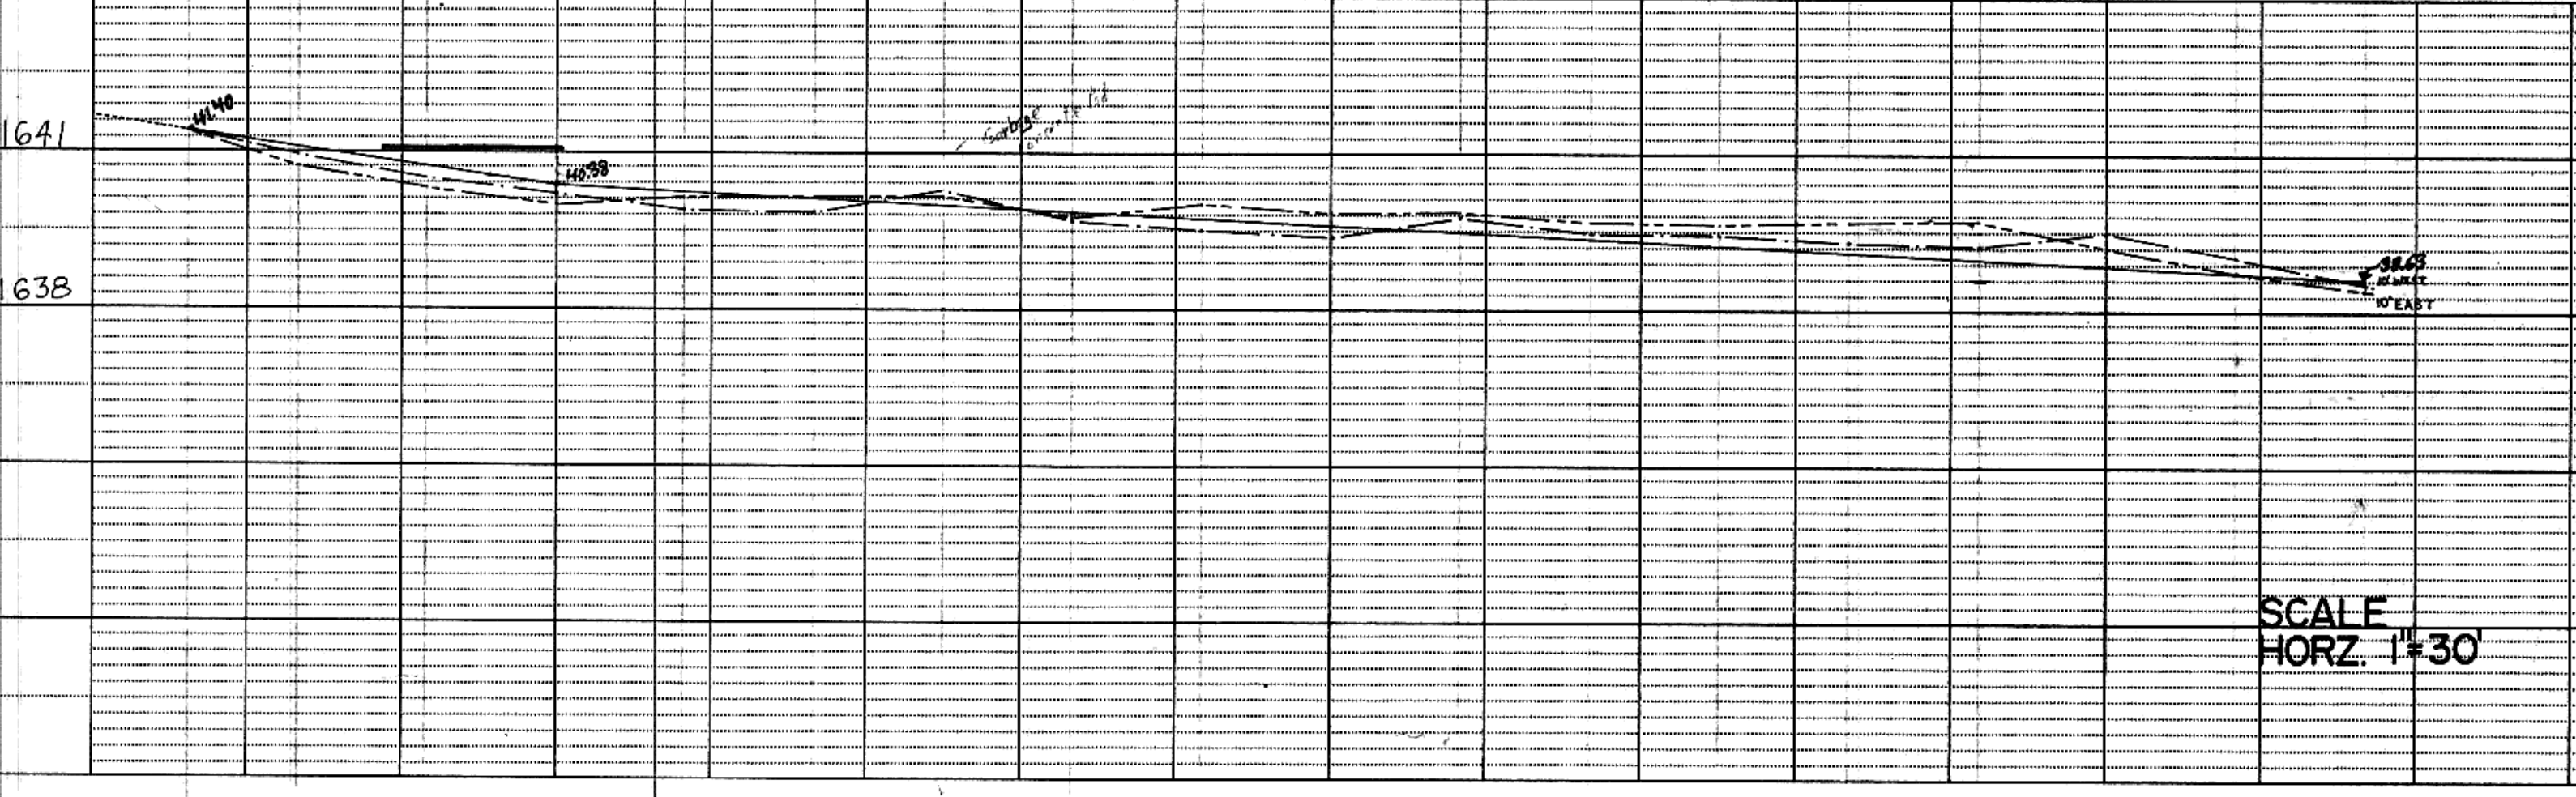


PLAN
 SURVEYED, GRADES CHECKED, ALIGNMENT CHECKED, RT. OF WAY CHECKED.
 NOTE BOOK NO. _____
 DATE _____

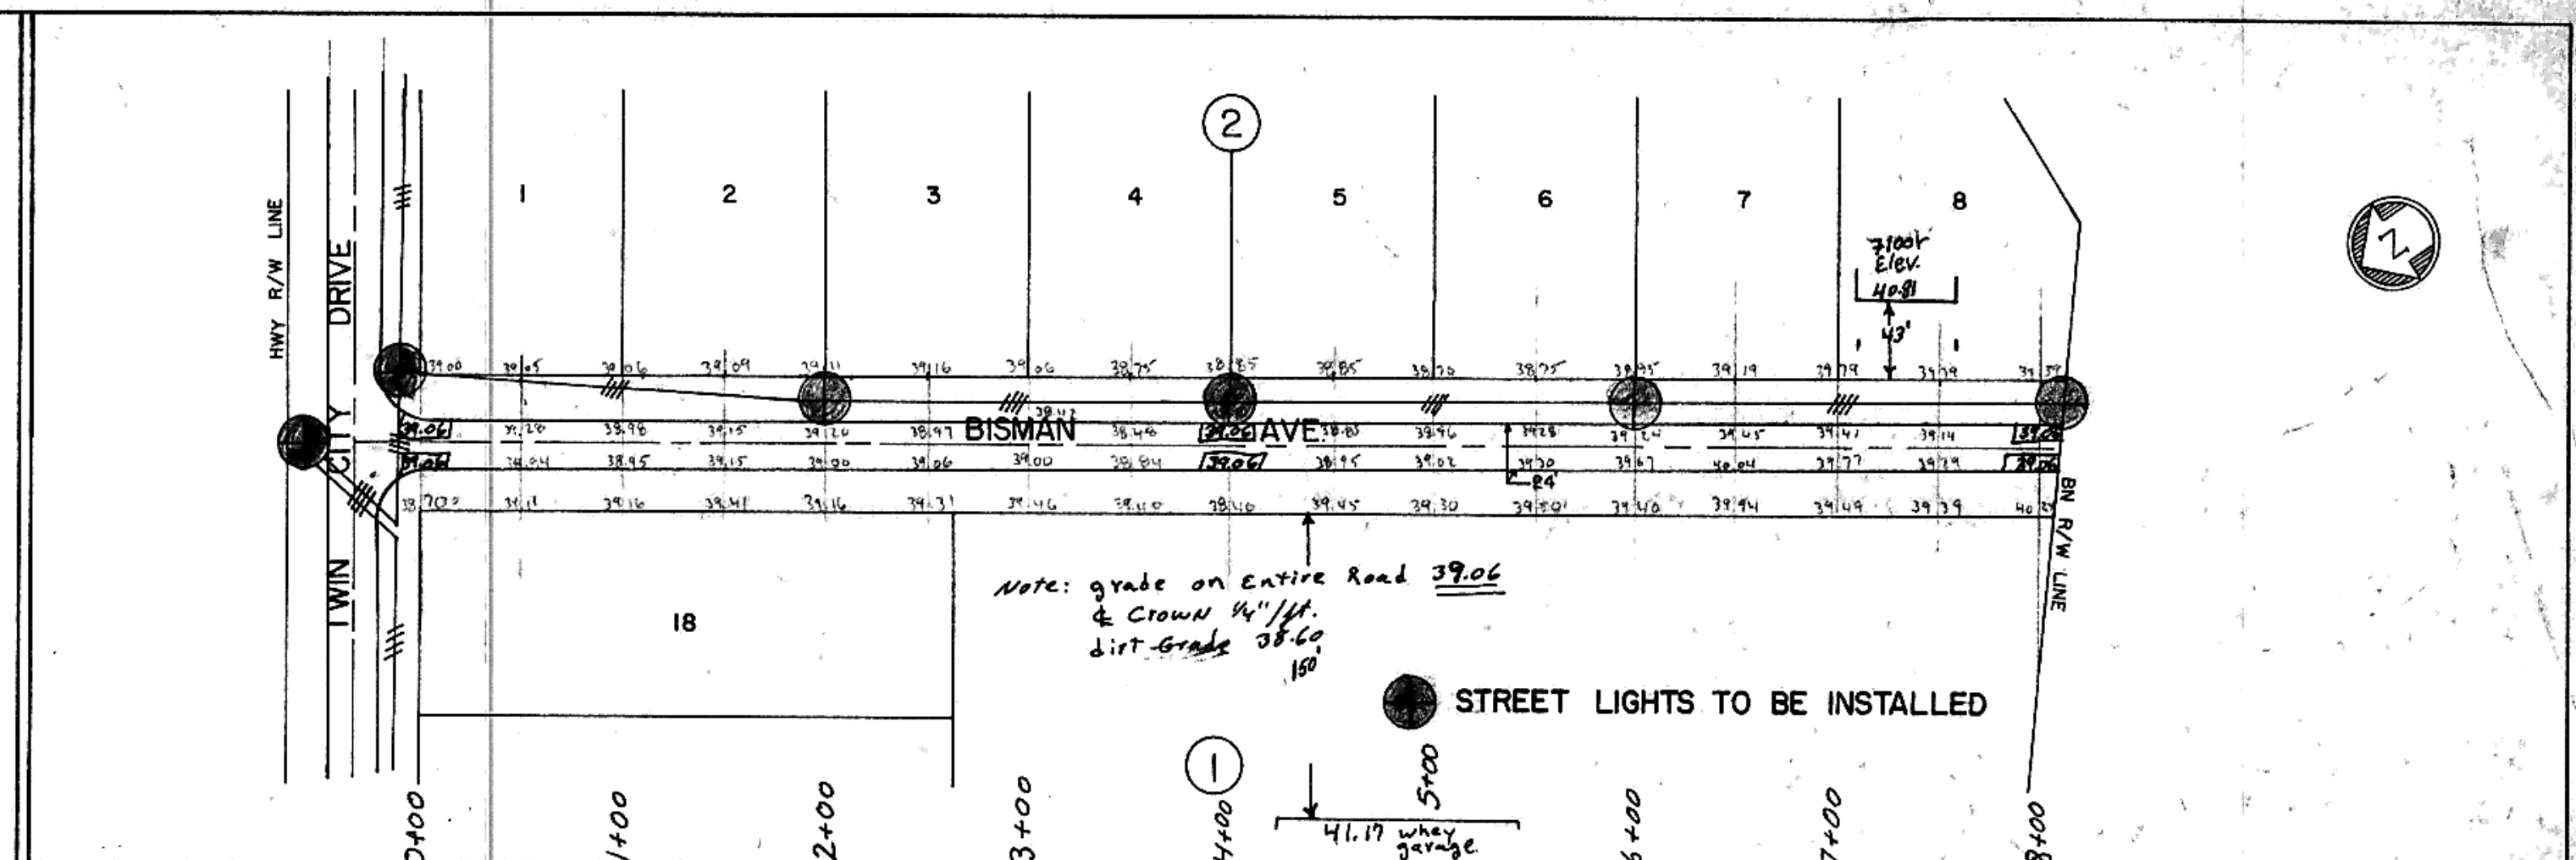

PROFILE
 SURVEYED, GRADES CHECKED, B.M. NOTED, STRUCTURE INDICATIONS CHECKED.
 NOTE BOOK NO. _____
 DATE _____

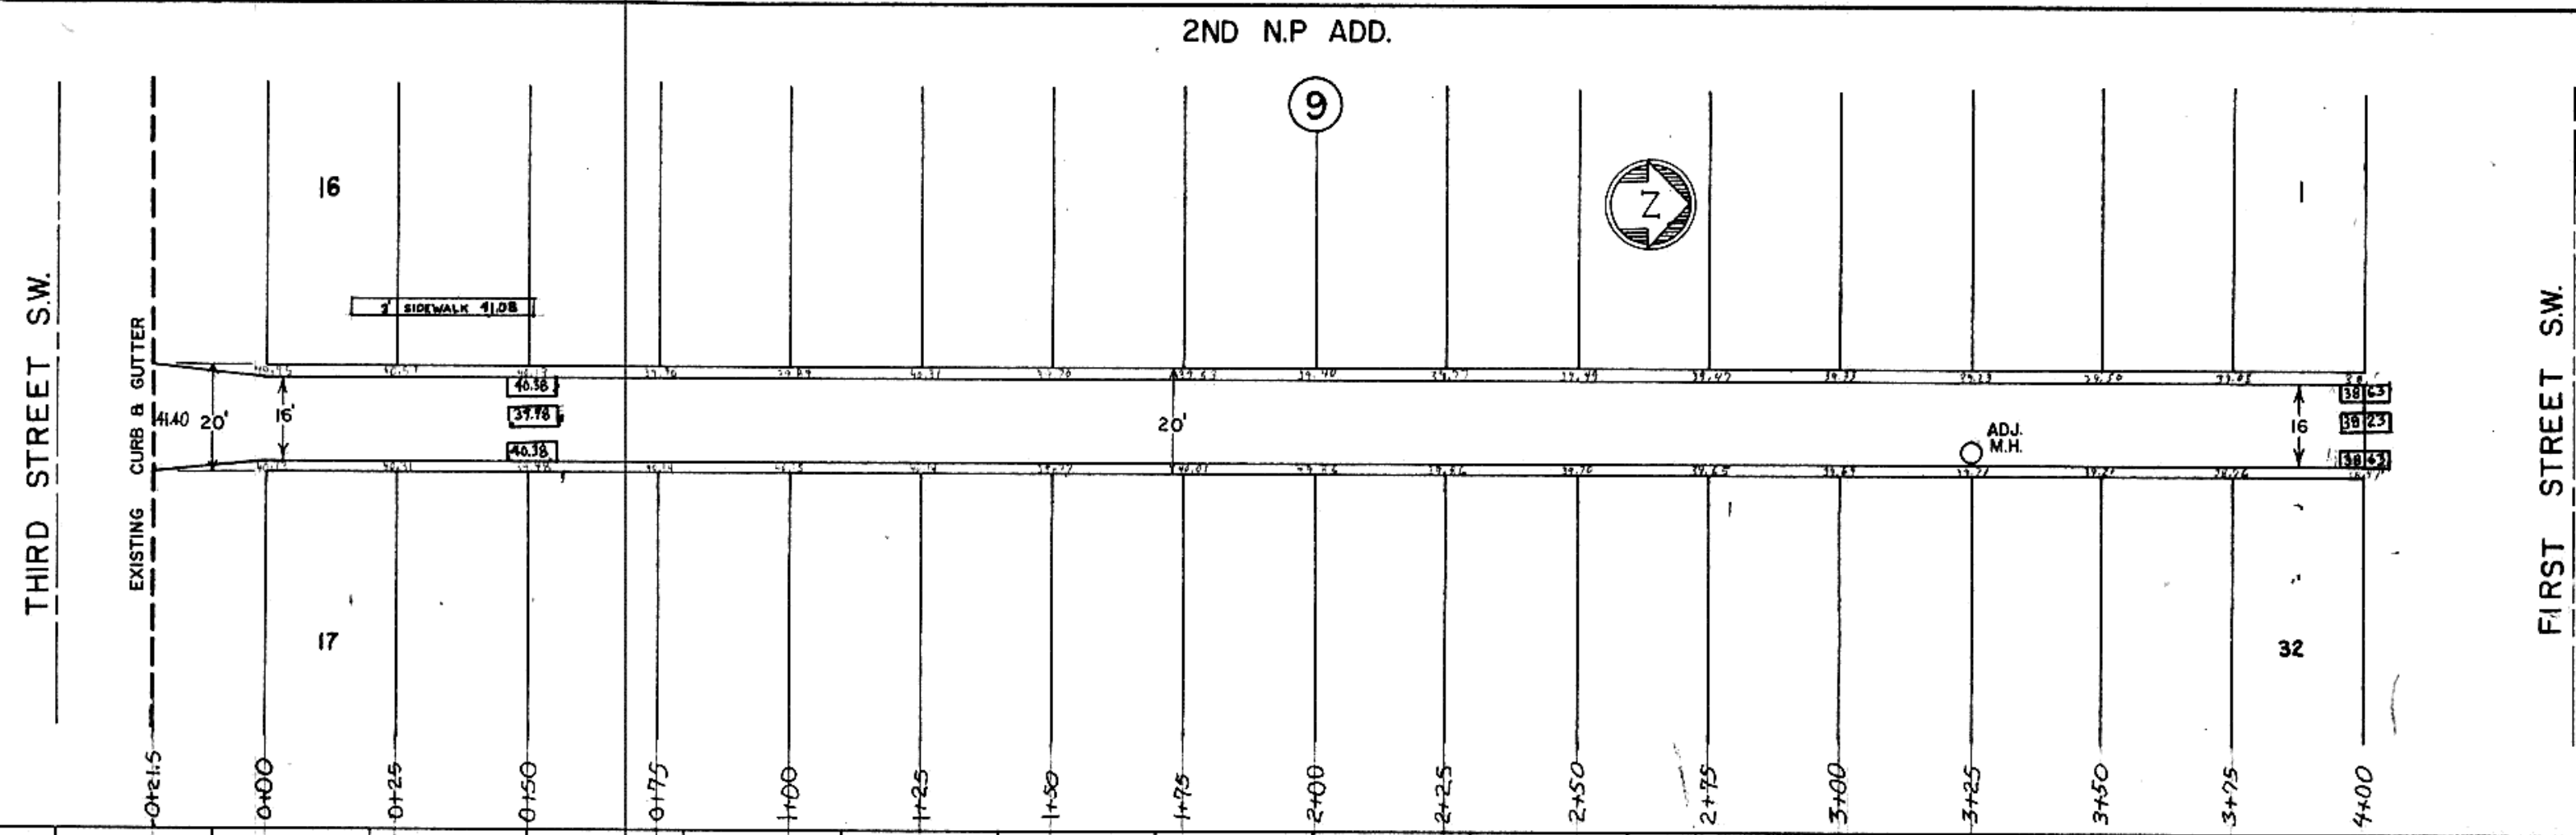