



PLAN
 SURVEYED
 AL DOCUMENT CHECKED
 RT. OF WAY CHECKED
 NOTE BOOK NO.

PROFILE
 SURVEYED
 GRADES CHECKED
 B.M. NOTED
 STRUCTURE NOTATIONS CHECKED
 NOTE BOOK NO.

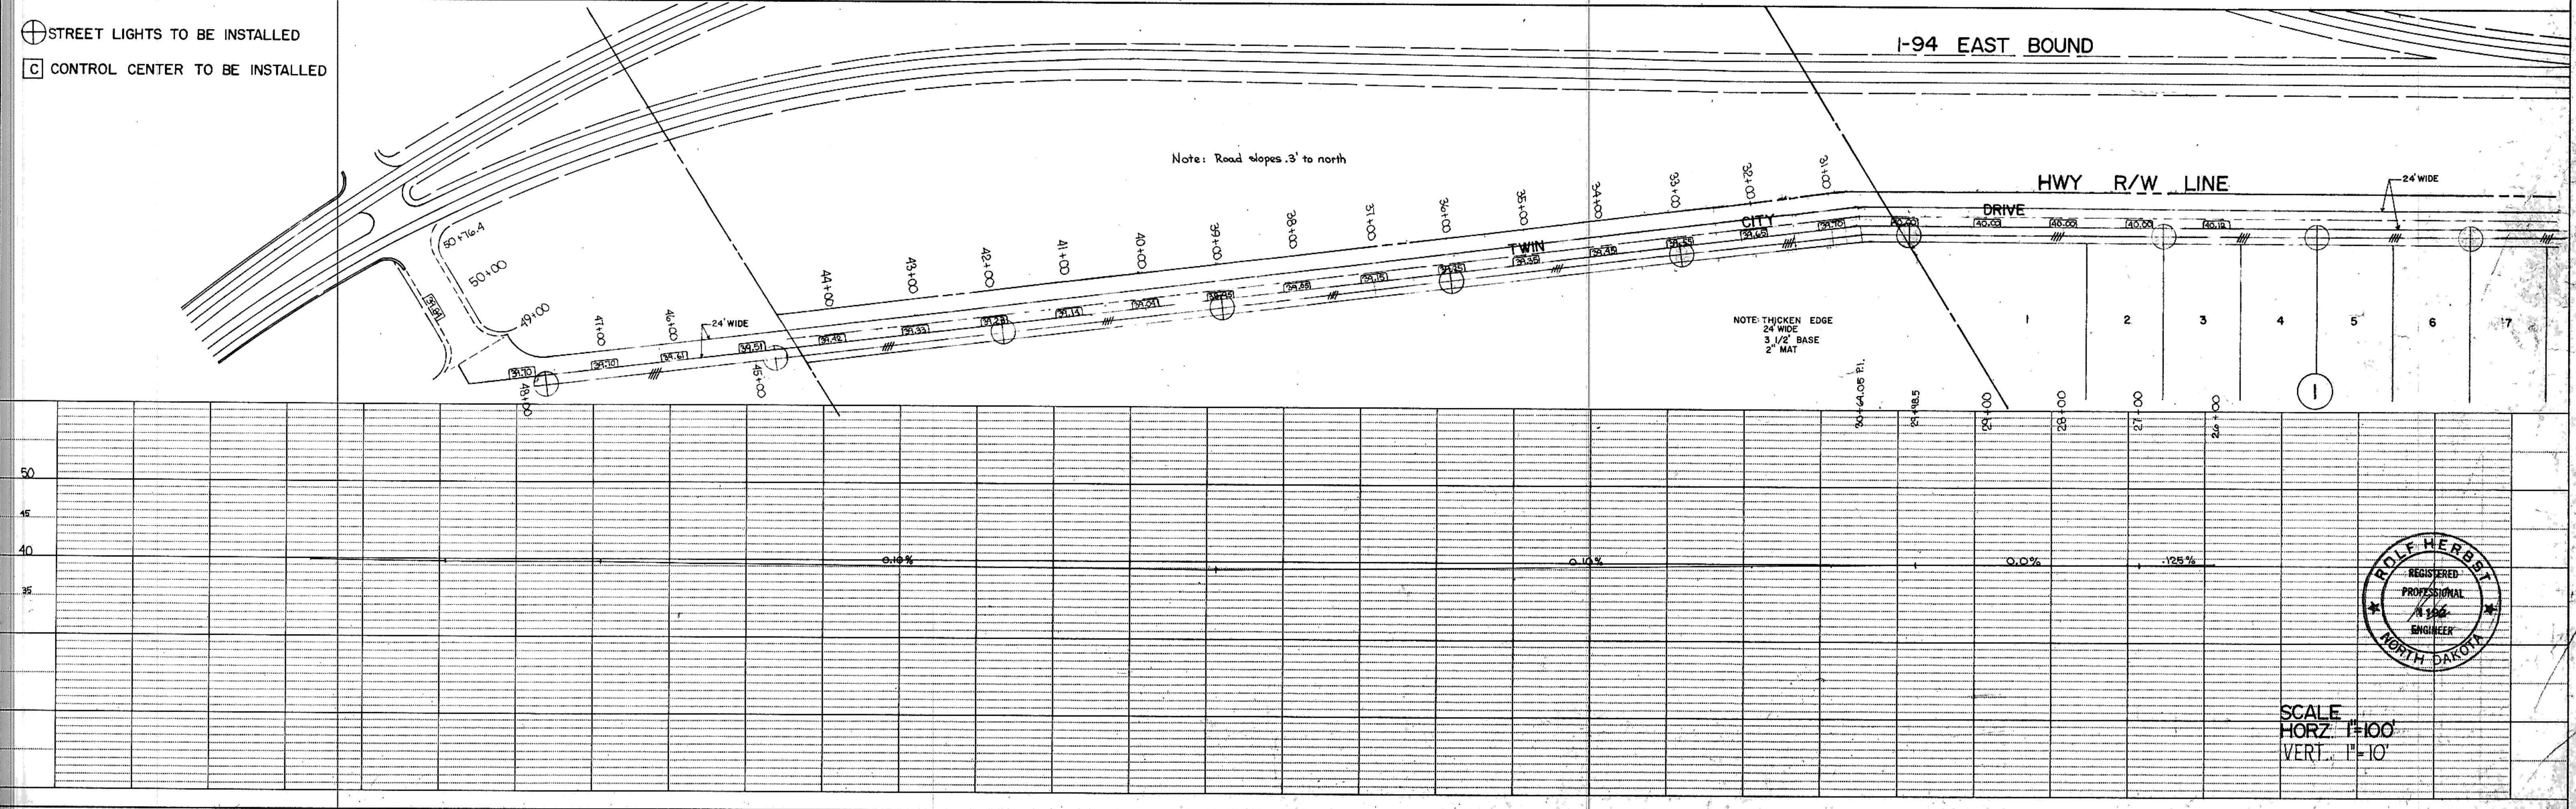

- ⊕ STREET LIGHTS TO BE INSTALLED
- ⓐ CONTROL CENTER TO BE INSTALLED

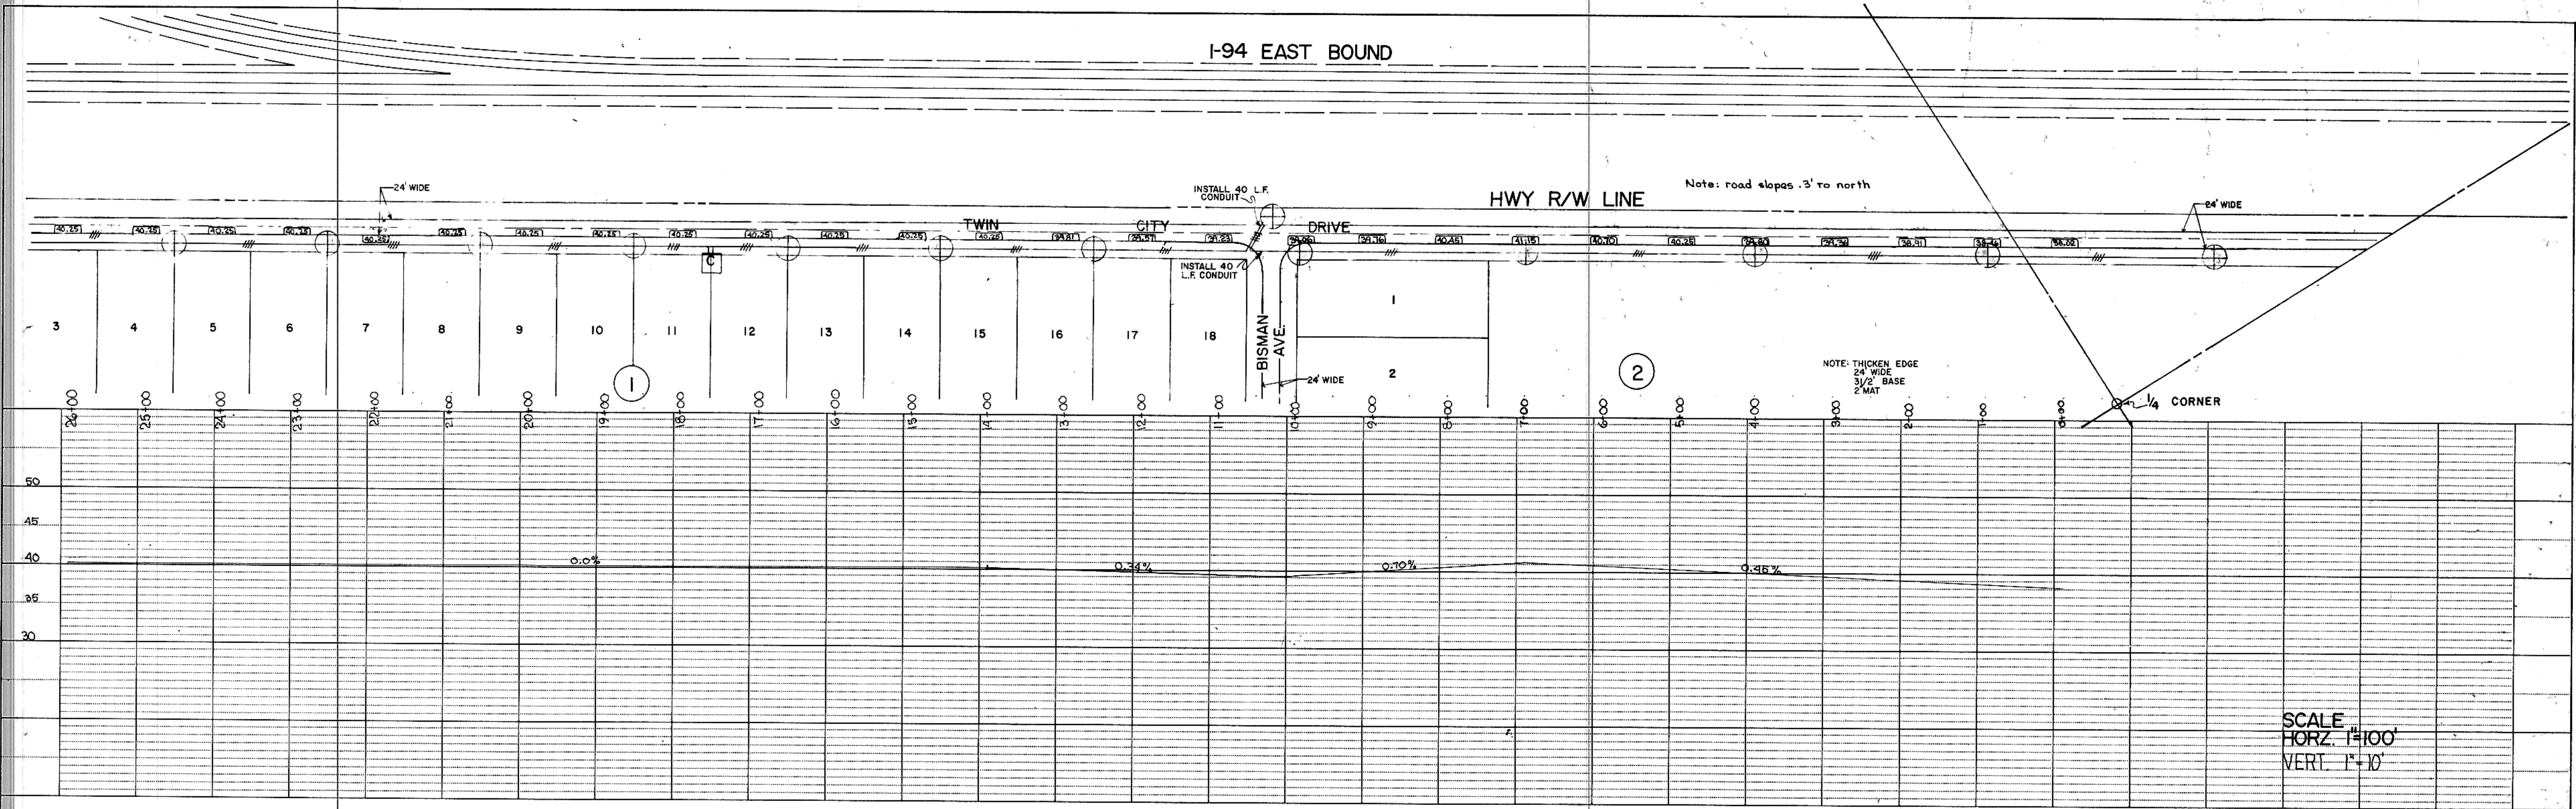