
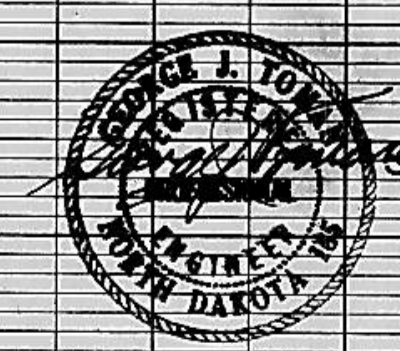


EAST CURB SHALL BE SHOWN IN WHITE WHEN NOT SHOWN

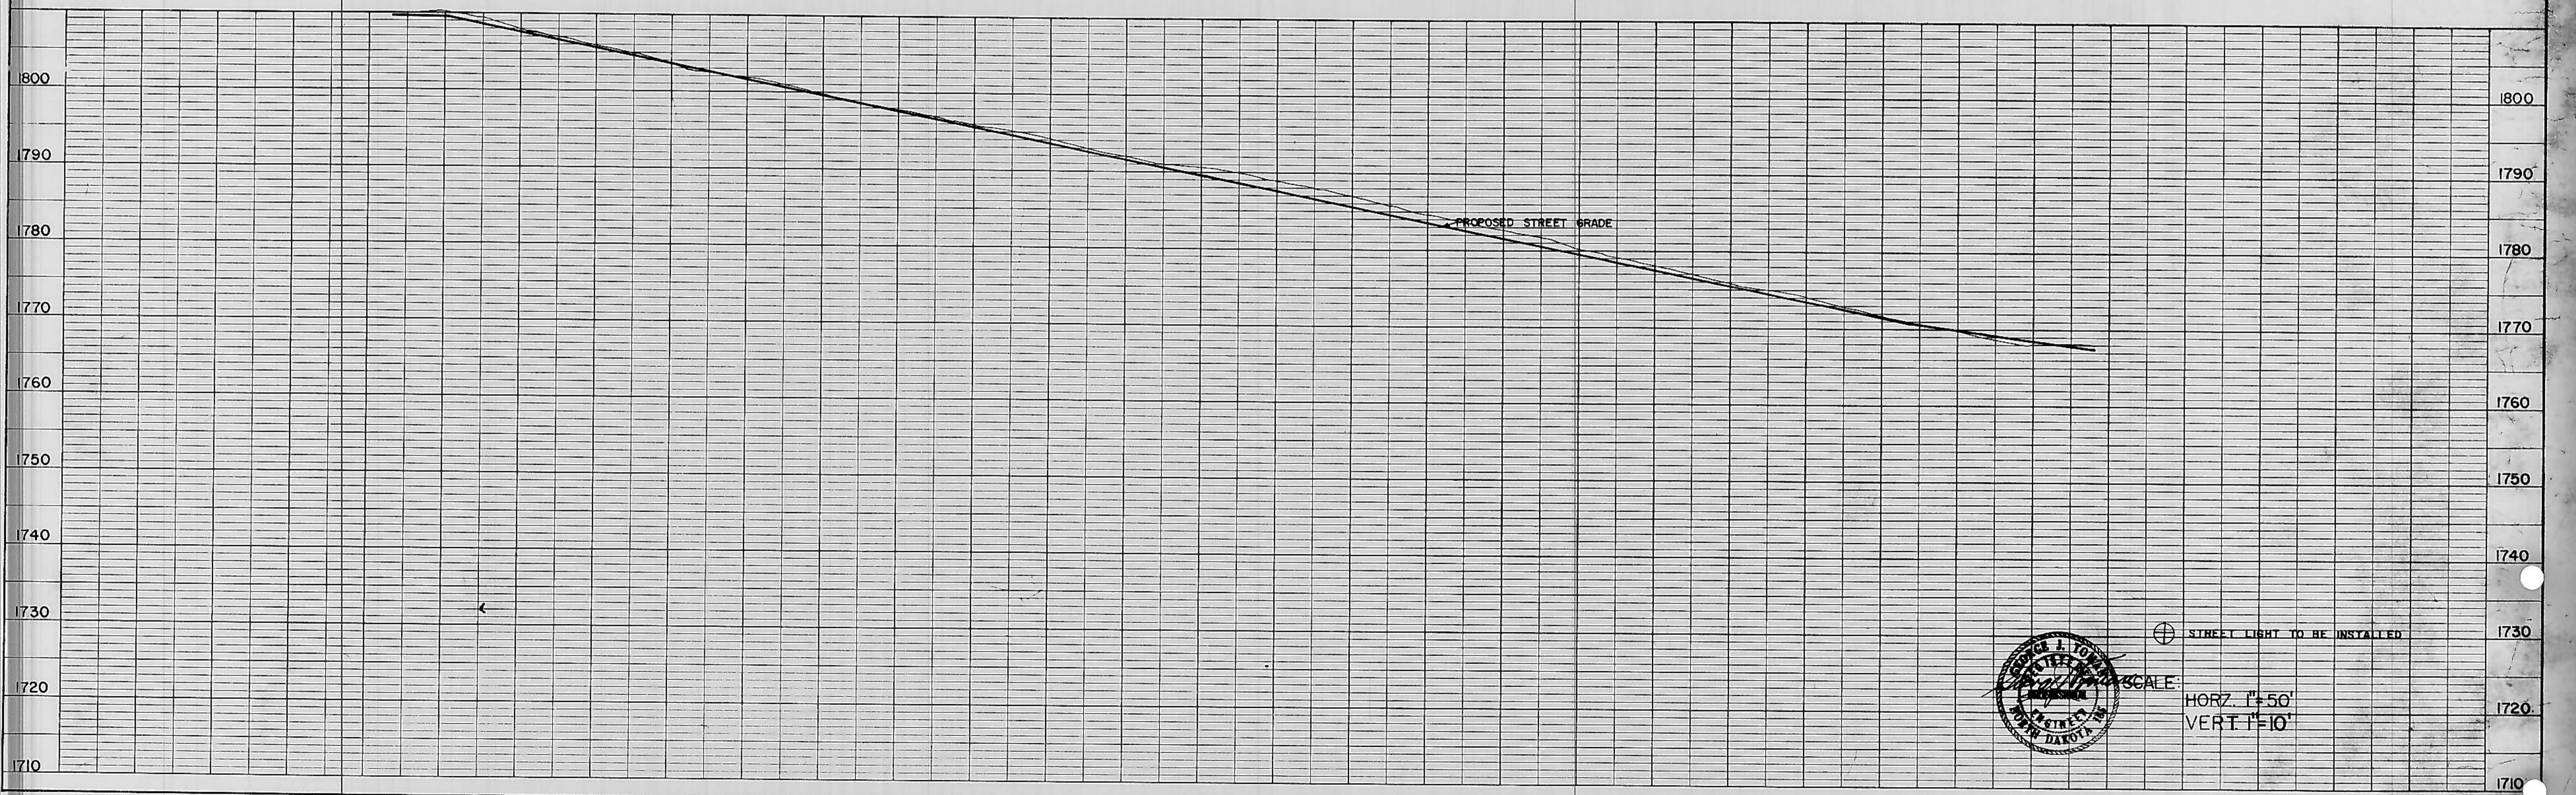

STREET LIGHT TO BE INSTALLED
 SCALE:
 HORIZ 1"=50'
 VERT 1"=10'