



PLAN SURVEYED BY DATE
 PLOTTED BY
 GRADINGS CHECKED
 NOTE BOOK NO.
 RT. OF WAY CHECKED

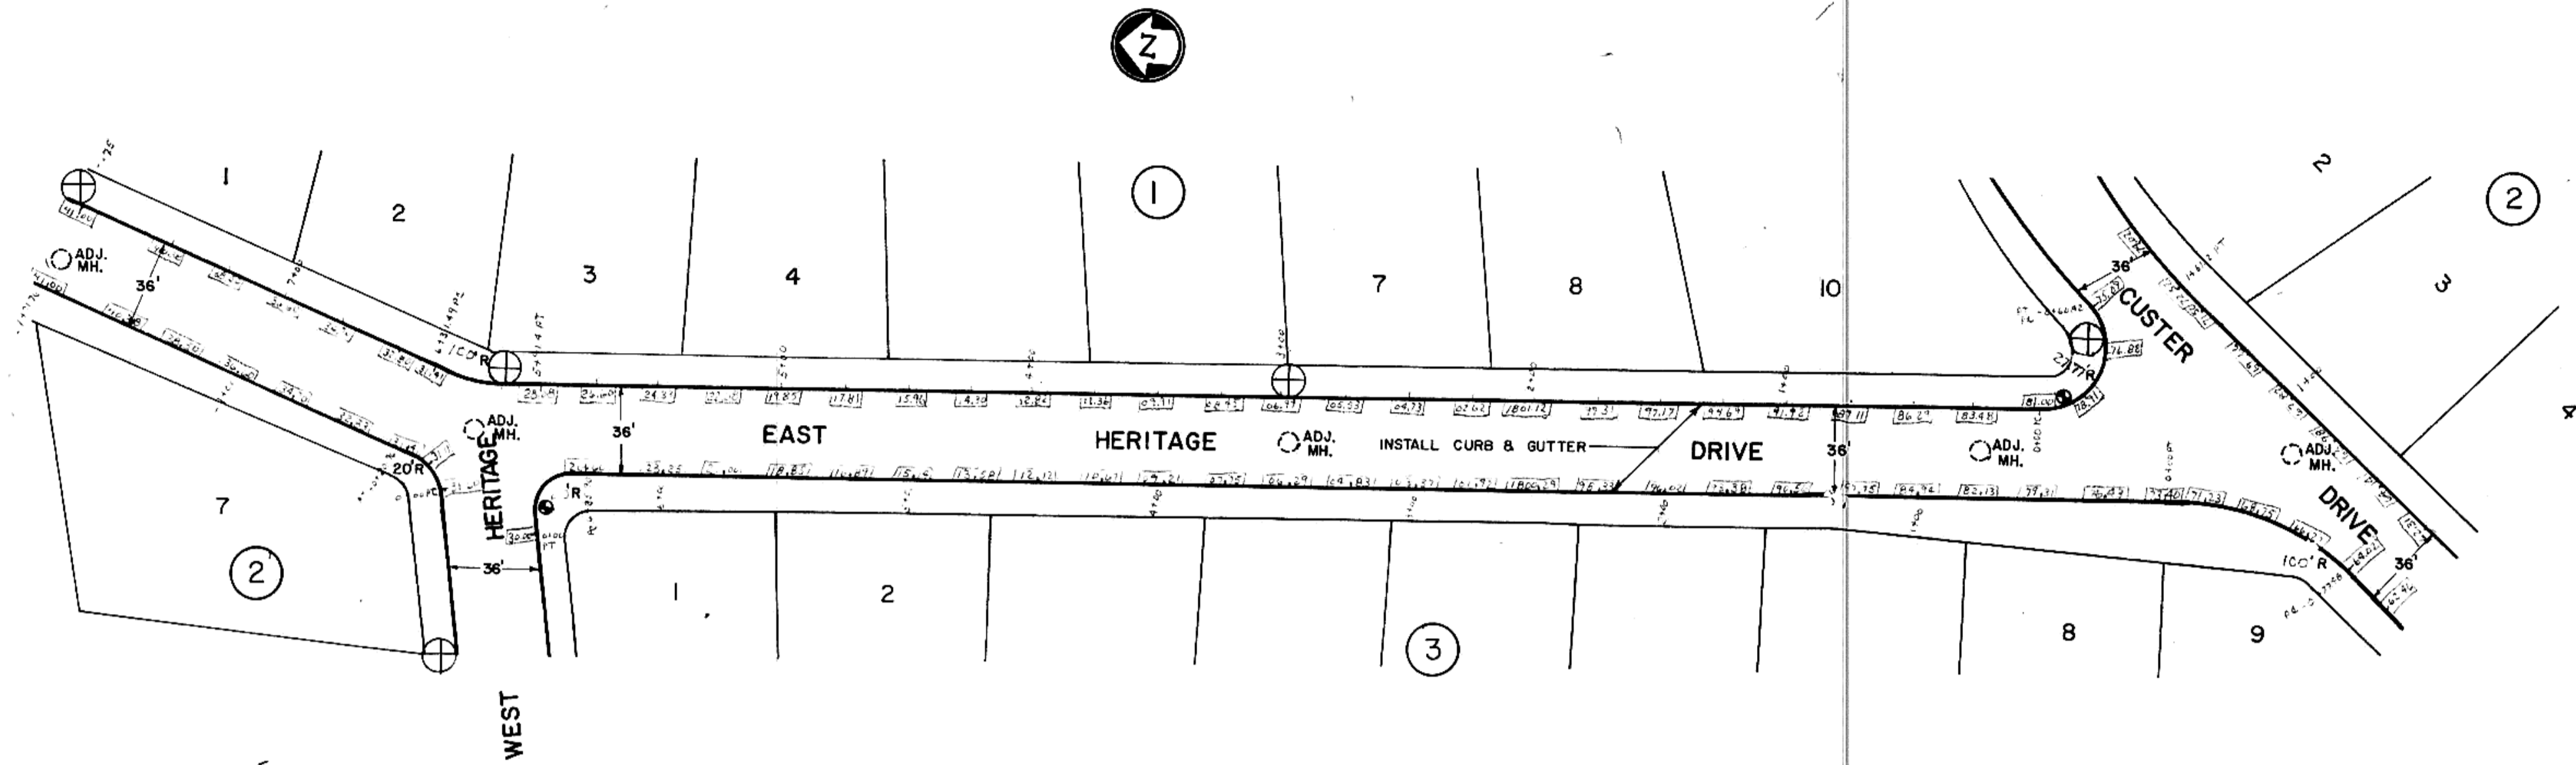

PROFILE SURVEYED BY DATE
 PLOTTED BY
 GRADINGS CHECKED
 NOTE BOOK NO.
 STRUCTURE NOTATIONS

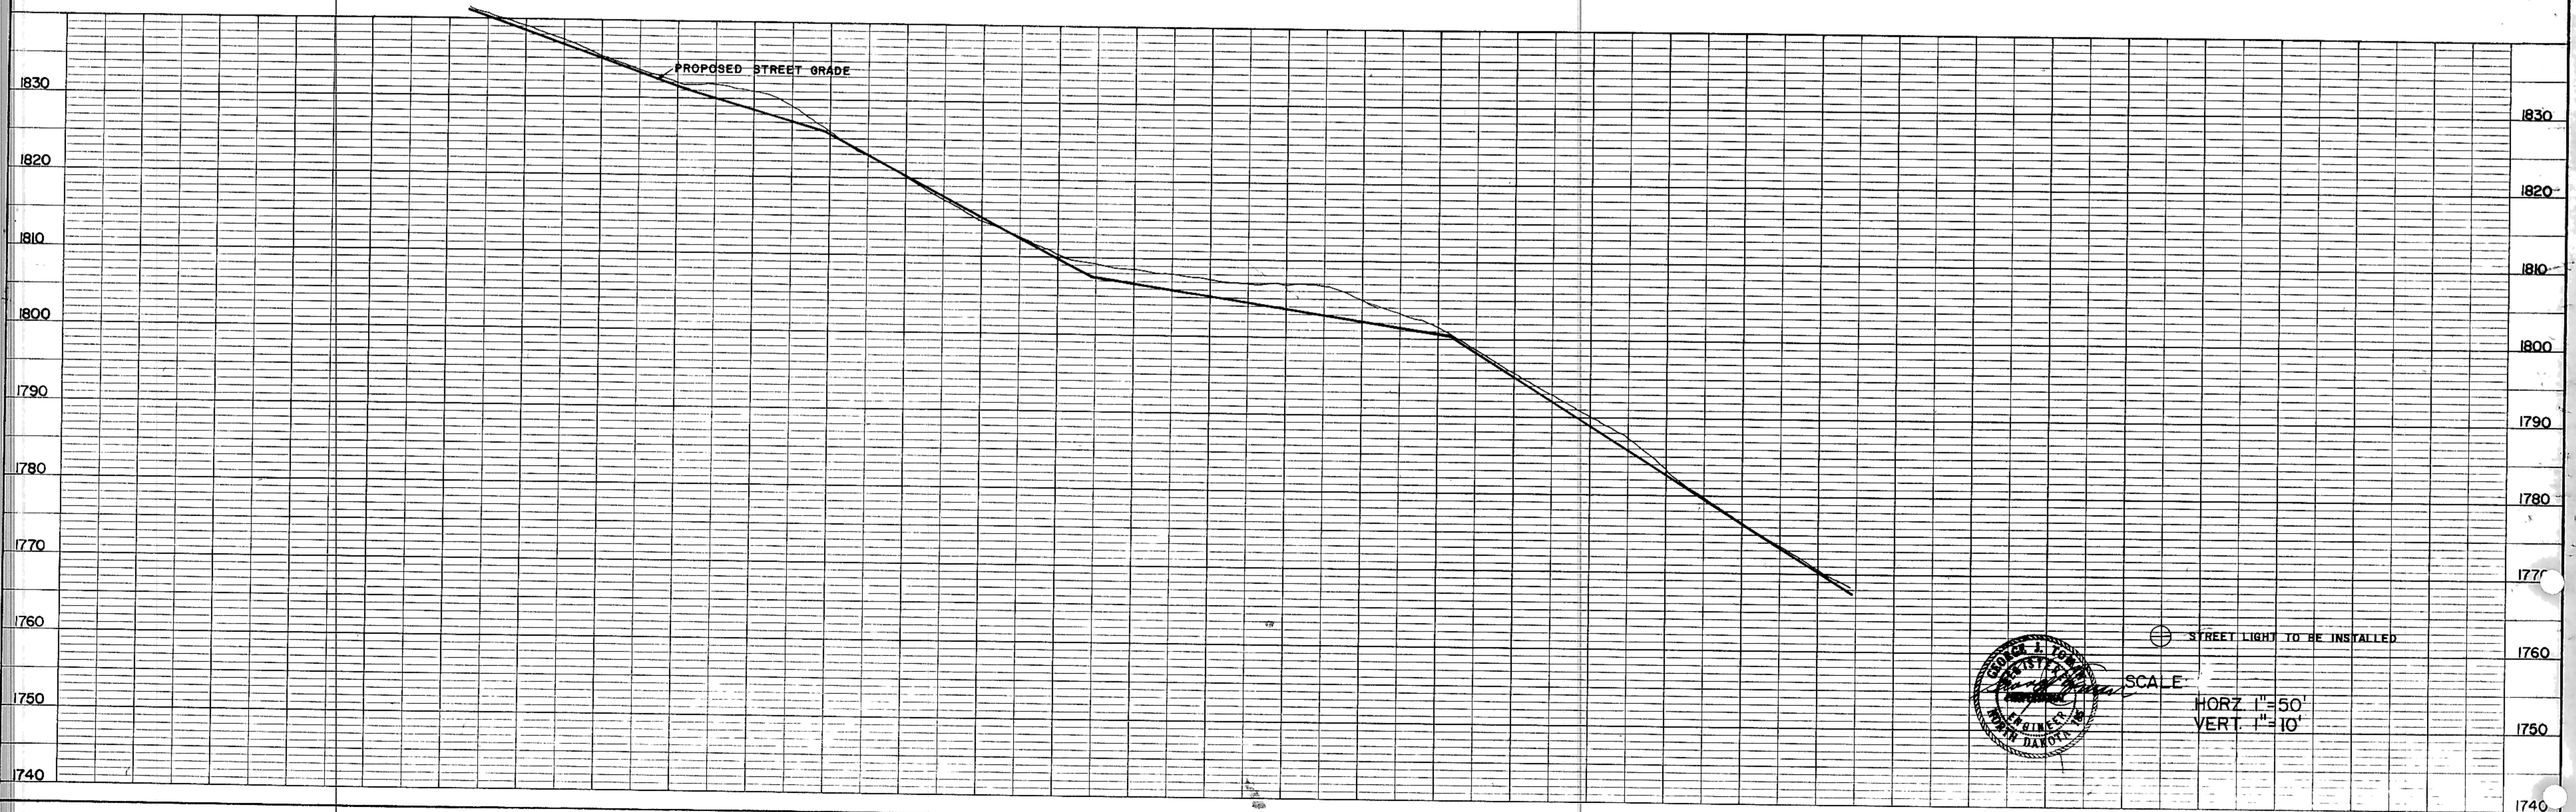

STREET LIGHT TO BE INSTALLED
 SCALE
 HORZ. 1"=50'
 VERT. 1"=10'