



INDEPENDENCE

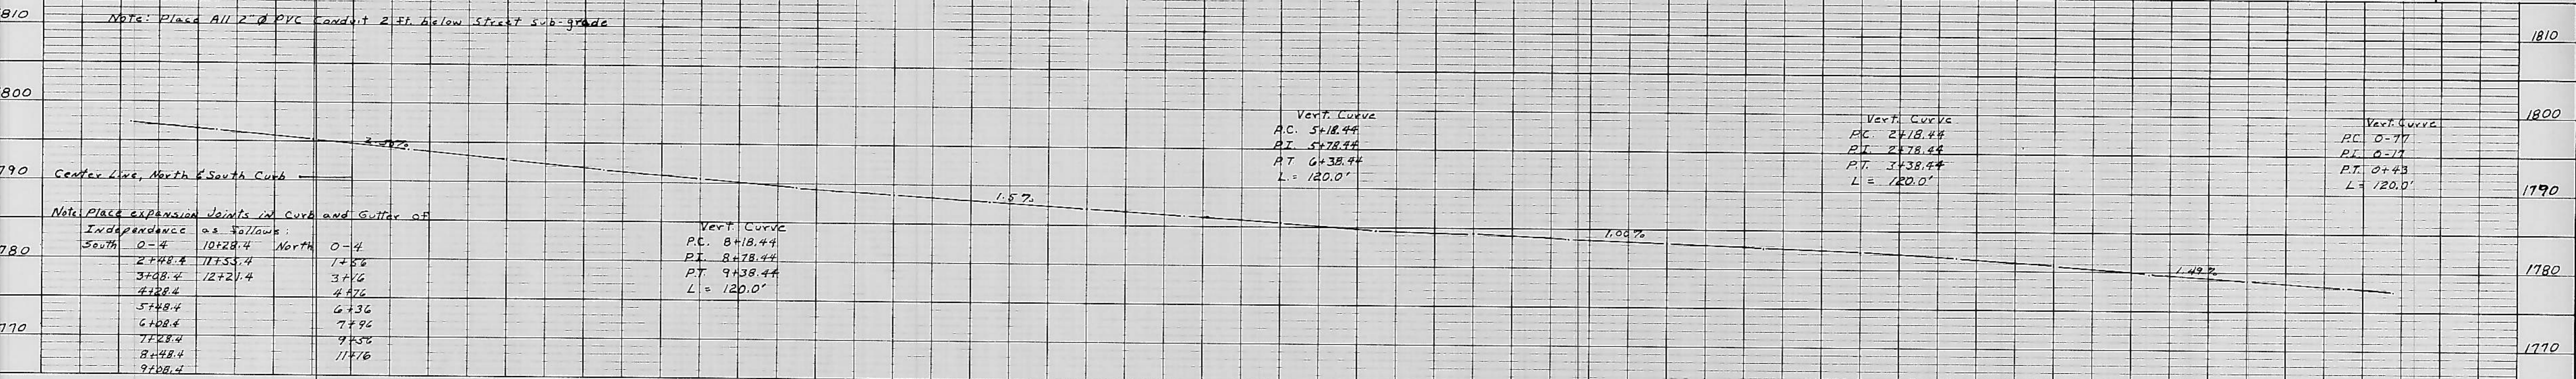

FREEDOM ROAD

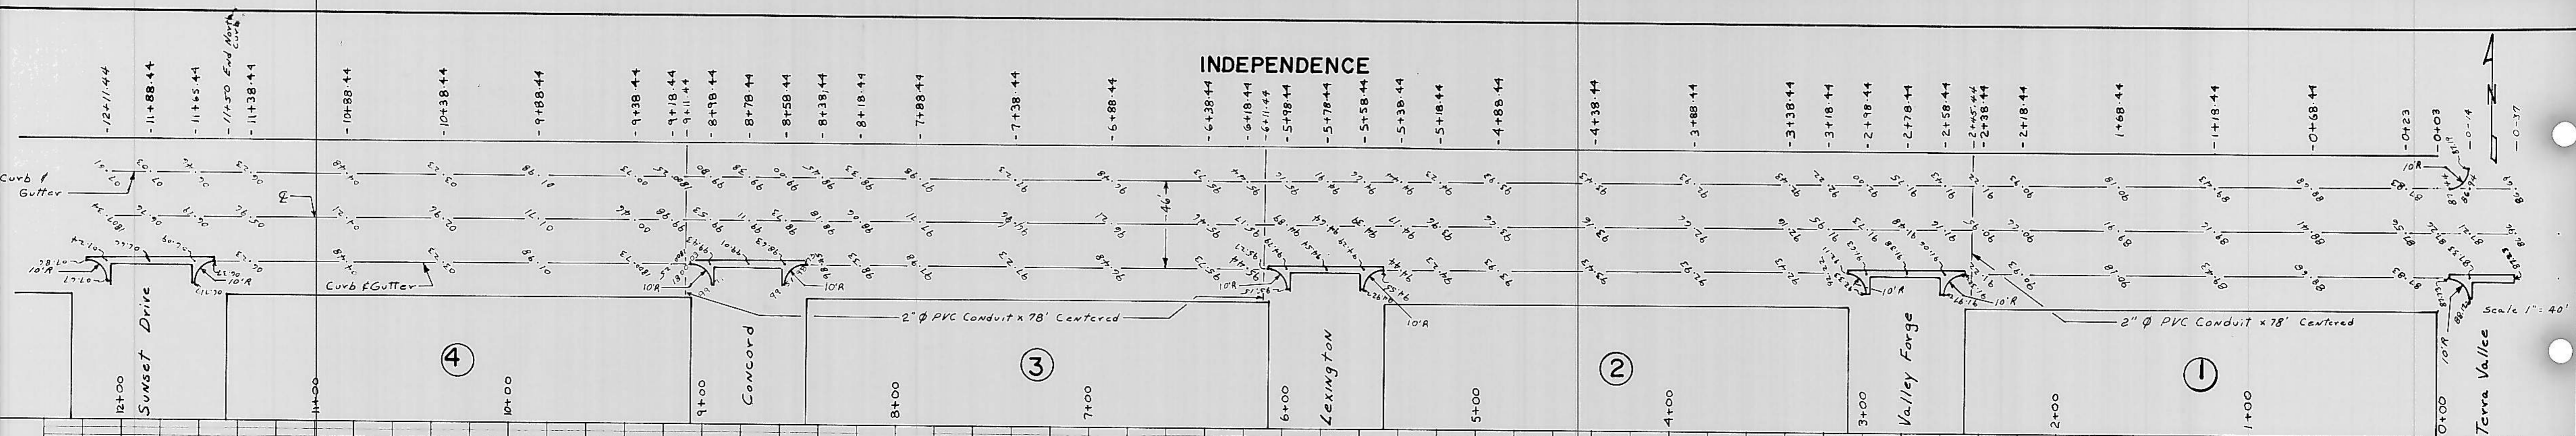