



SOUTHSIDE ADDITION

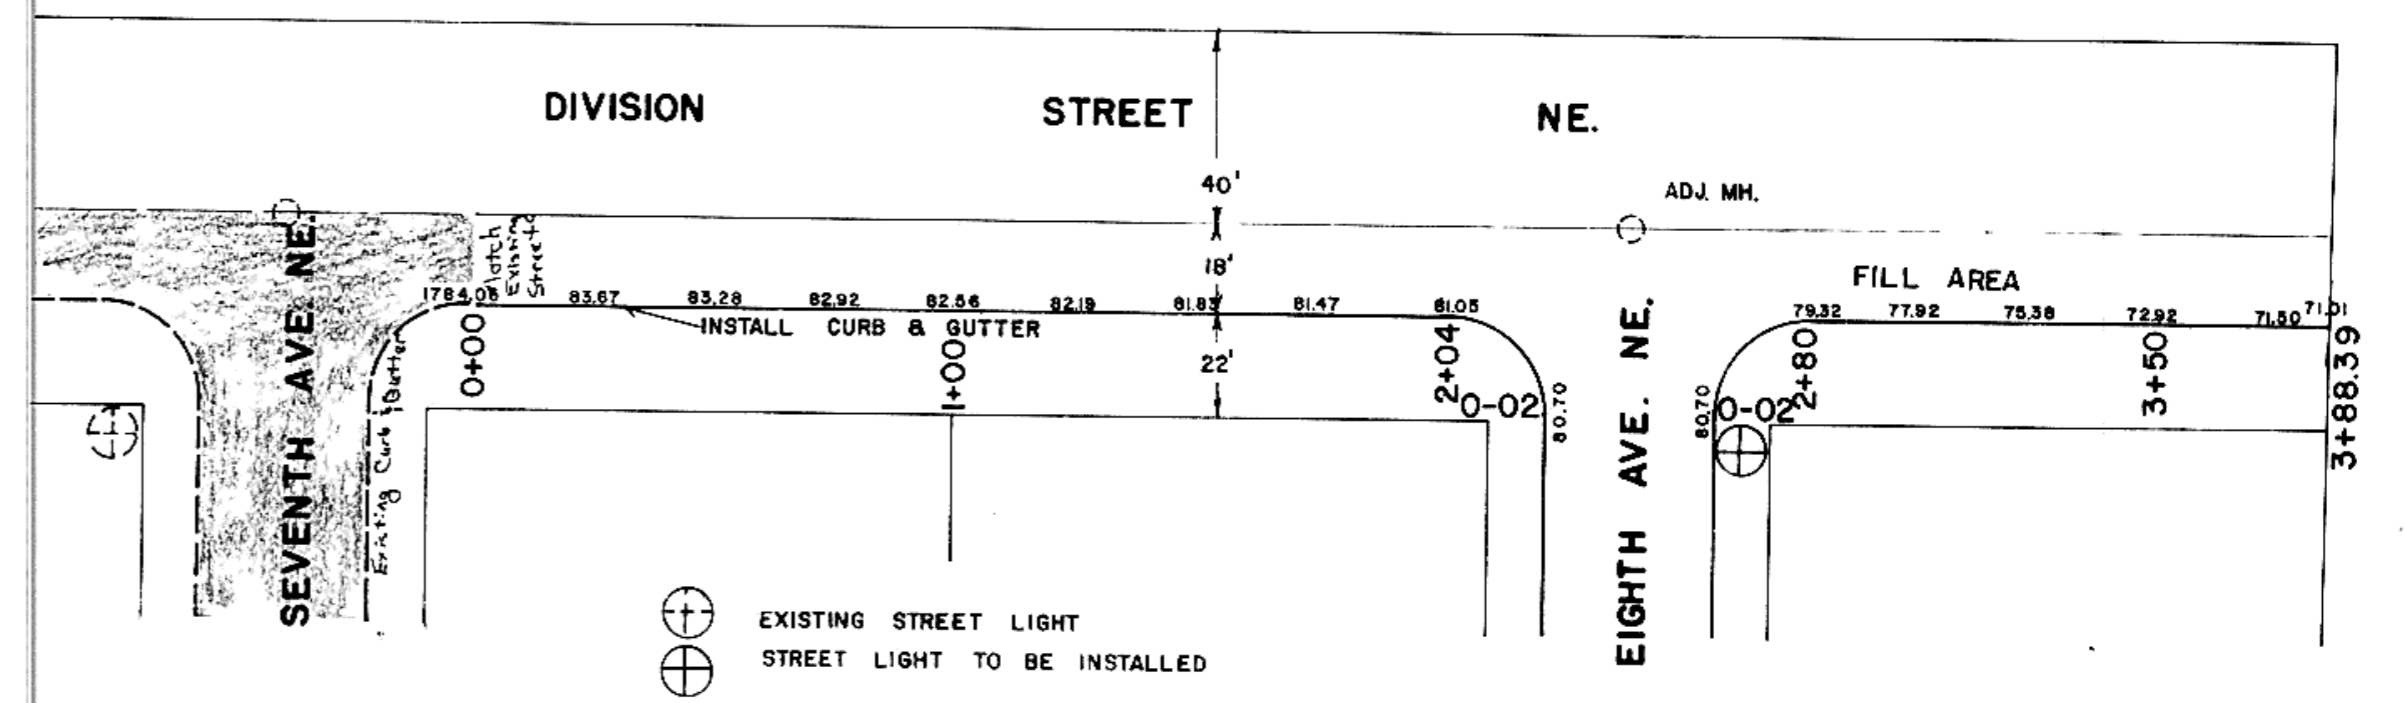

EXISTING STREET LIGHT
STREET LIGHT TO BE INSTALLED

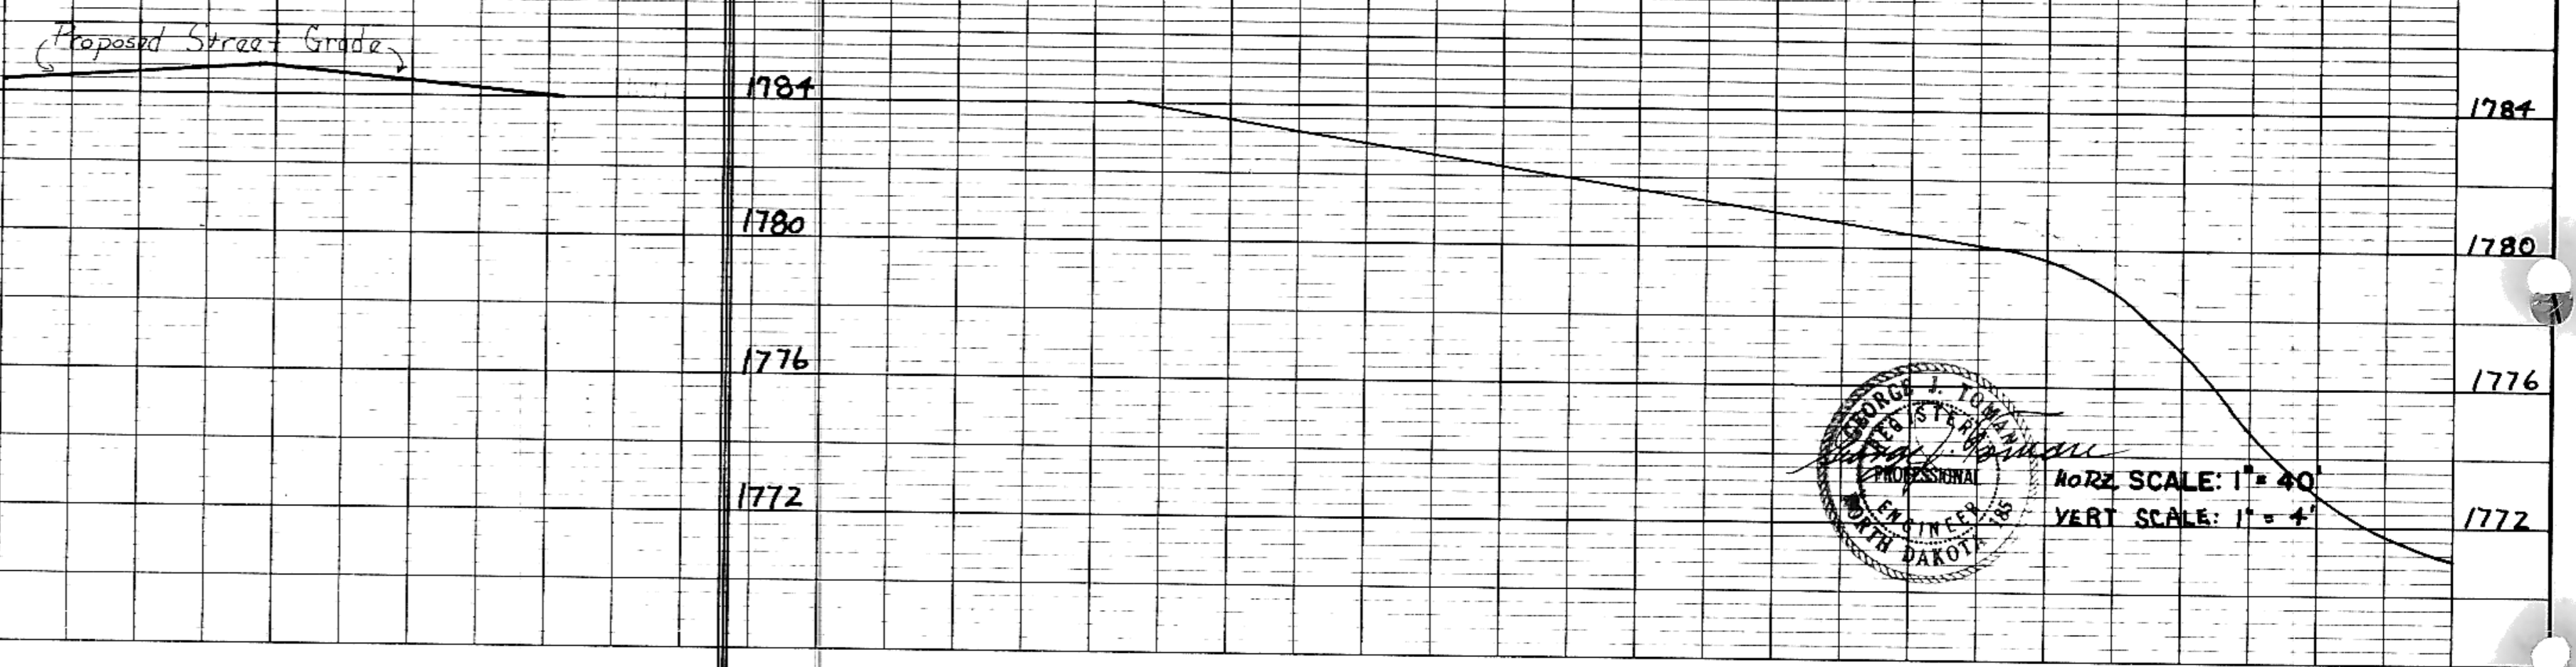

SCALE HORZ 1" = 40'
VERT SCALE 1" = 4'