

BEGIN QUANTITIES
STA 0+39

HORIZONTAL SCALE: 1" = 50'
VERTICAL SCALE: 1" = 5'
DATE: JULY, 1977


END QUANTITIES
STA 12+05

* The Revised Asphalt Quantities Were Computed With
The Following Asphalt Mixture:
Base Course 1448 Lb./Cu.Ft. With 7% Asphalt Cement
Surface Course 1446 Lb./Cu.Ft. With 7 1/2% Asphalt Cement
Asphalt Cement @ 60°F 8.54 Lb./Gal.
Tack Coat 0.1 Gal./Sq.Yd.
Asphalt Sealer:
Bituminous Material 0.36 Gal./Sq. Yd.
Cover Aggregate 30 Lb./Sq.Yd.
Blotter Sand 4 Lb./Sq.Yd.


- NOTES:
- Sewer and Water Improvements as shown on plans are existing as per date of street improvement plans. Existing Sewer and Water as per "Consolidated Water and Sewer Improvement District No. 24".
 - All curb and gutter radii are 15 feet at face of curb unless otherwise stated.
 - Proposed grades are to top of curb unless otherwise stated.
 - City Engineer shall confirm location of variable curb and gutter for driveways prior to construction of said curb.
 - Embankment quantities shown include an assumed 25% shrinkage factor.

LEGEND

(---)	(EXISTING) CENTERLINE
(---)	50' LT.
(---)	50' RT.
(---)	(EXISTING) WATERMAINS
(---)	HYDRANTS
(---)	GATE VALVES
(---)	TEES
(---)	PLUGS
(---)	SANITARY SEWER
(---)	SAN. SEWER MH

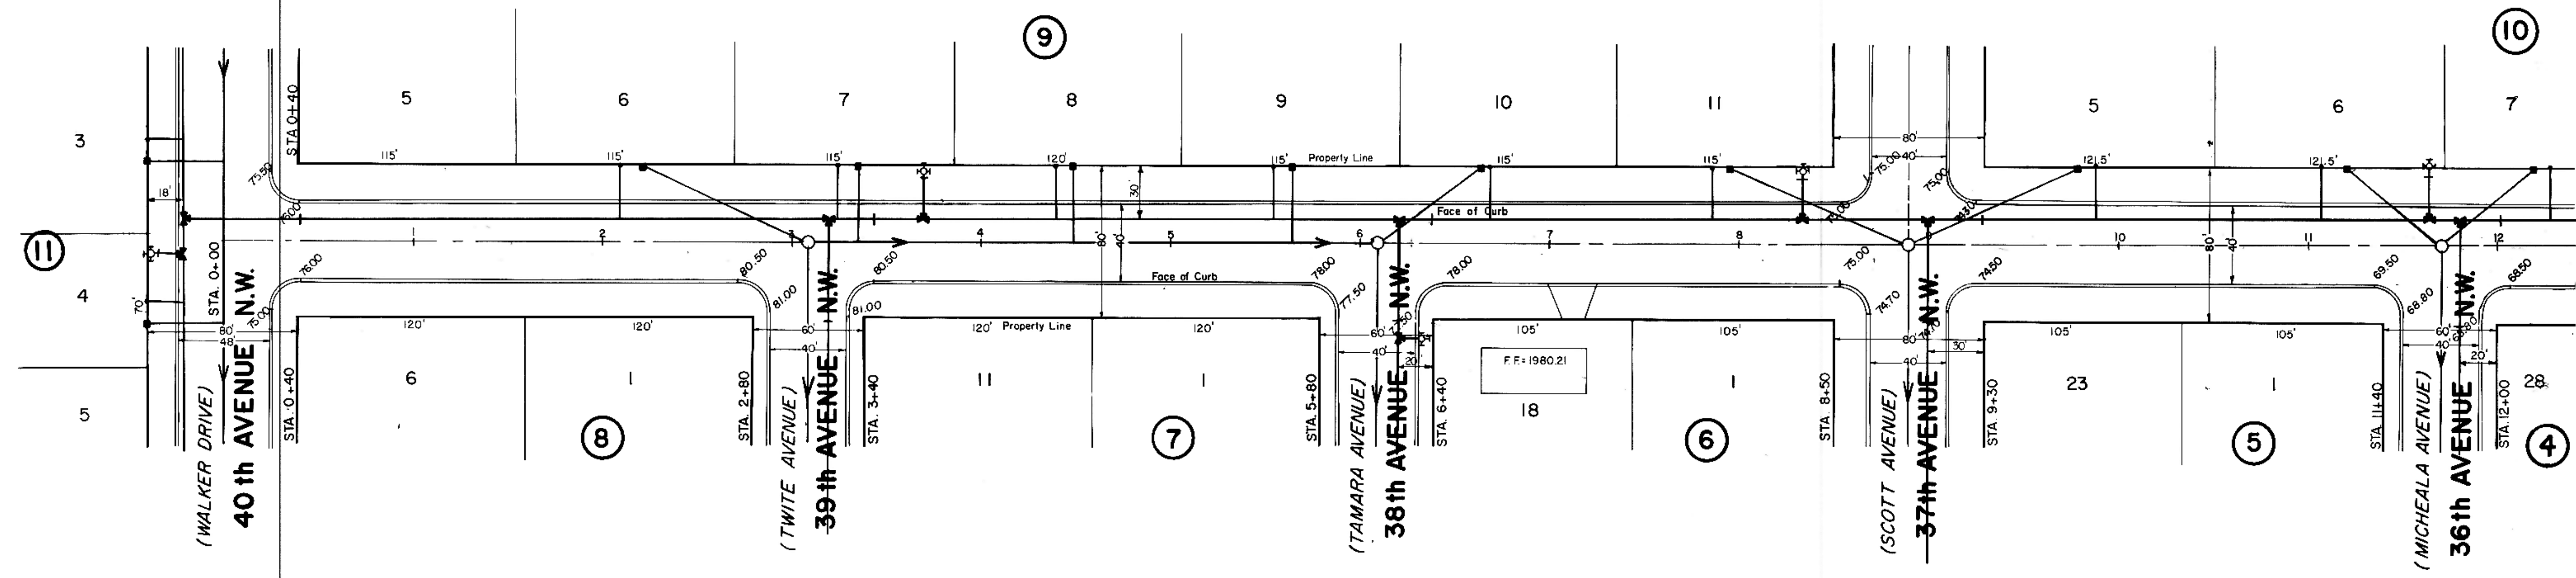

(CAMERON STREET) 42nd STREET N.W.

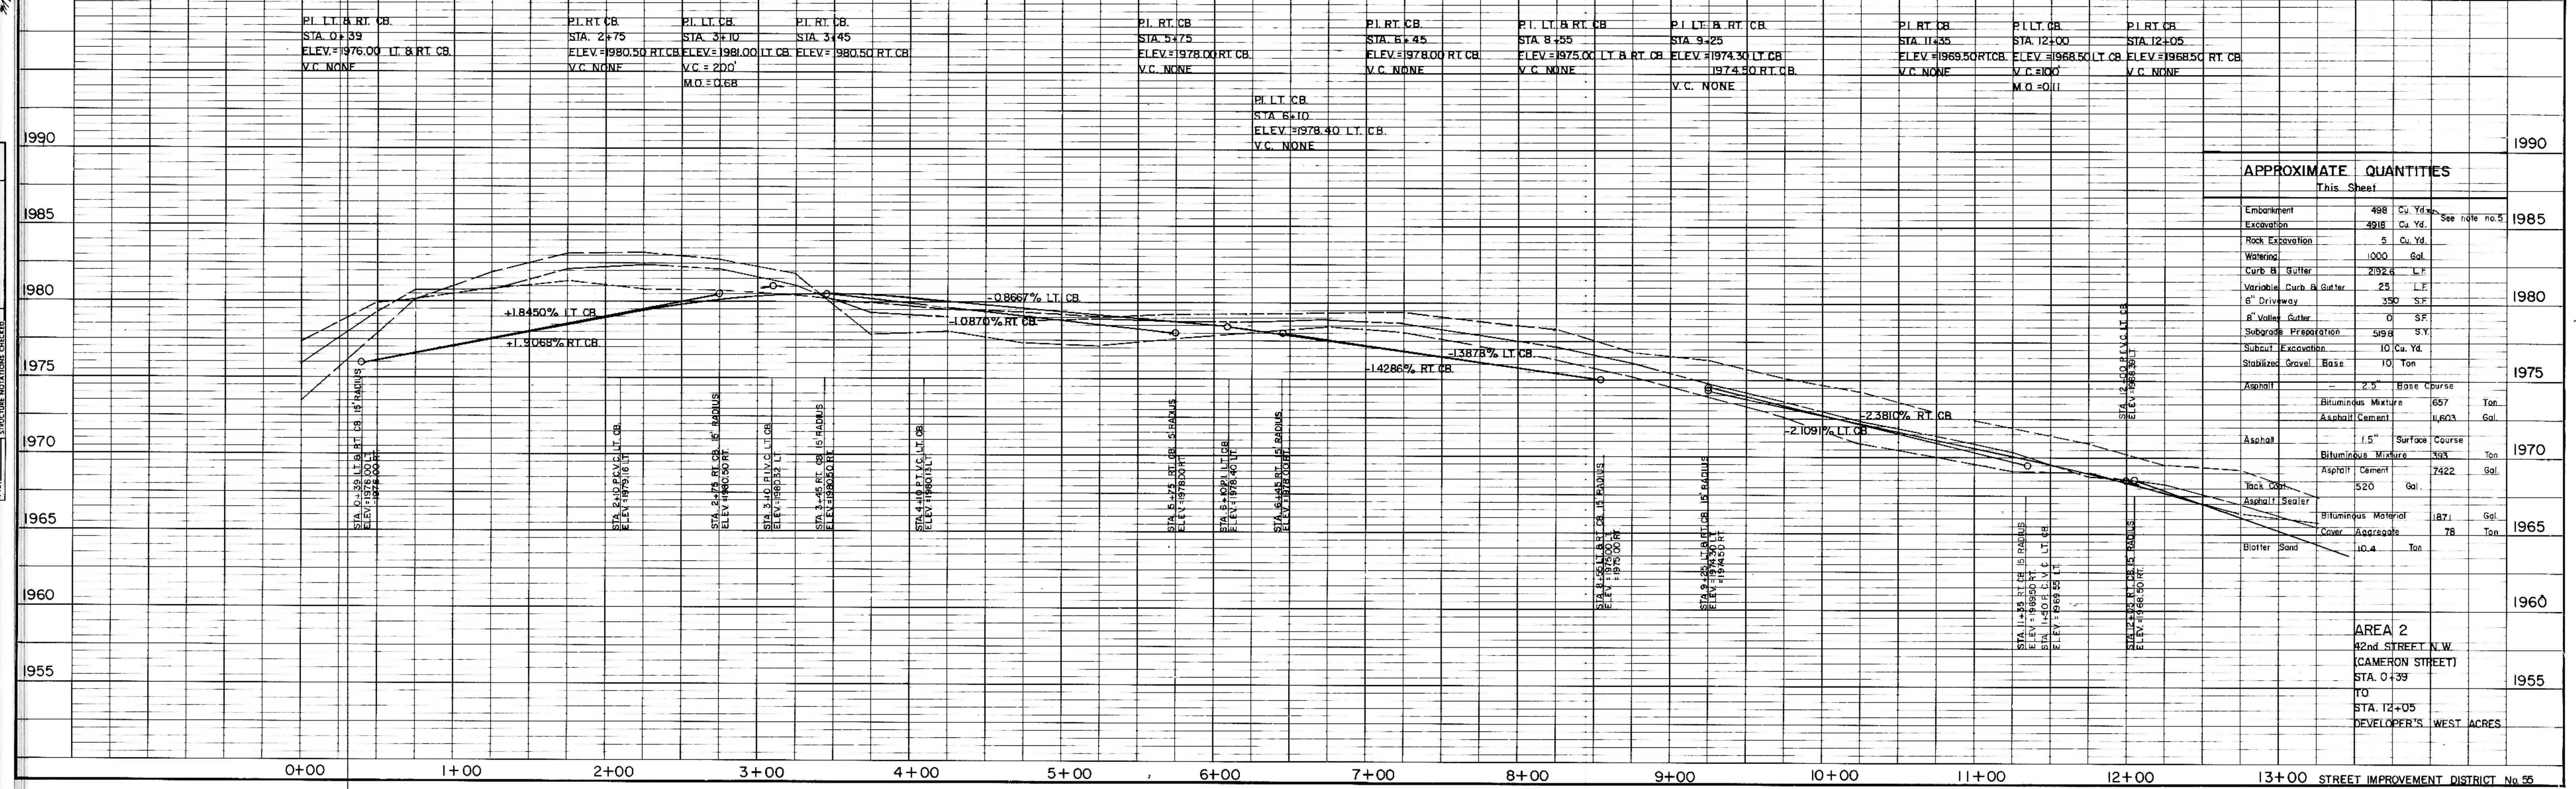

APPROXIMATE QUANTITIES
This Sheet

Embankment	488	Cu. Yd.	See note no. 5
Excavation	4216	Cu. Yd.	
Rock Excavation	5	Cu. Yd.	
Watering	1000	Gal.	
Curb & Gutter	2192.6	L.F.	
Variable Curb & Gutter	23	L.F.	
6" Driveway	350	S.F.	
8" Water Gutter	0	S.F.	
Subgrade Preparation	519.8	S.Y.	
Subcut Excavation	10	Cu. Yd.	
Stabilize Gravel Base	10	Ton	
Asphalt	2.5'	Base Course	
Bituminous Mixture	657	Ton	
Asphalt Cement	11,603	Gal.	
Asphalt	1.5"	Surface Course	
Bituminous Mixture	393	Ton	
Asphalt Cement	7422	Gal.	
Tack Coat	520	Gal.	
Asphalt Sealer			
Bituminous Material	187	Gal.	
Cover Aggregate	78	Ton	
Blotter Sand	10.4	Ton	

AREA 2
42nd STREET N.W.
(CAMERON STREET)
STA. 0+39
TO
STA. 12+05
DEVELOPER'S WEST ACRES

PLAN
DRAWN BY: []
CHECKED BY: []
DATE: []

PROFILE
DRAWN BY: []
CHECKED BY: []
DATE: []