


# UNIT 2

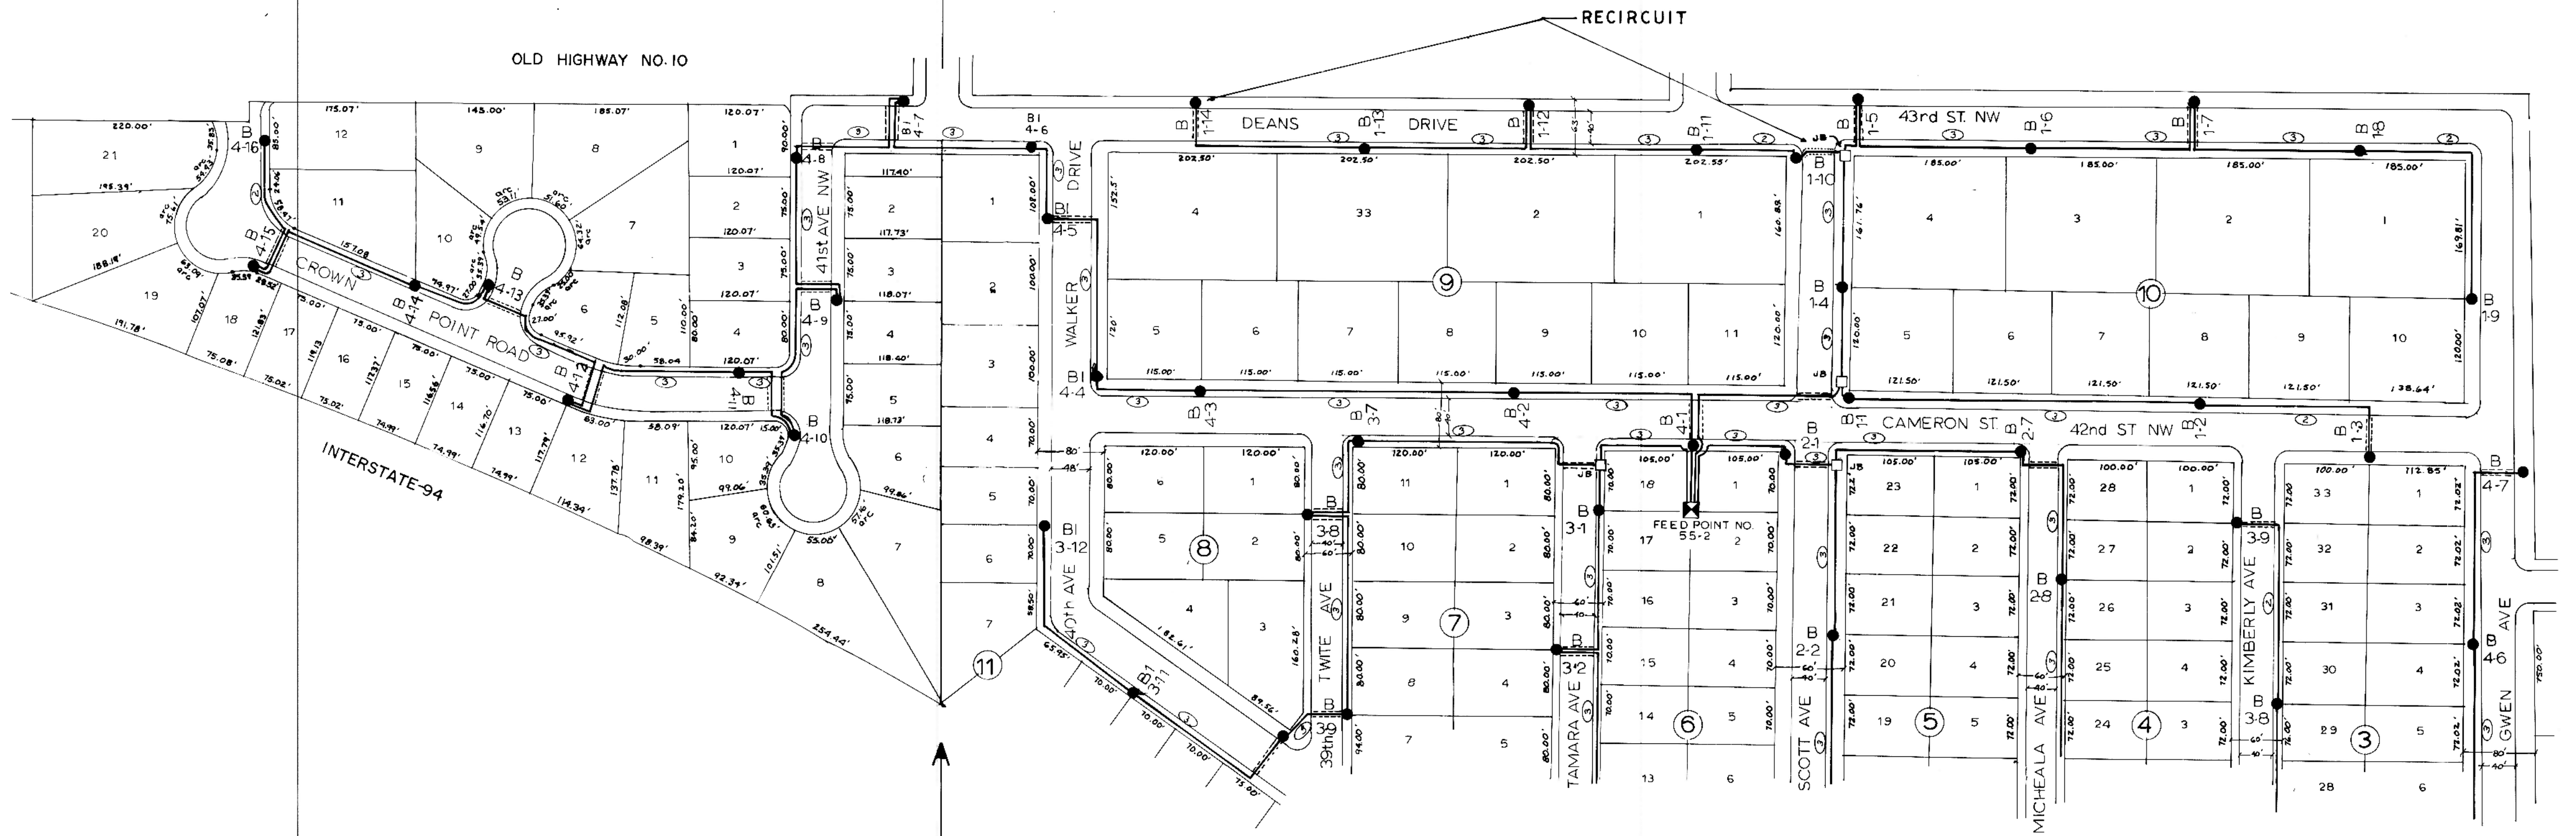

**REPLA of CROWN POINT SUBDIVISION**

**DEVELOPERS WEST ACRES - PARTIAL**