
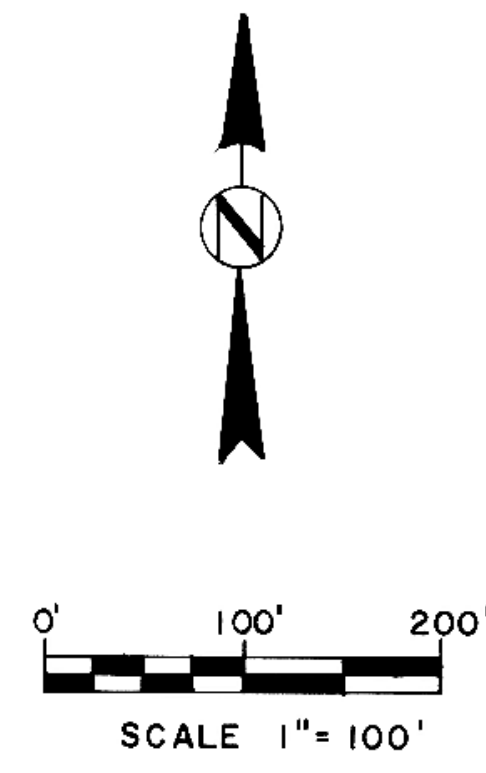


# UNIT 6

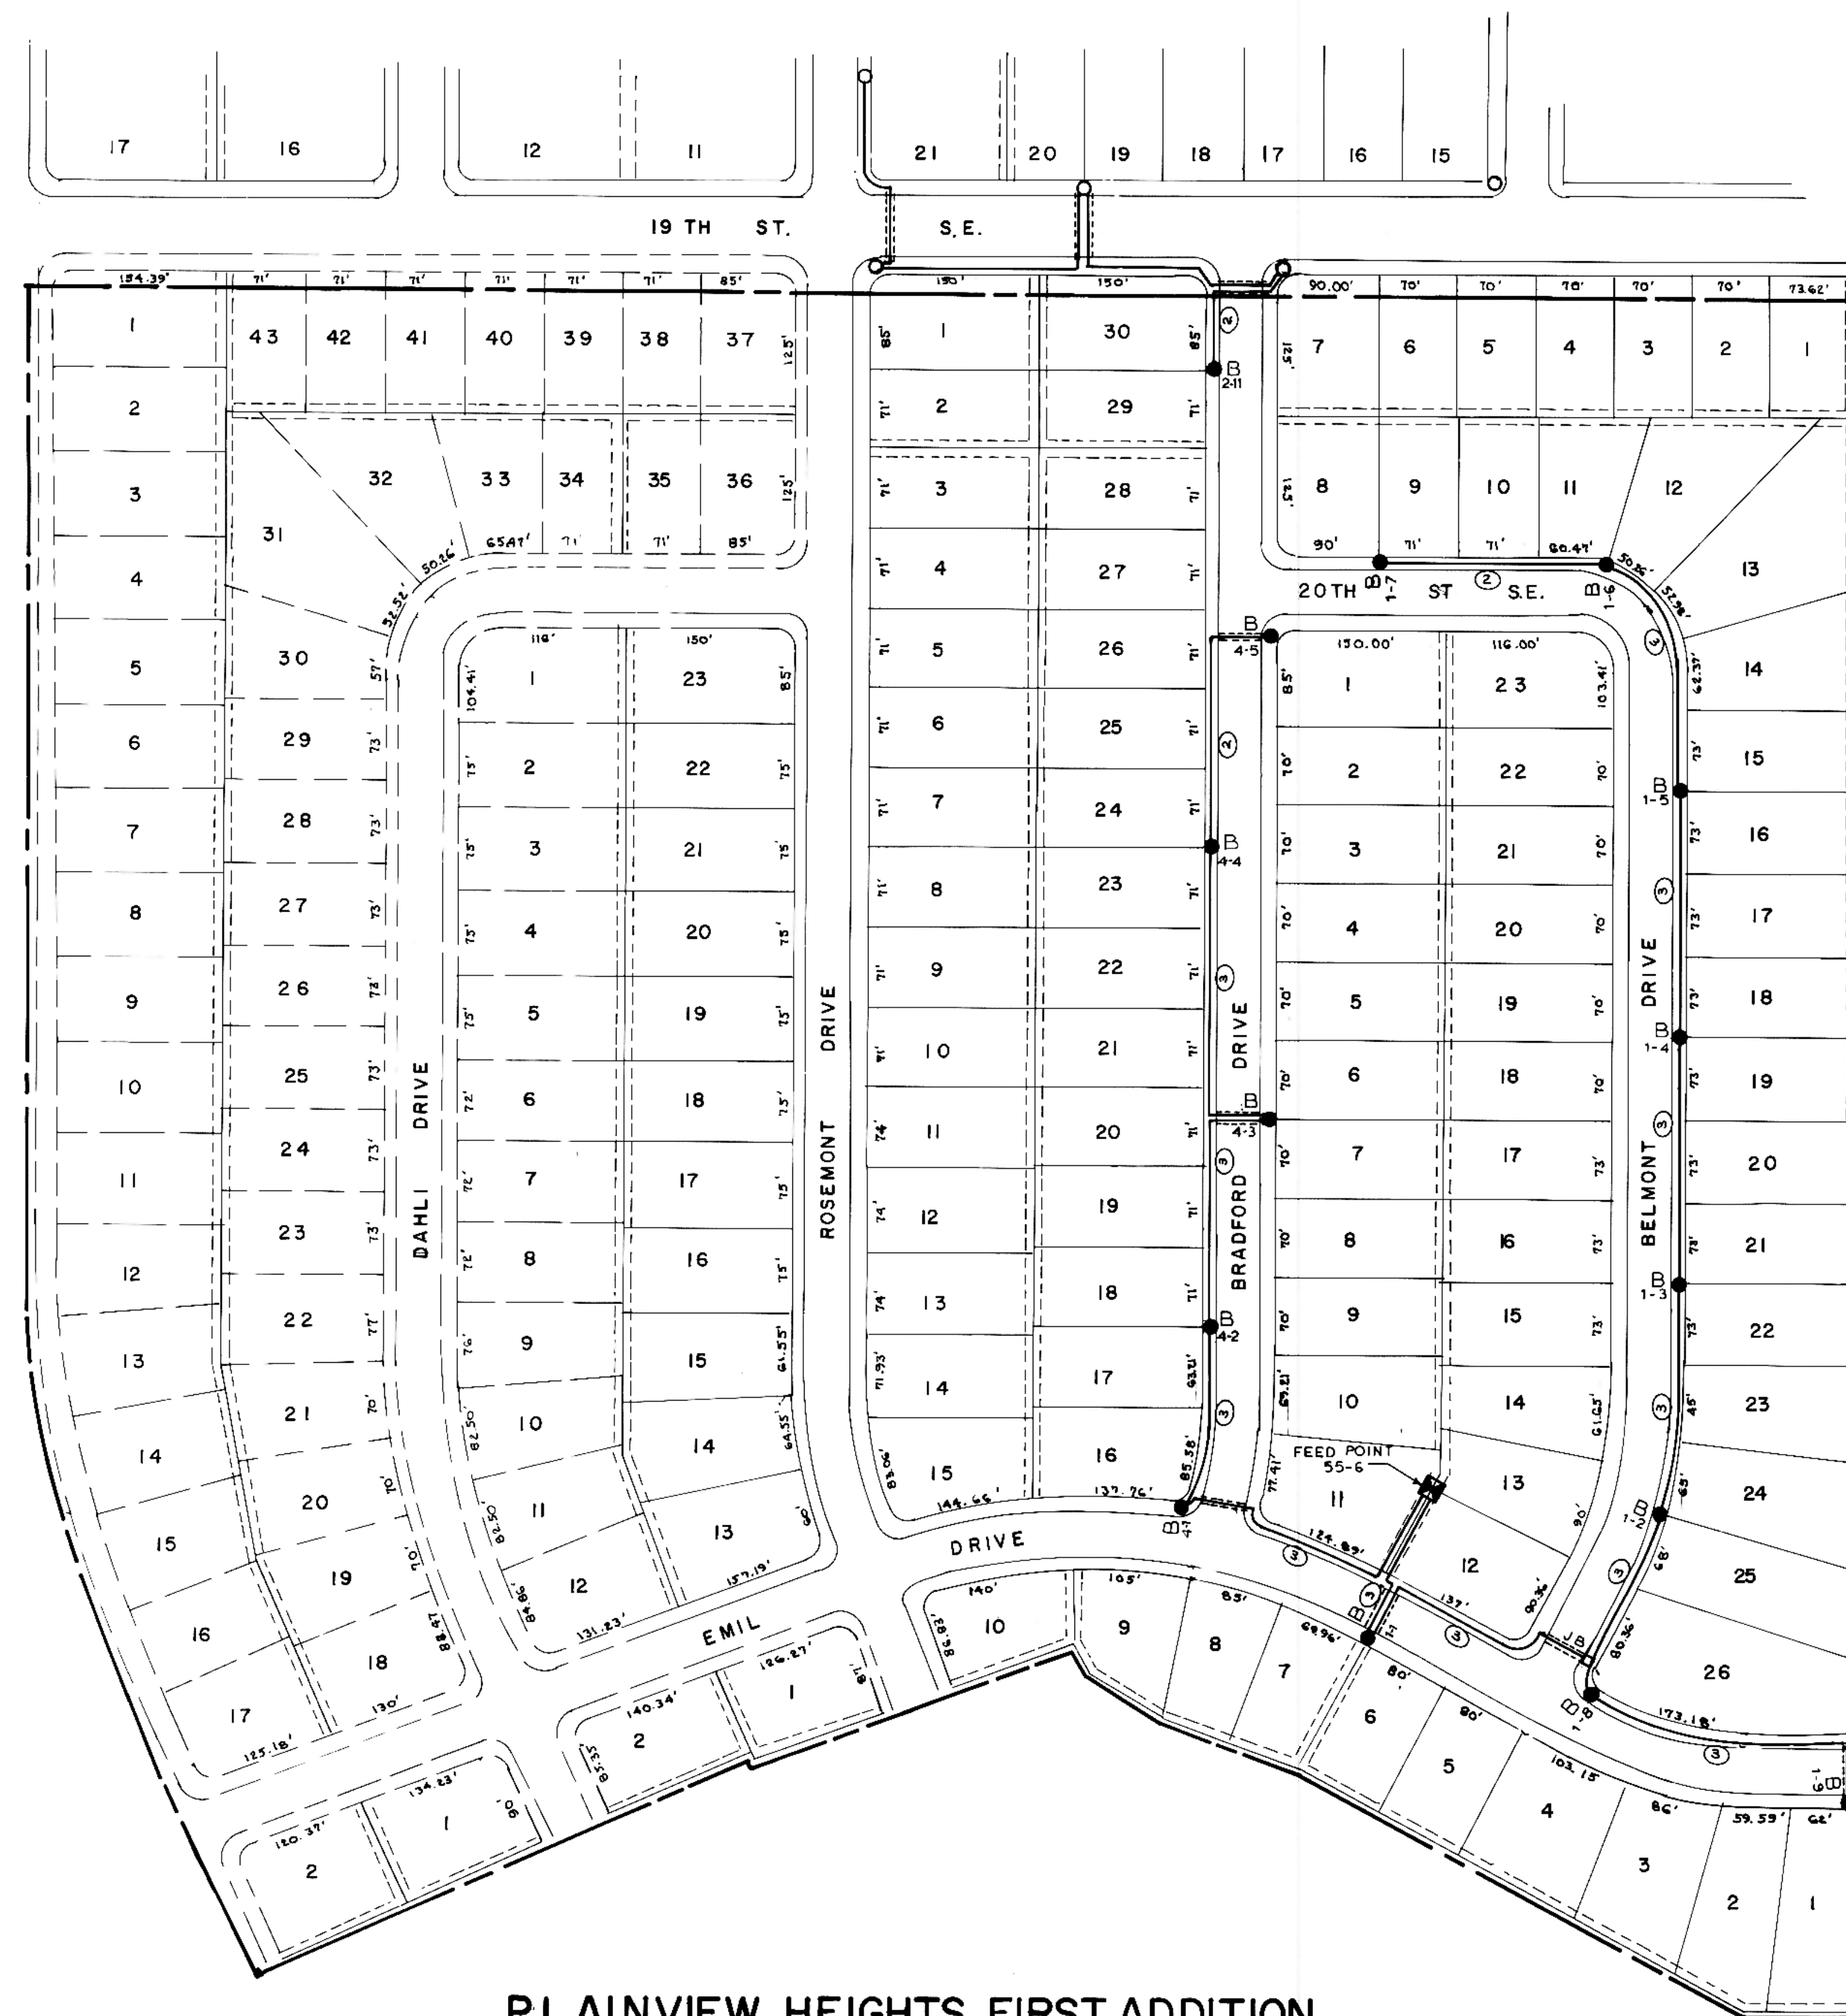

PLAINVIEW HEIGHTS FIRST ADDITION

SCHMIT, SMITH & RUSH  
CONSULTING ENGINEERS  
MINOT NORTH DAKOTA