
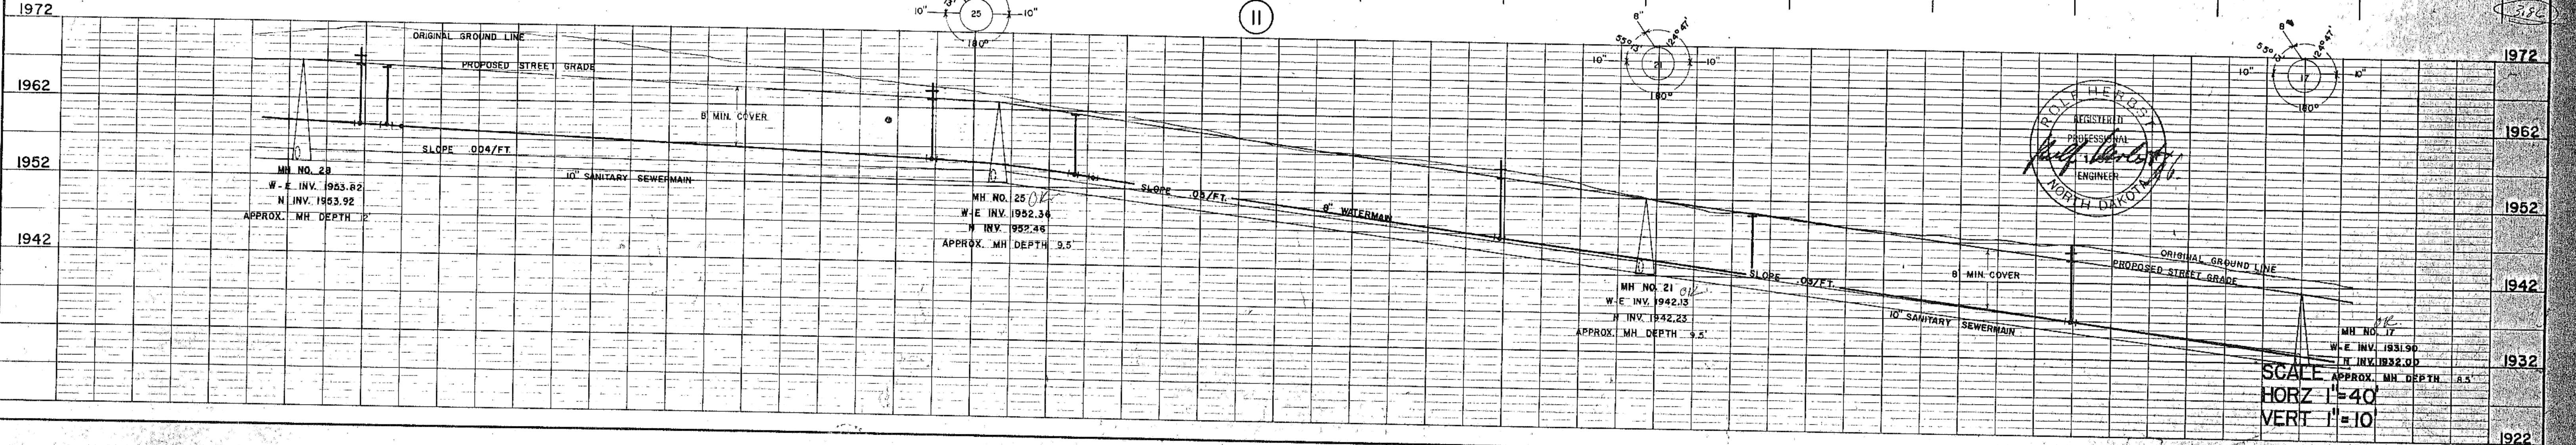
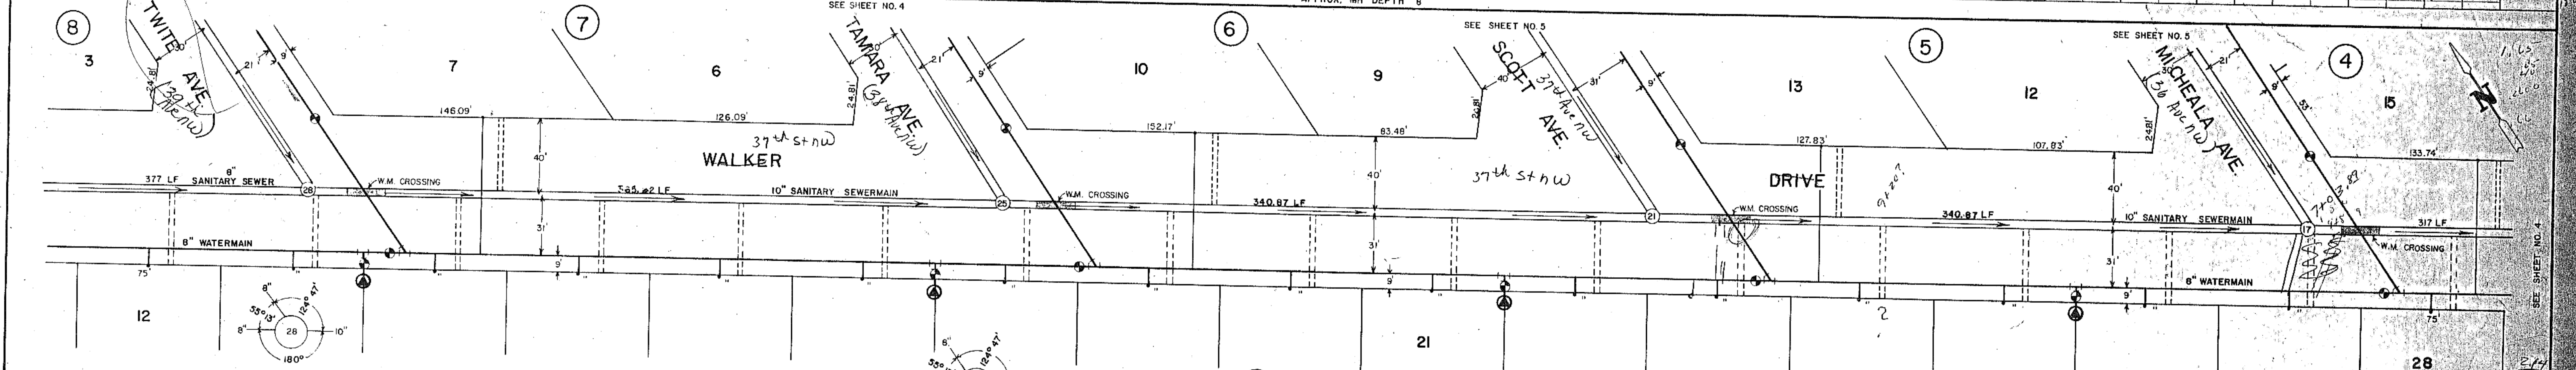
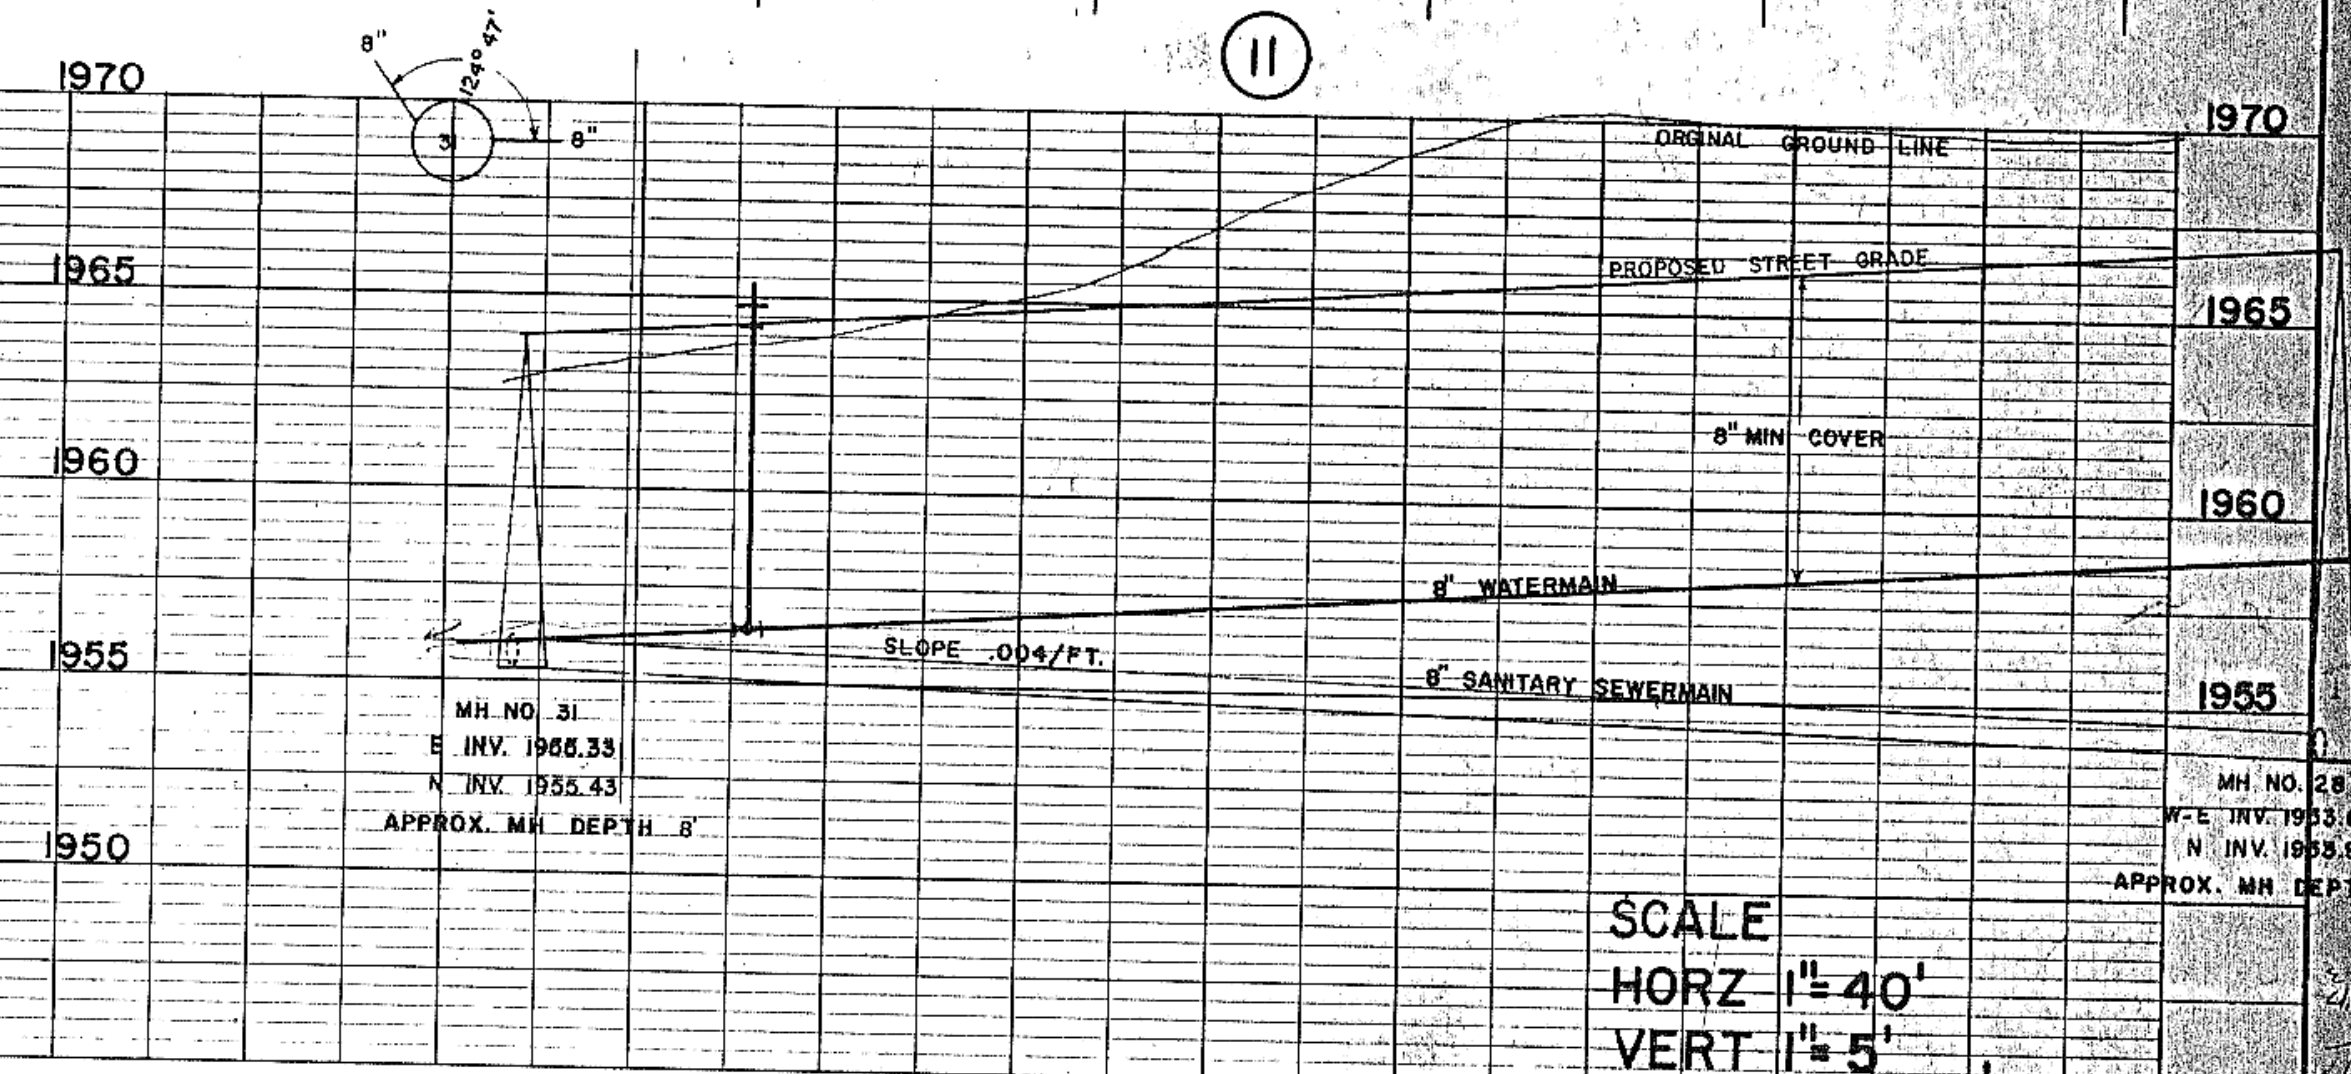
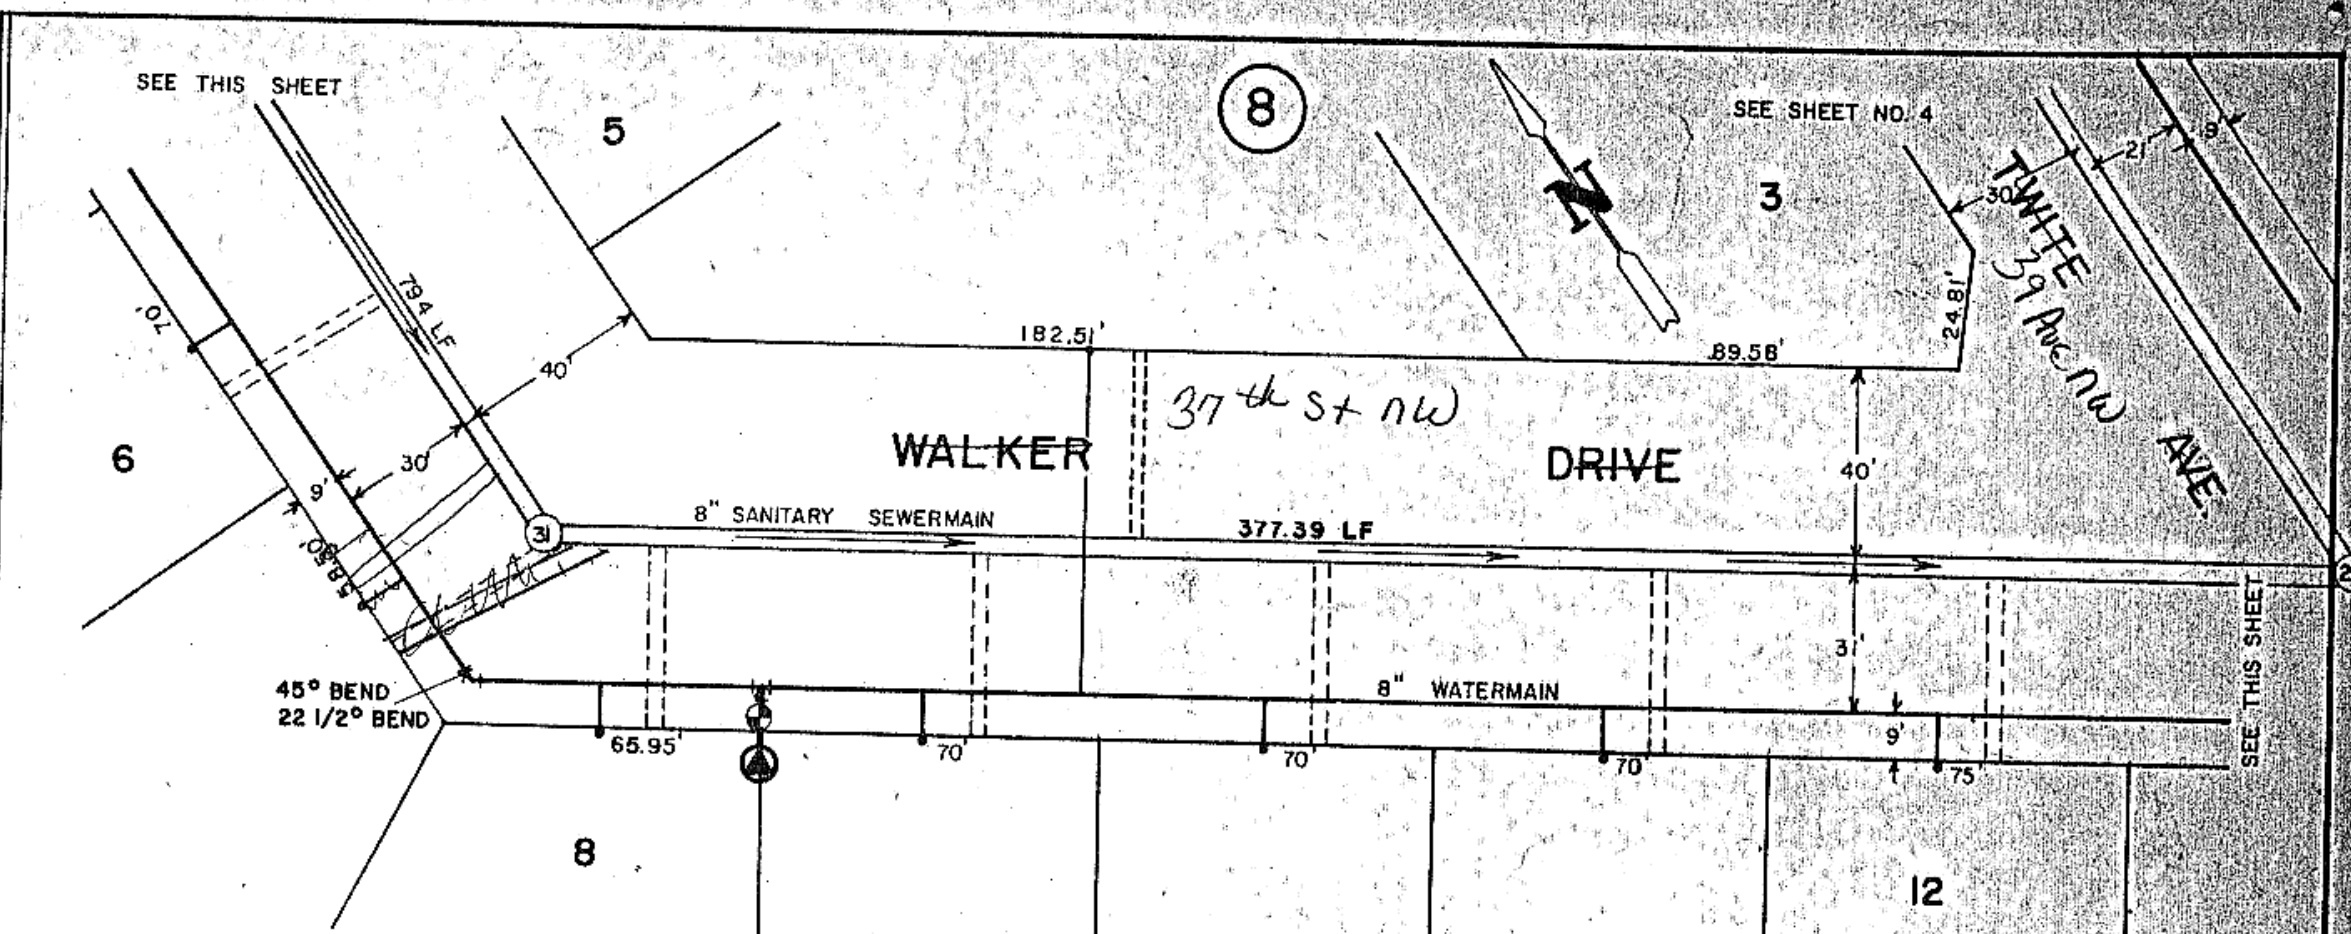
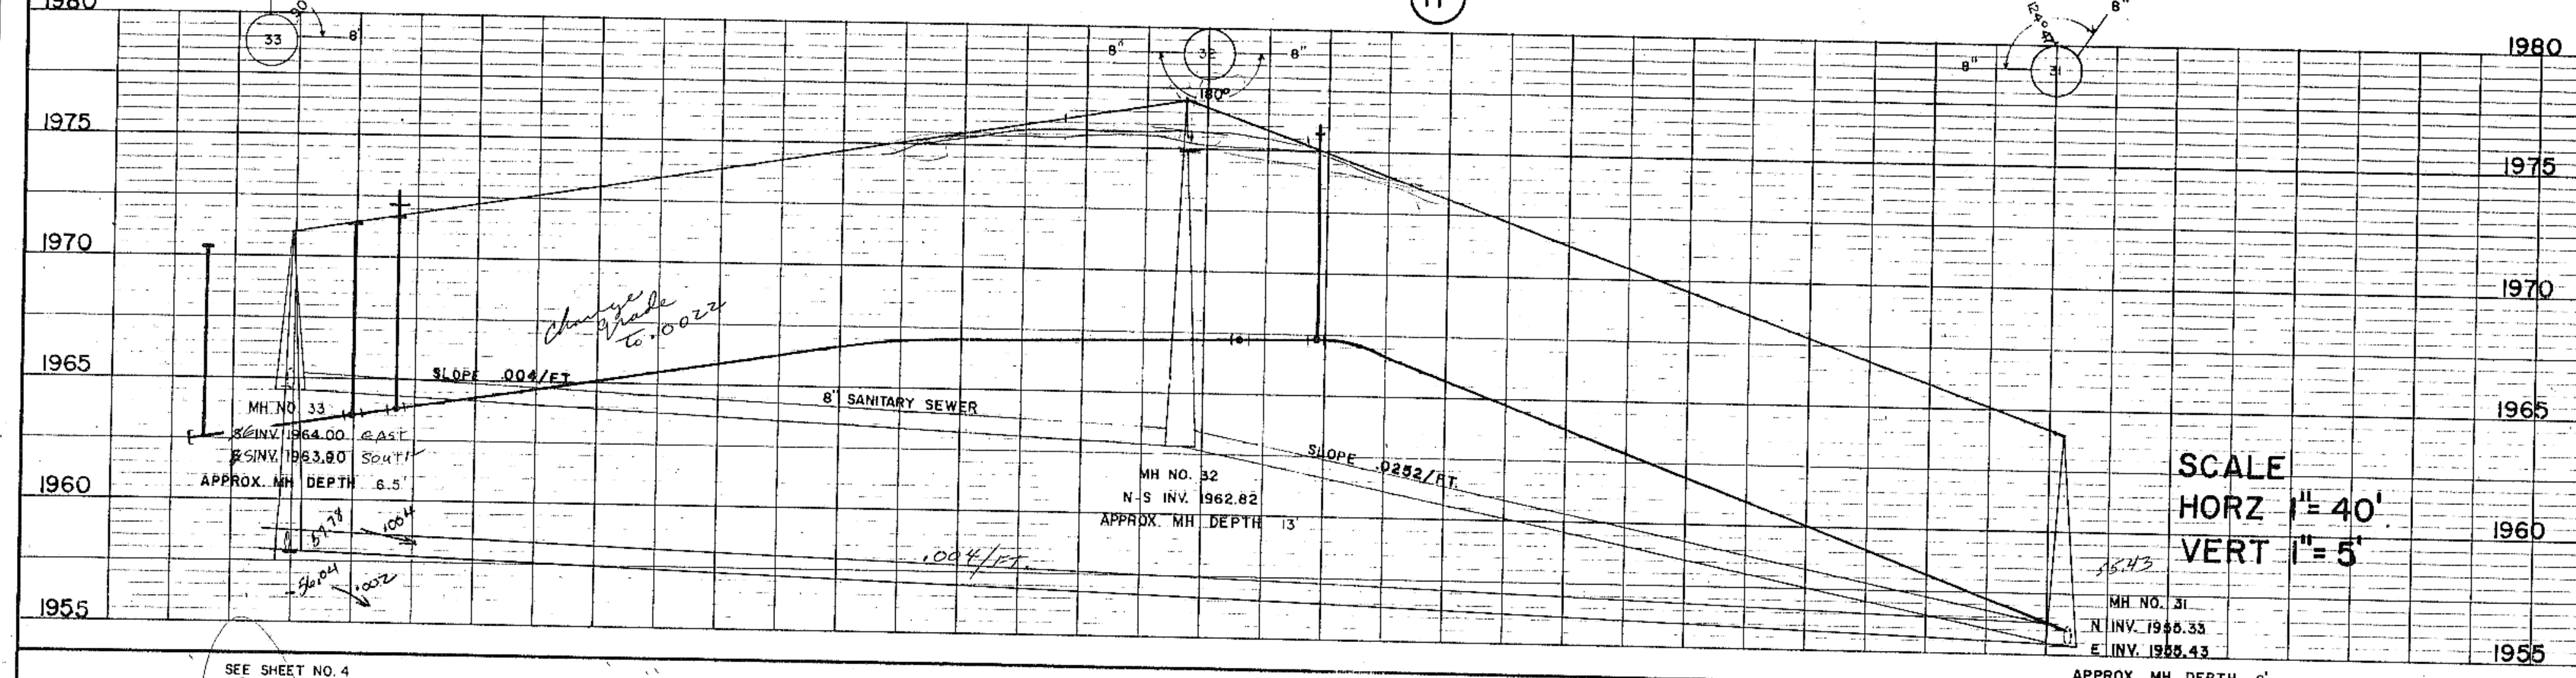



*DATE: 10/2/80*  
*BY: Dave Hanson*

PLAN	DATE
NO.	
BY	
DATE	
REVISIONS	
NO.	
DATE	
BY	
DESCRIPTION	

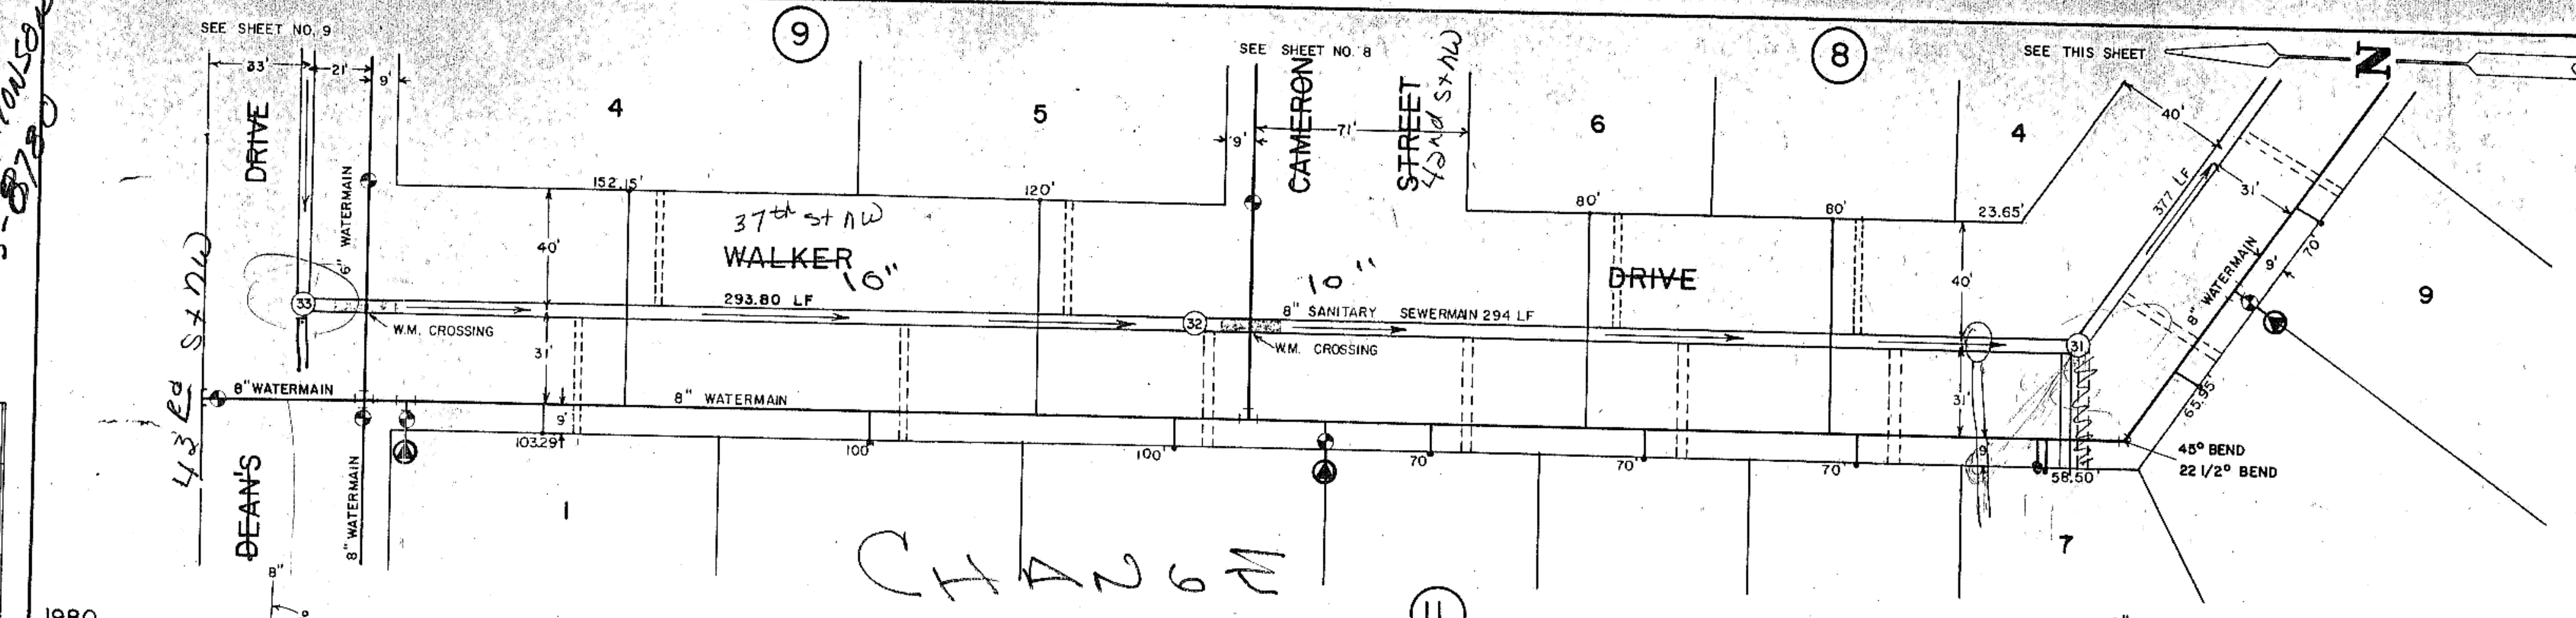

PROFILE	DATE
NO.	
BY	
DATE	
REVISIONS	
NO.	
DATE	
BY	
DESCRIPTION	

K&E PLATE 2, FLAT PLAN-PROFILE  
 KEUFFEL & ESSER CO.  
 48 7032, MADE IN U.S.A.

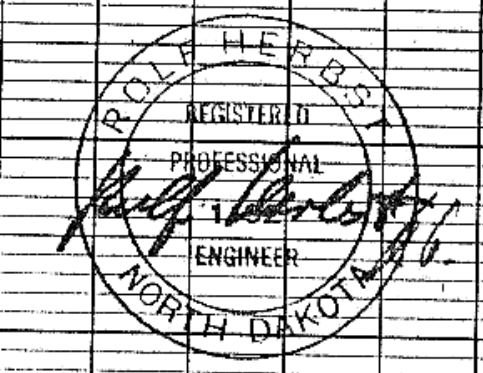

Toman Engineering Company  
 Civil & Environmental Consultants  
 P. O. Box 708 Mandan, N.D. 58542  
 SHEET NO. 3 OF 12 SHEETS