

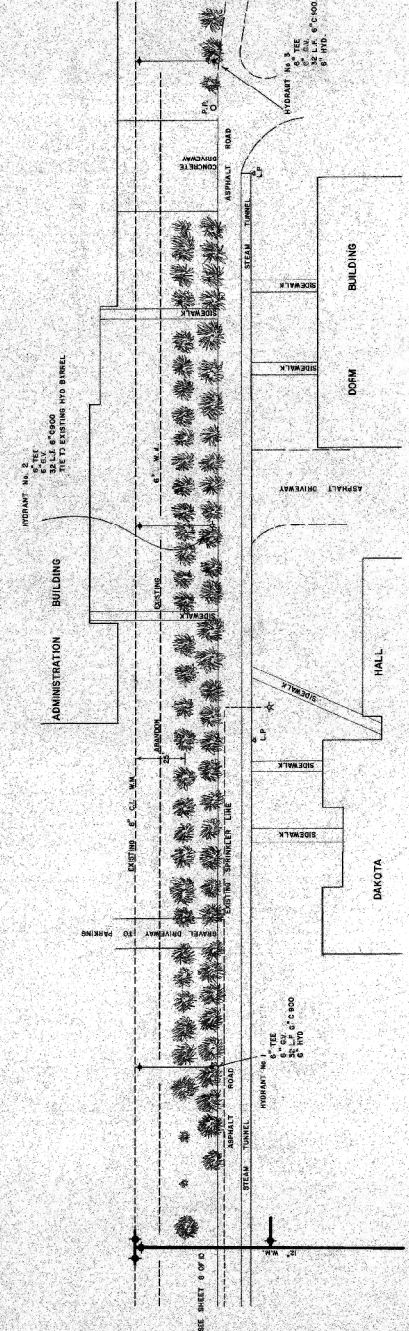


HORZ 1" = 30'
VERT 1" = 2'

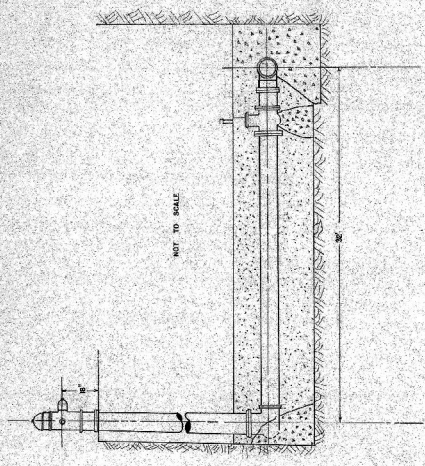

DATE	REVIEW/APPR BY	DESCRIPTION
		CITY OF MANDAN, NORTH DAKOTA
		ENGINEERING DEPARTMENT
		HYDRANT CONNECTIONS AT S.I.S. GROUNDS
PROJECT NO.	85-2	
DATE	10/11/11	
SCALE	1" = 30'	
SHEET NO.	9 OF 9	

PLAN	DATE	BY	CHKD

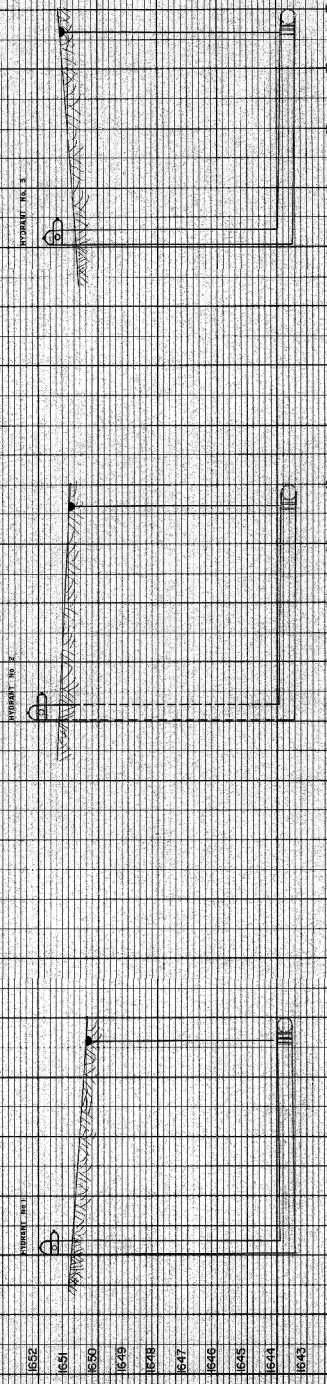

PROFILE	DATE	BY	CHKD

AS BUILT