


APRIL 1993
 0 20 40 60 80
 SCALE: 1"=20' HOR
 1"=5' VER

DIVISION ST NW

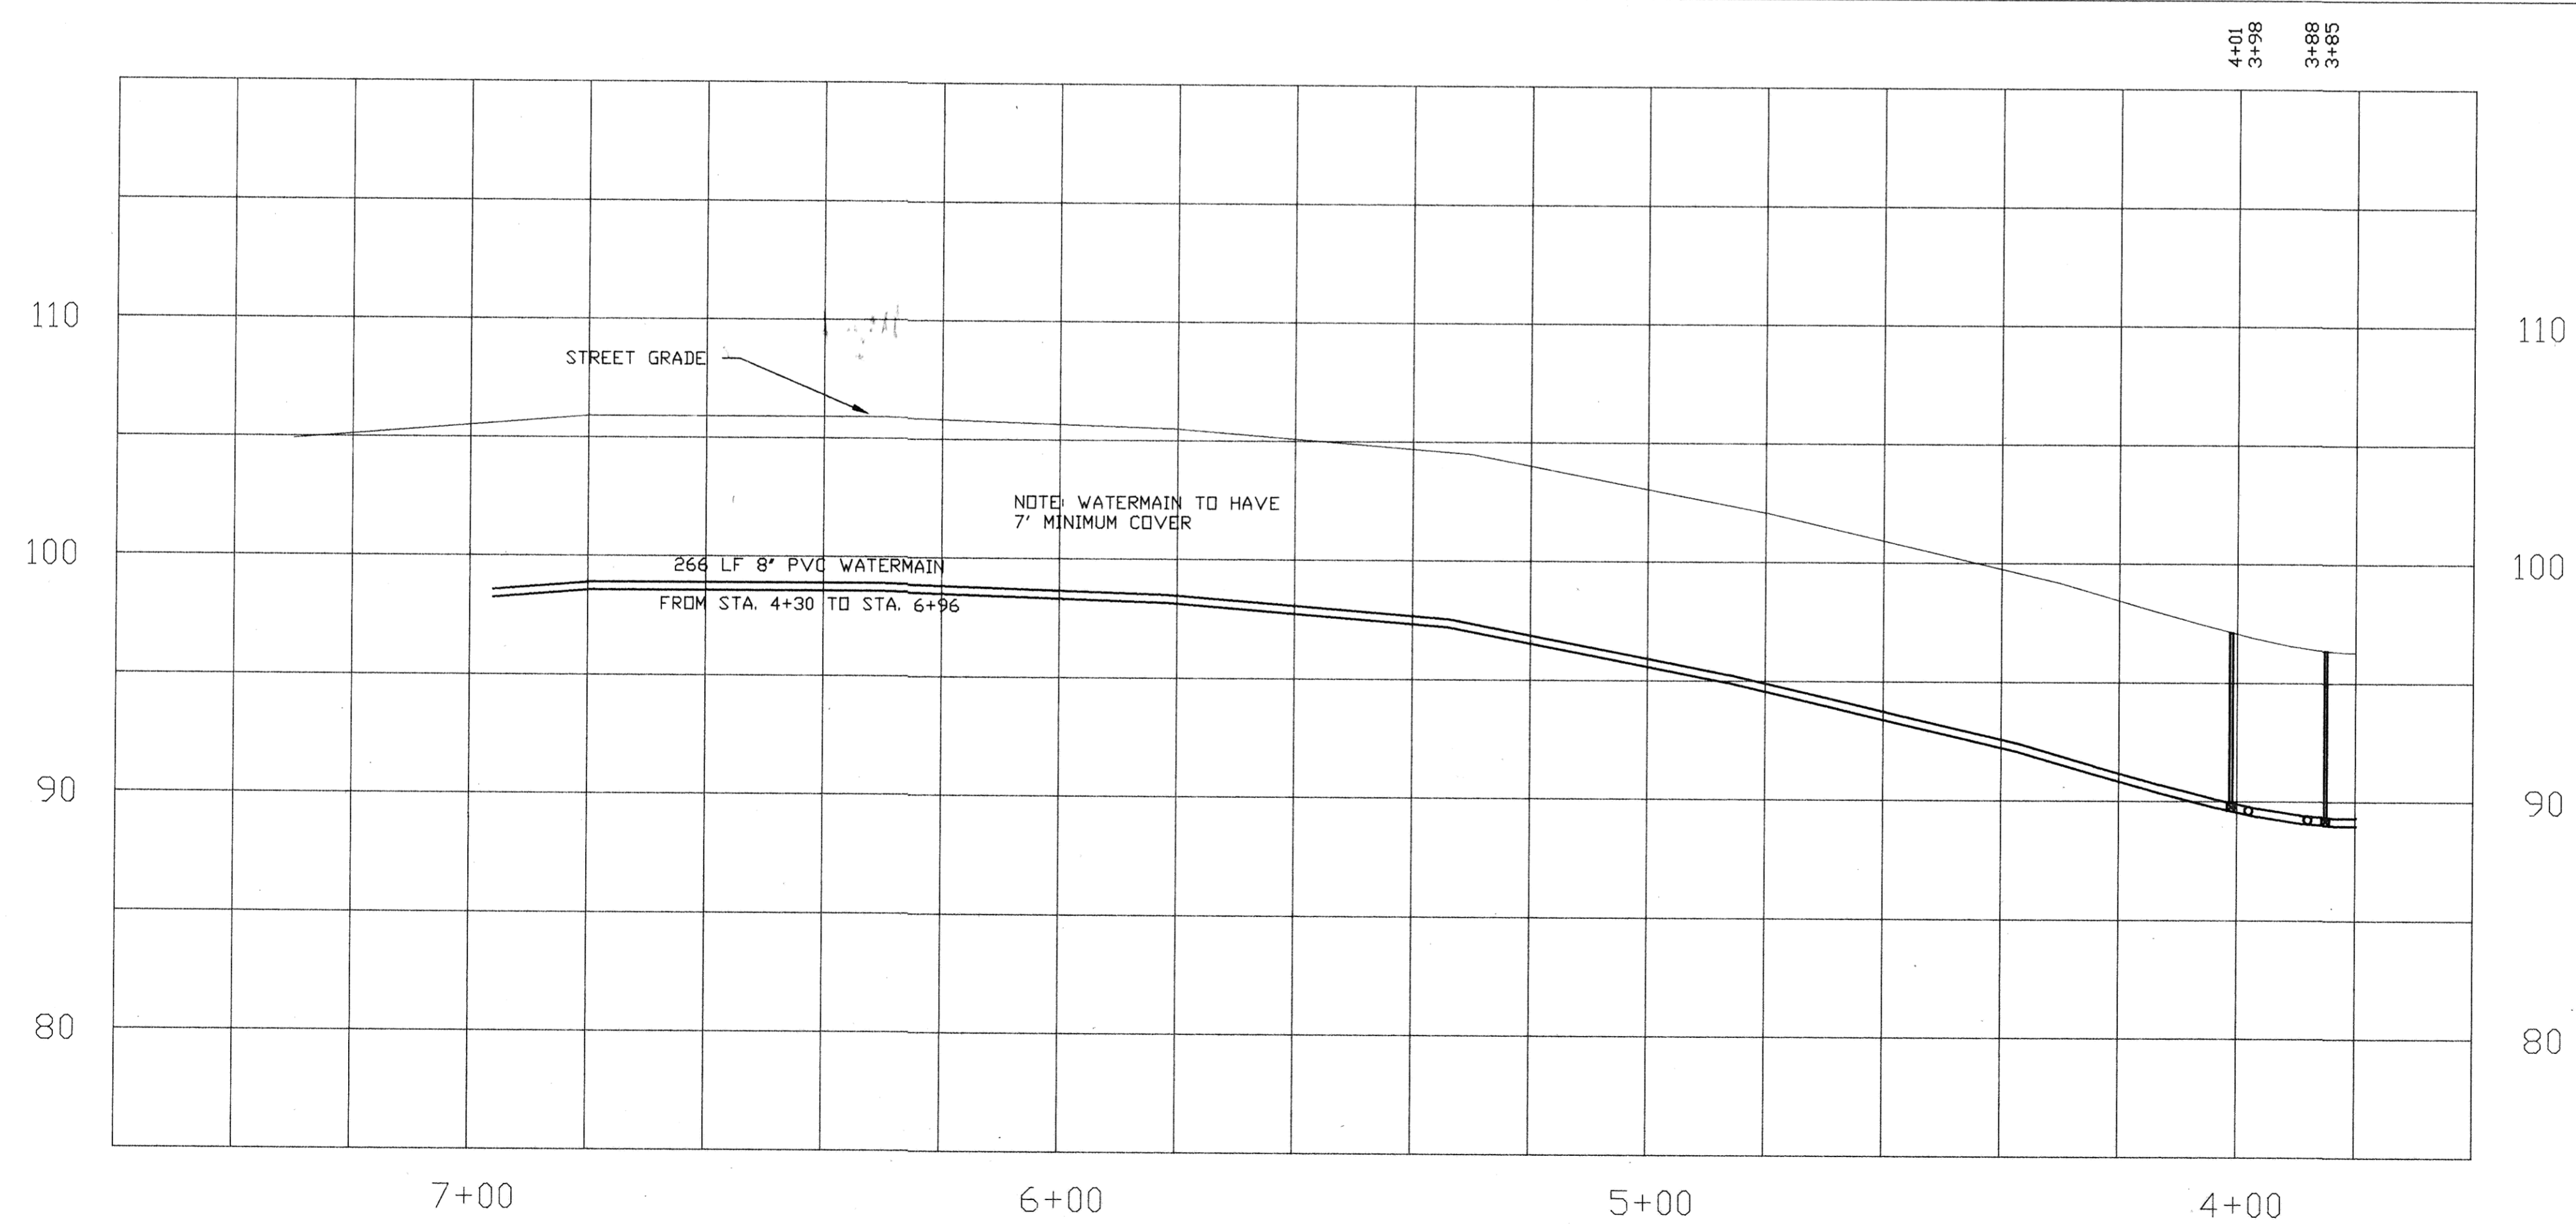

STA. 3+85
8' G.V.

STA. 3+88
8x8 TEE

STA. 3+98
8x8 TEE

STA. 4+01
8' G.V.

FEB. 1995	JW	TL	AS BUILT
DATE	REV. BY	APPR. BY	DESCRIPTION
CITY OF MANDAN, NORTH DAKOTA ENGINEERING DEPARTMENT			
WATER IMPROVEMENT PROJECT 93-4 DIVISION ST NW			
CITY ENG. BY	T. LITTLE	DRAWN BY	J. WRIGHT
APPR. BY		CHECKED BY	
PROJECT NO.	93-4	DISTRICT NO.	N/A
		SCALE:	AS SHOWN
		DATE:	
		SHEET	2 OF 9