


APRIL 1993

0 20 40 60 80

SCALE: 1"=20' HOR
1"=5' VER

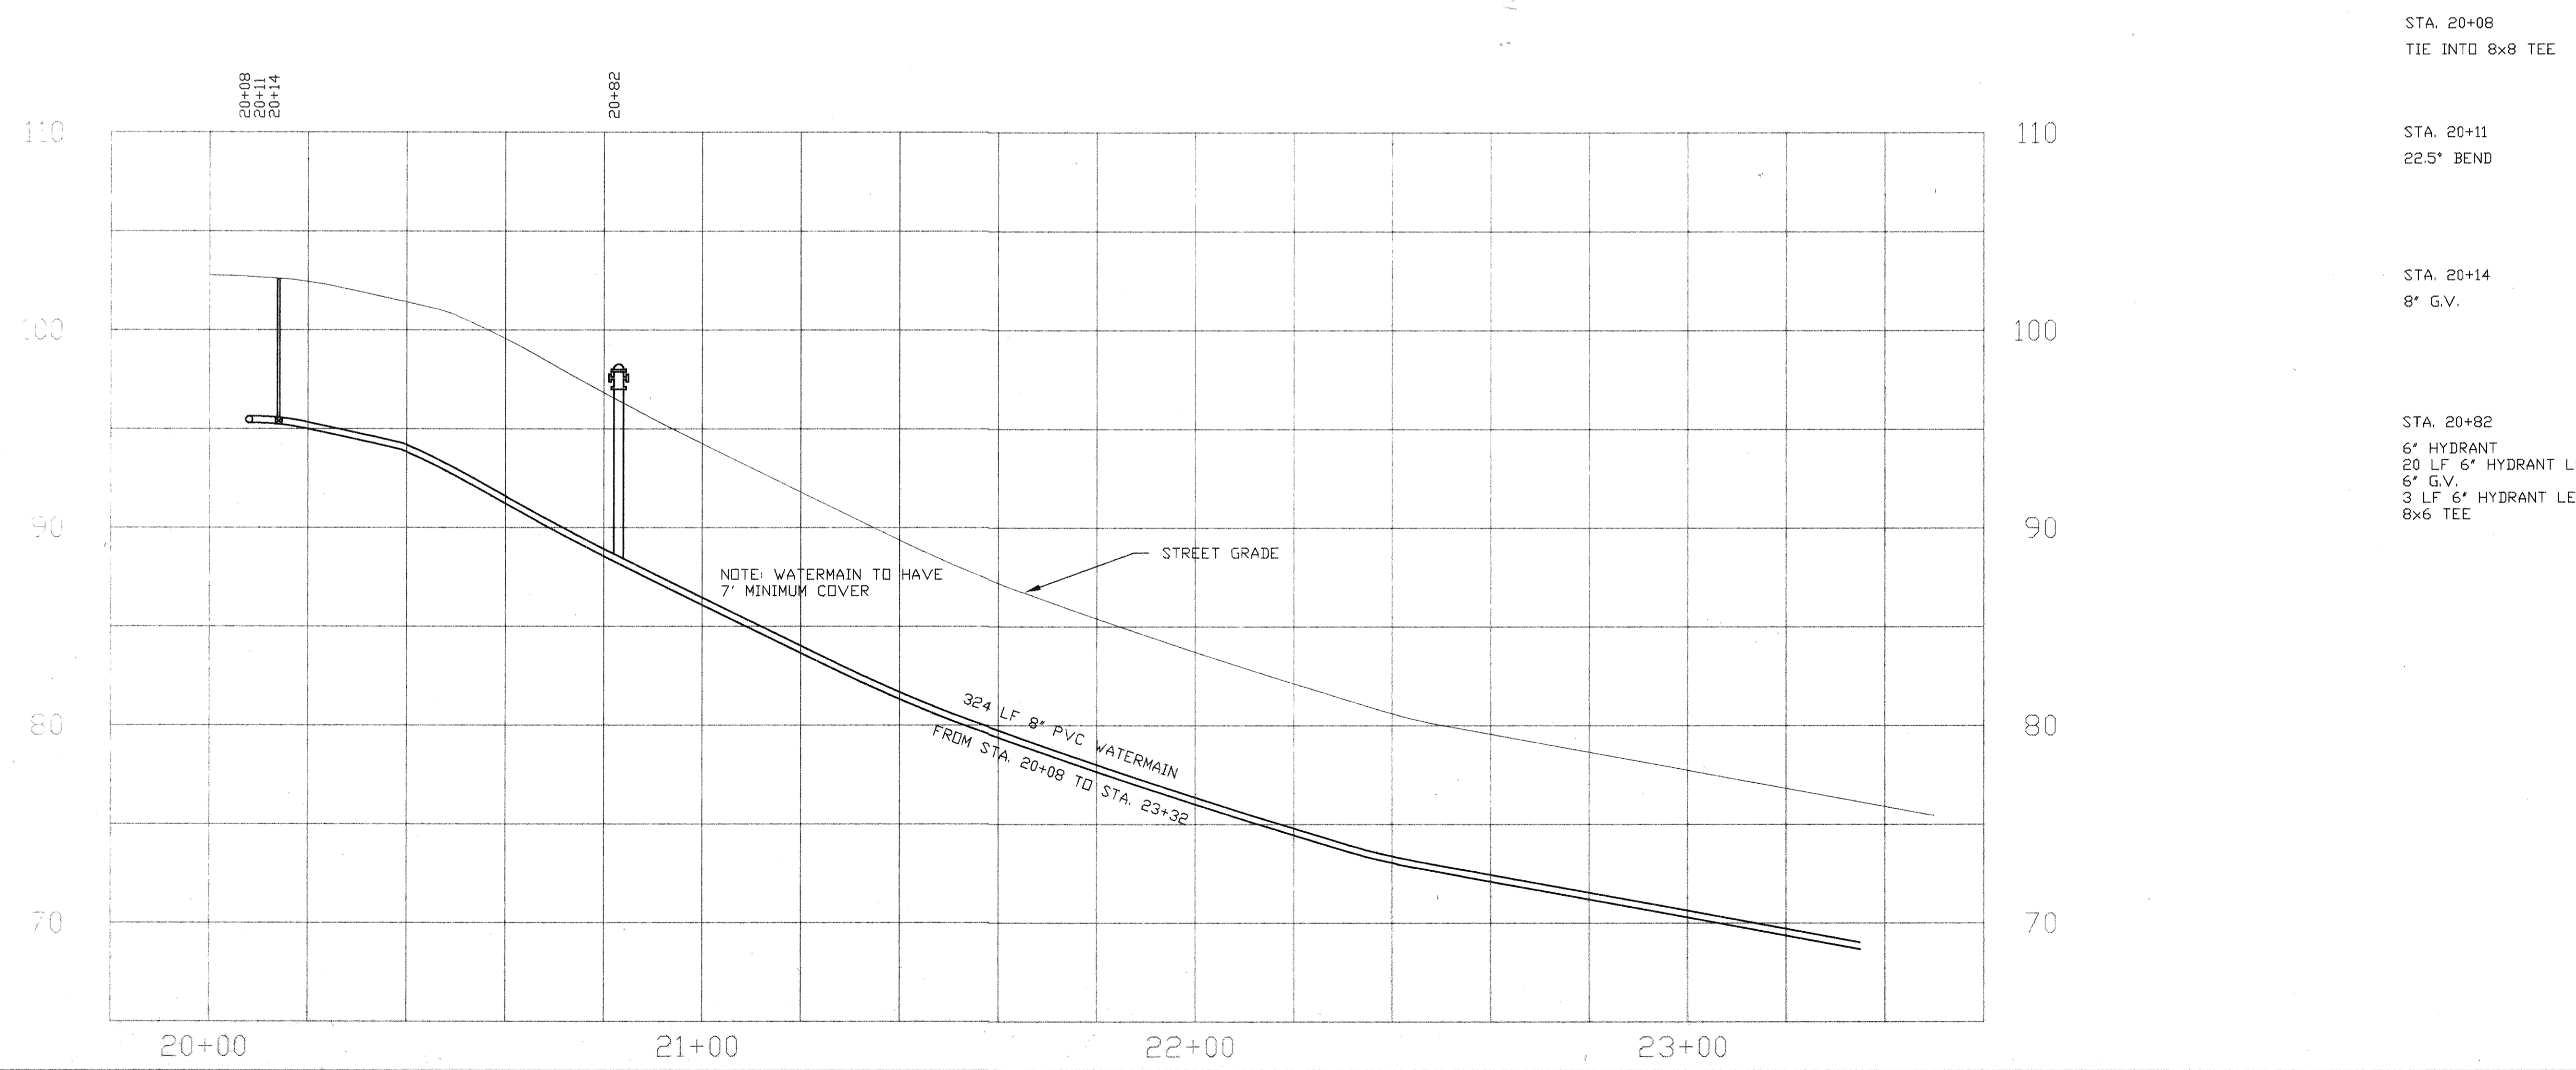

STA. 20+08
TIE INTO 8x8 TEE

STA. 20+11
22.5° BEND

STA. 20+14
8' G.V.

STA. 20+82
6' HYDRANT
20 LF 6' HYDRANT LEAD
6' G.V.
3 LF 6' HYDRANT LEAD
8x6 TEE

FEB. 1995	JW	TL	AS BUILT
DATE	REV. BY	APPR. BY	DESCRIPTION
CITY OF MANDAN, NORTH DAKOTA ENGINEERING DEPARTMENT			
WATER IMPROVEMENT PROJECT 93-4 4TH AVE NW			
CITY ENG.	T. LITTLE	DRAWN BY	J. WRIGHT
APPR. BY		CHECKED BY	
PROJECT NO.	93-4	DISTRICT NO.	N/A
		SCALE:	AS SHOWN
		DATE:	
		SHEET	4 OF 9