


APRIL 1993

0 20 40 60 80

SCALE: 1"=20' HOR
1"=5' VER

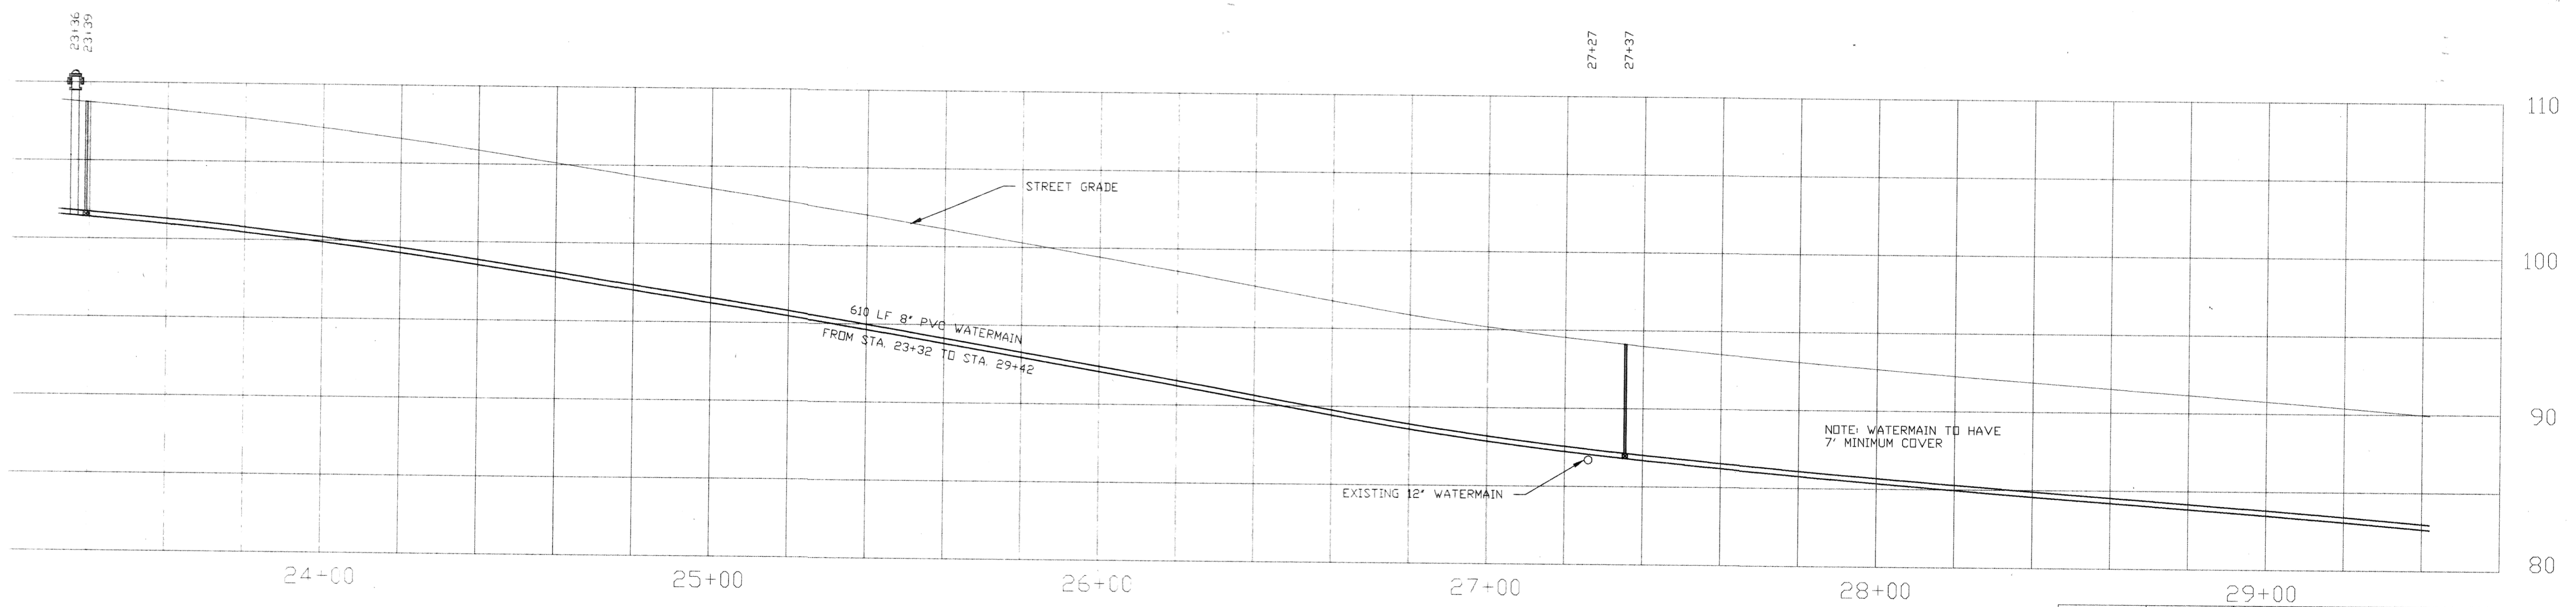

STA 23+36
6" HYDRANT
20 LF 6" HYDRANT LEAD
3 1/2" 6" HYDRANT LEAD
8x6 TEE

STA 23+39
8" G.V.

STA 27+37
8" G.V.

FEB. 1995	JW	TL	AS BUILT
DATE	REV. BY	APPR. BY	DESCRIPTION
CITY OF MANDAN, NORTH DAKOTA ENGINEERING DEPARTMENT			
WATER IMPROVEMENT PROJECT 93-4 4TH AVE NW			
CITY ENG. BY	T. LITTLE	DRAWN BY	J. WRIGHT
APPR. BY		CHECKED BY	
PROJECT NO.	93-4	DISTRICT NO.	N/A
SCALE	AS SHOWN	DATE	
SHEET	5 OF 9		