
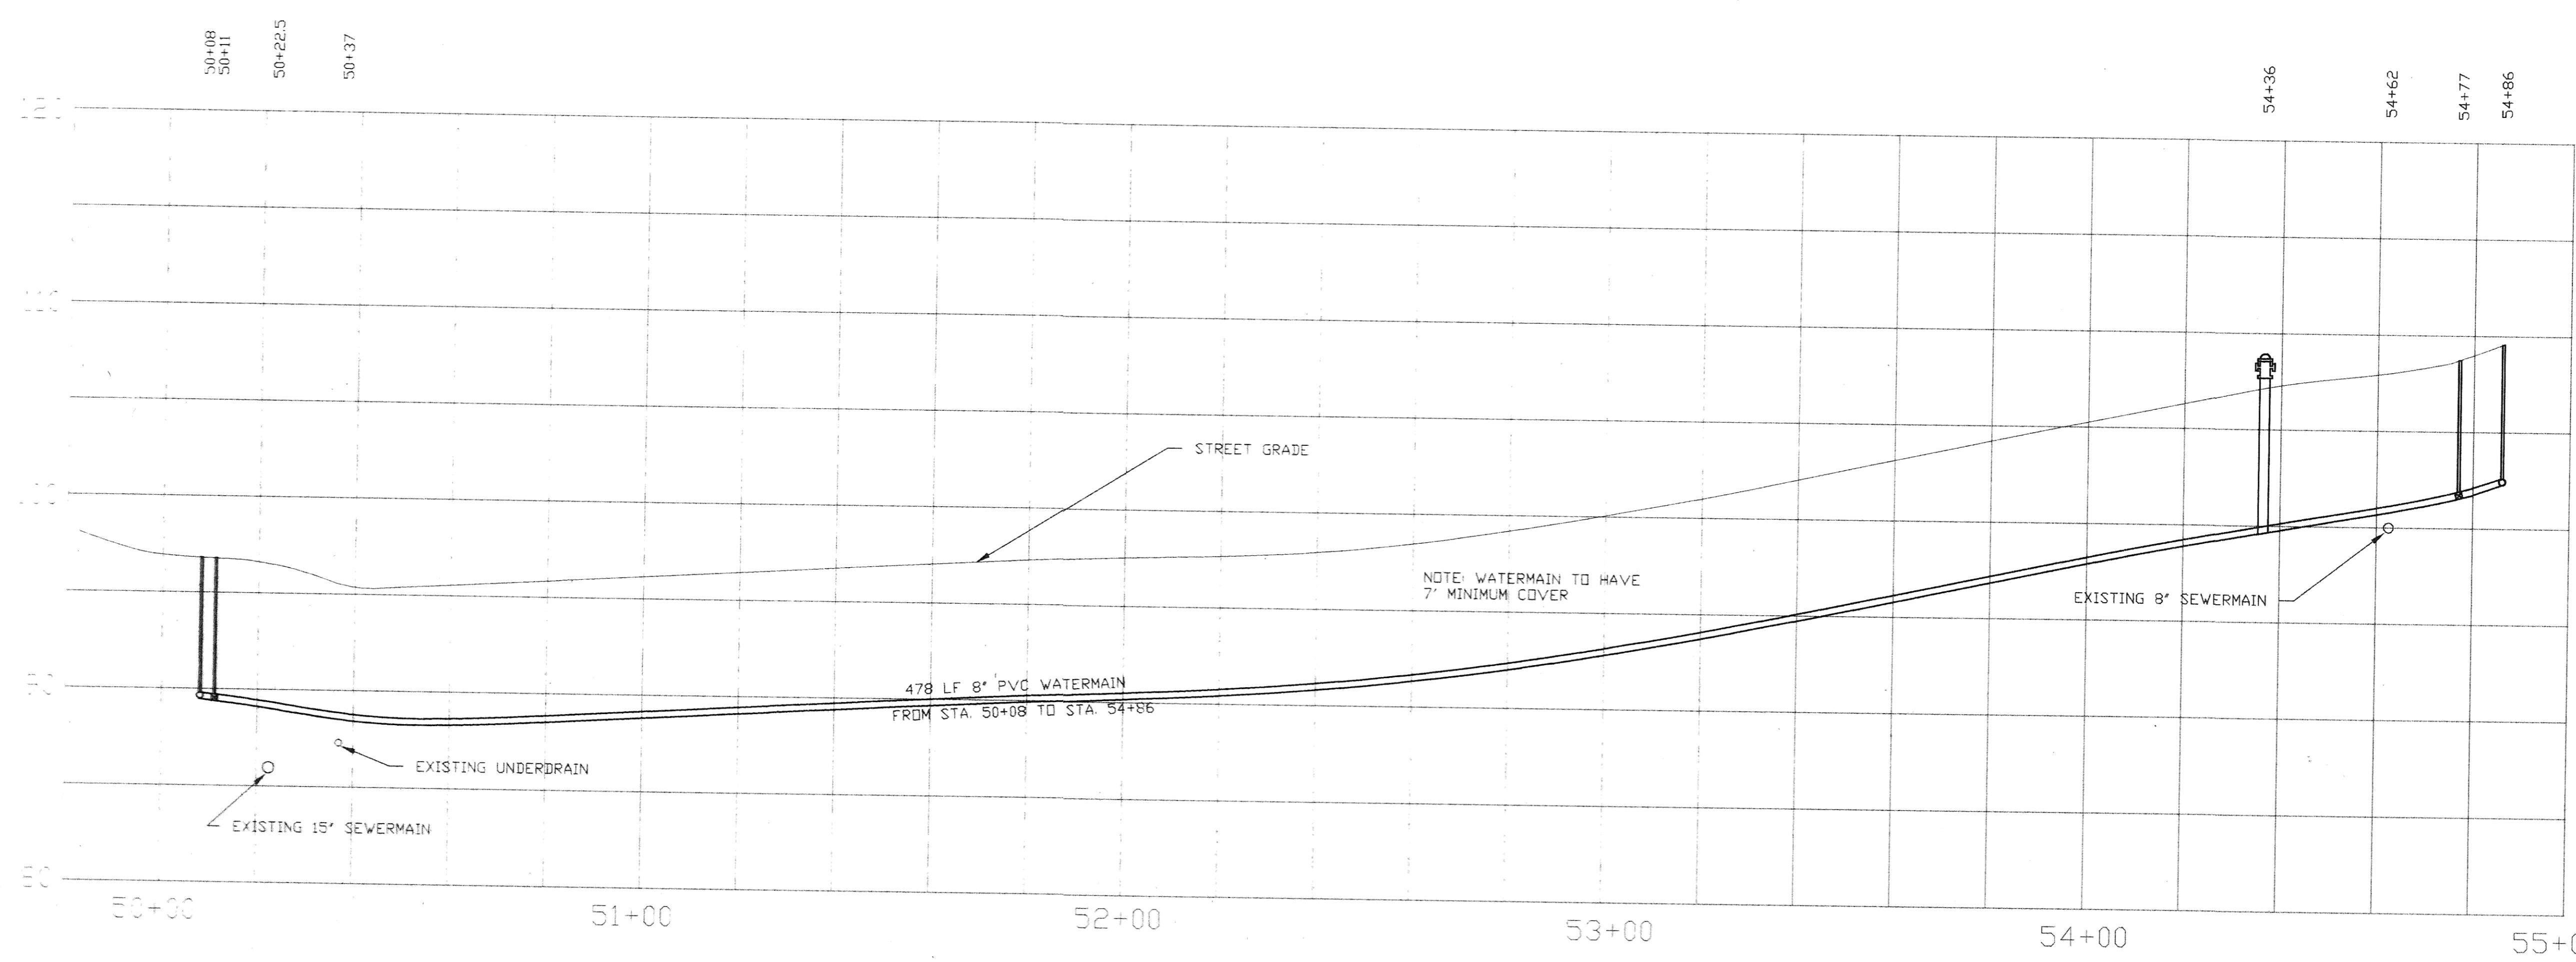


APRIL 1993

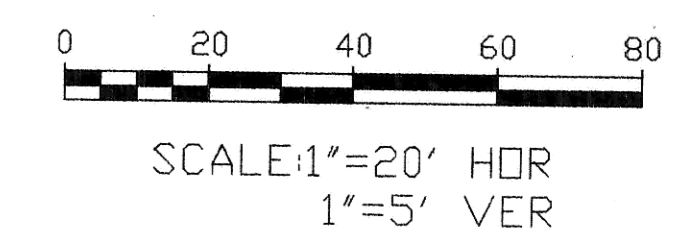

- STA. 50+08
TIE INTO EXISTING 8" W.M.
2-8" G.V.
12 LF 8" PVC
8x8 TEE
3 LF 8" PVC
- STA. 50+11
8" G.V.
- STA. 54+36
REMOVE AND SALVAGE HYDRANT
6" HYDRANT
20 LF 6" HYDRANT LEAD
6" G.V.
9 LF 6" HYDRANT LEAD
6x8 TEE
- STA. 54+77
8" G.V.
- STA. 54+86
TIE INTO EXISTING 6" W.M.
2-6" G.V.
12 LF 6" PVC
6x8 TEE
3 LF 6" PVC

FEB. 1995	JW	TL	AS BUILT
DATE	REV. BY	APPR. BY	DESCRIPTION
CITY OF MANDAN, NORTH DAKOTA ENGINEERING DEPARTMENT			
WATER IMPROVEMENT PROJECT 93-4 4TH AVE NW			
CITY ENG. BY	T. LITTLE	DRAWN BY	J. WRIGHT
APPR. BY		CHECKED BY	
PROJECT NO.	93-4	DISTRICT NO.	N/A
SCALE	AS SHOWN	DATE	
SHEET	9	OF	9