


PLAN
 SUBMITTED FOR REVIEW
 DATE: _____
 DRAWN BY: _____
 CHECKED BY: _____
 NOTE BOOK: _____
 NO. OF SHEETS: _____
 NO. OF THIS SHEET: _____



PROFILE
 SUBMITTED FOR REVIEW
 DATE: _____
 DRAWN BY: _____
 CHECKED BY: _____
 NOTE BOOK: _____
 NO. OF SHEETS: _____
 NO. OF THIS SHEET: _____

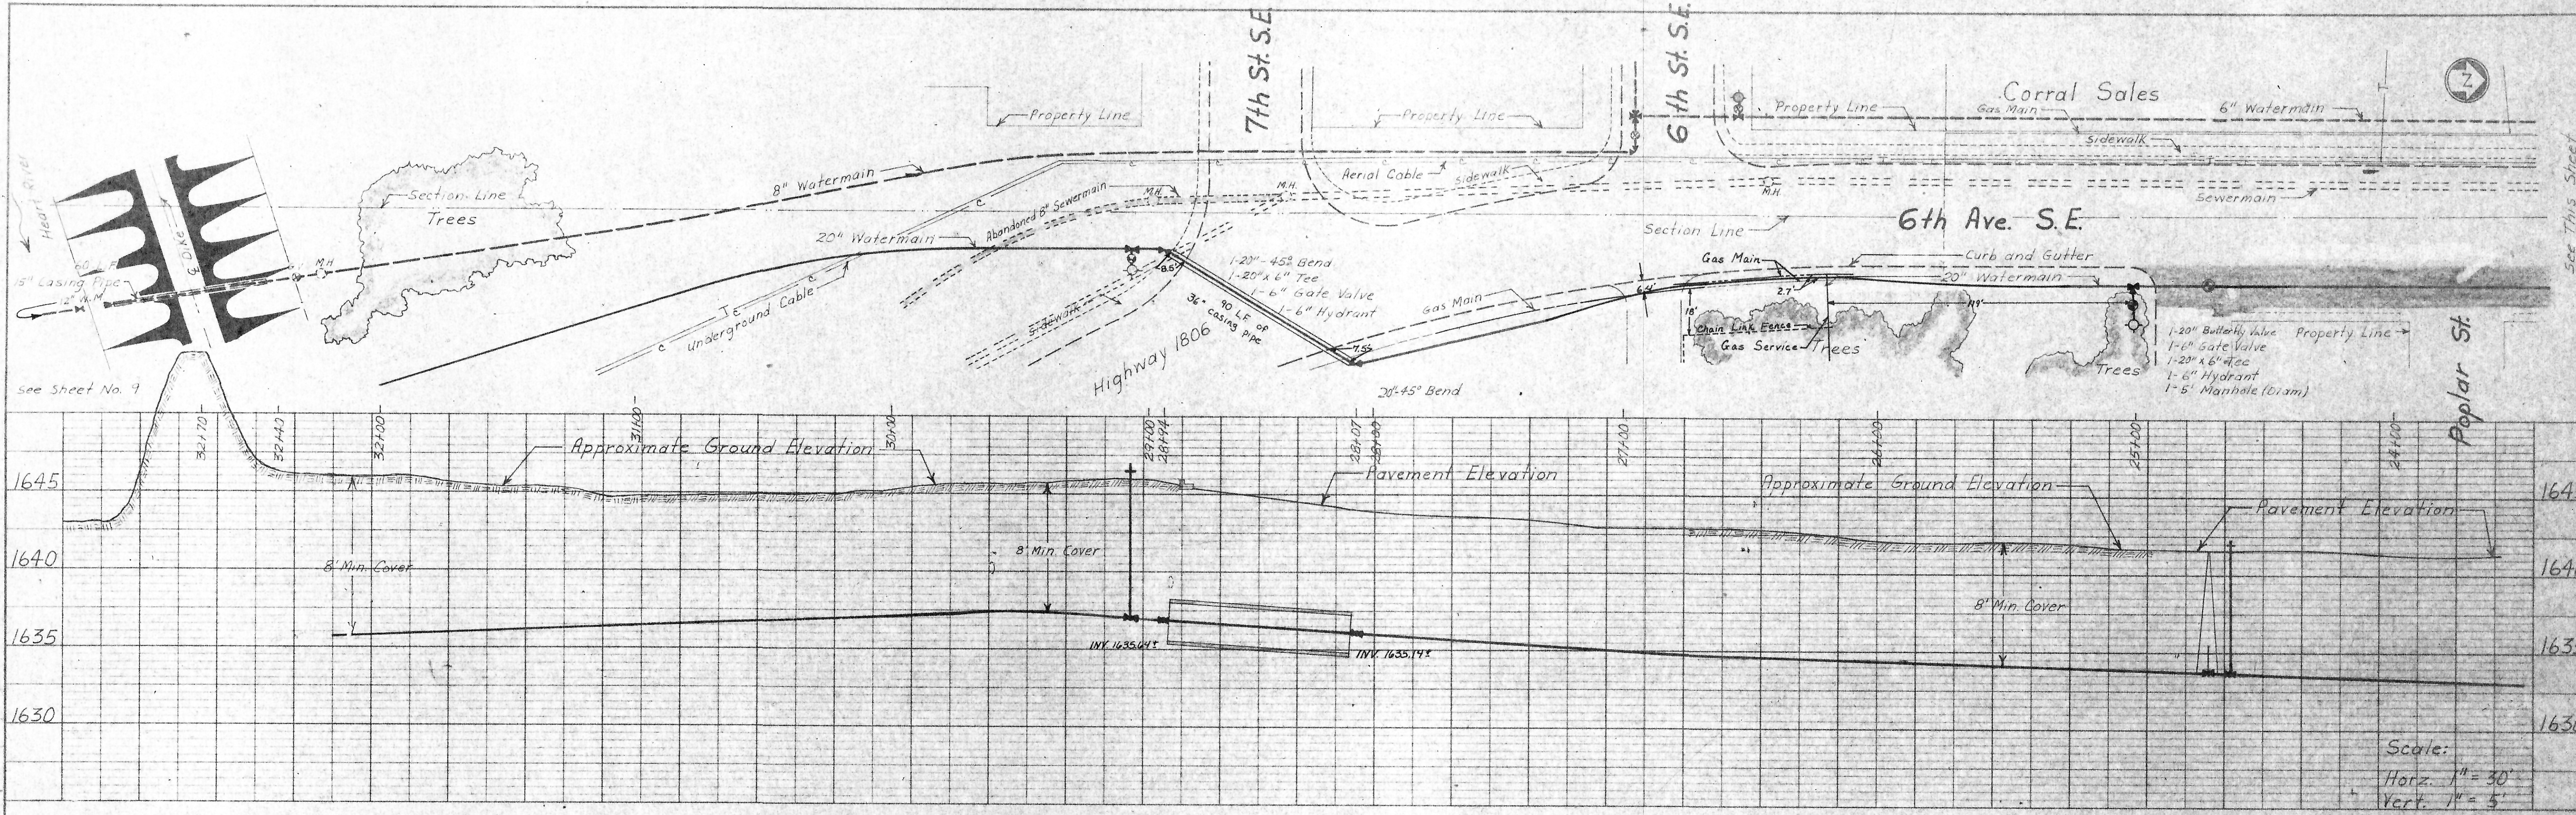