
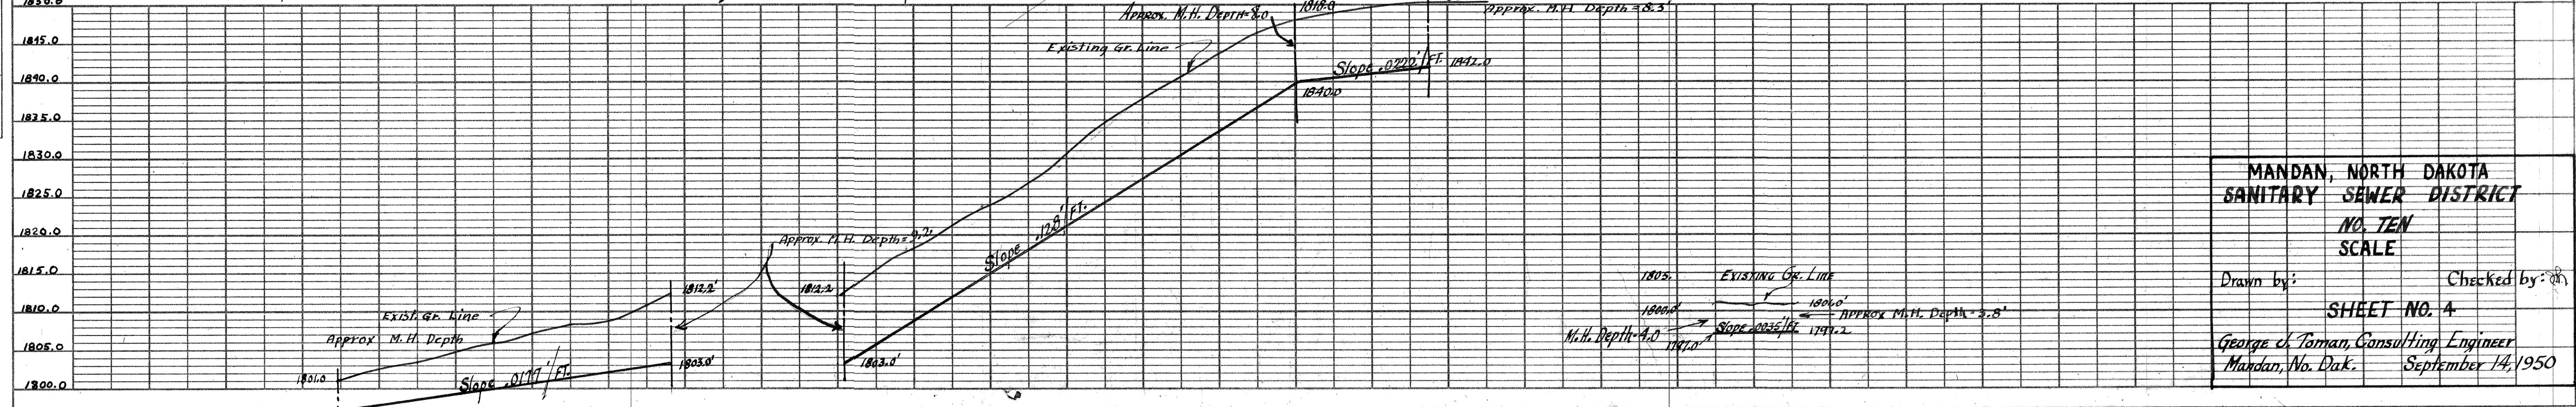
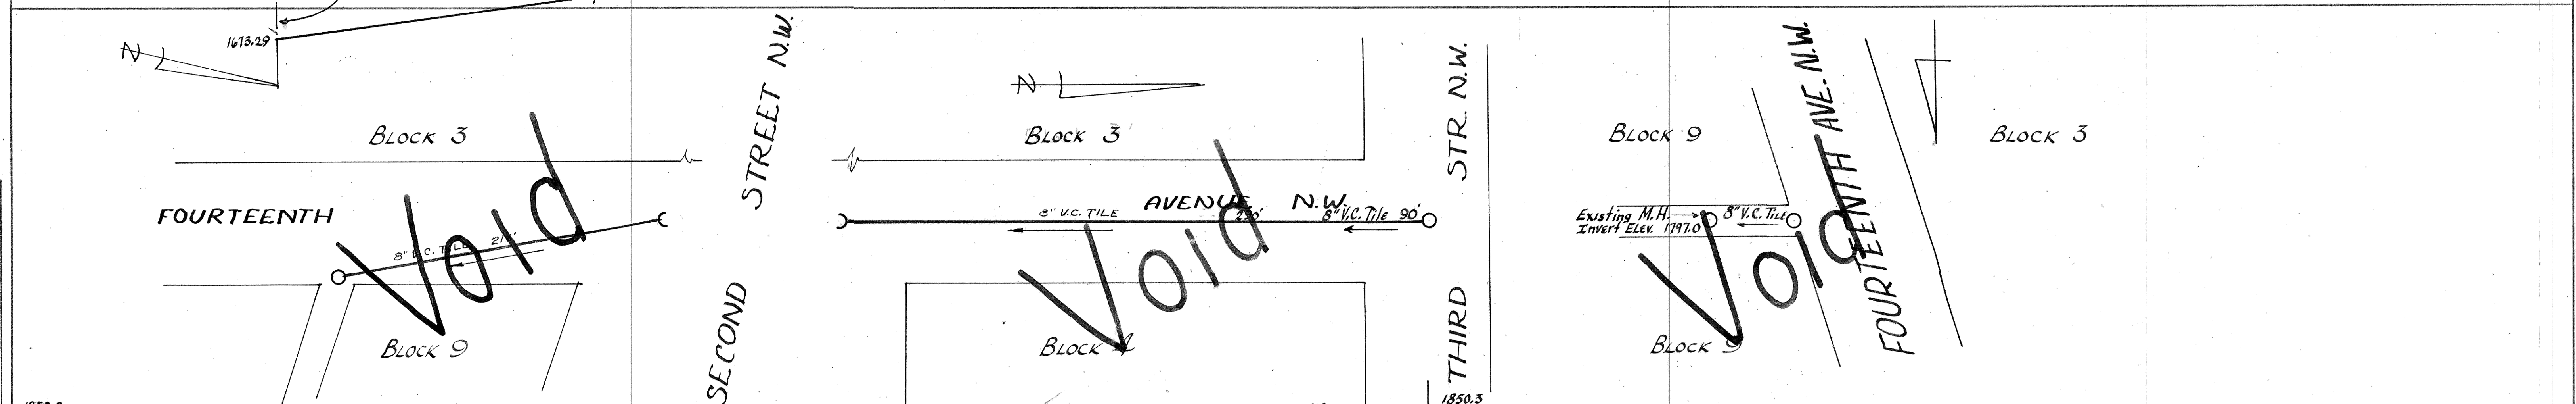
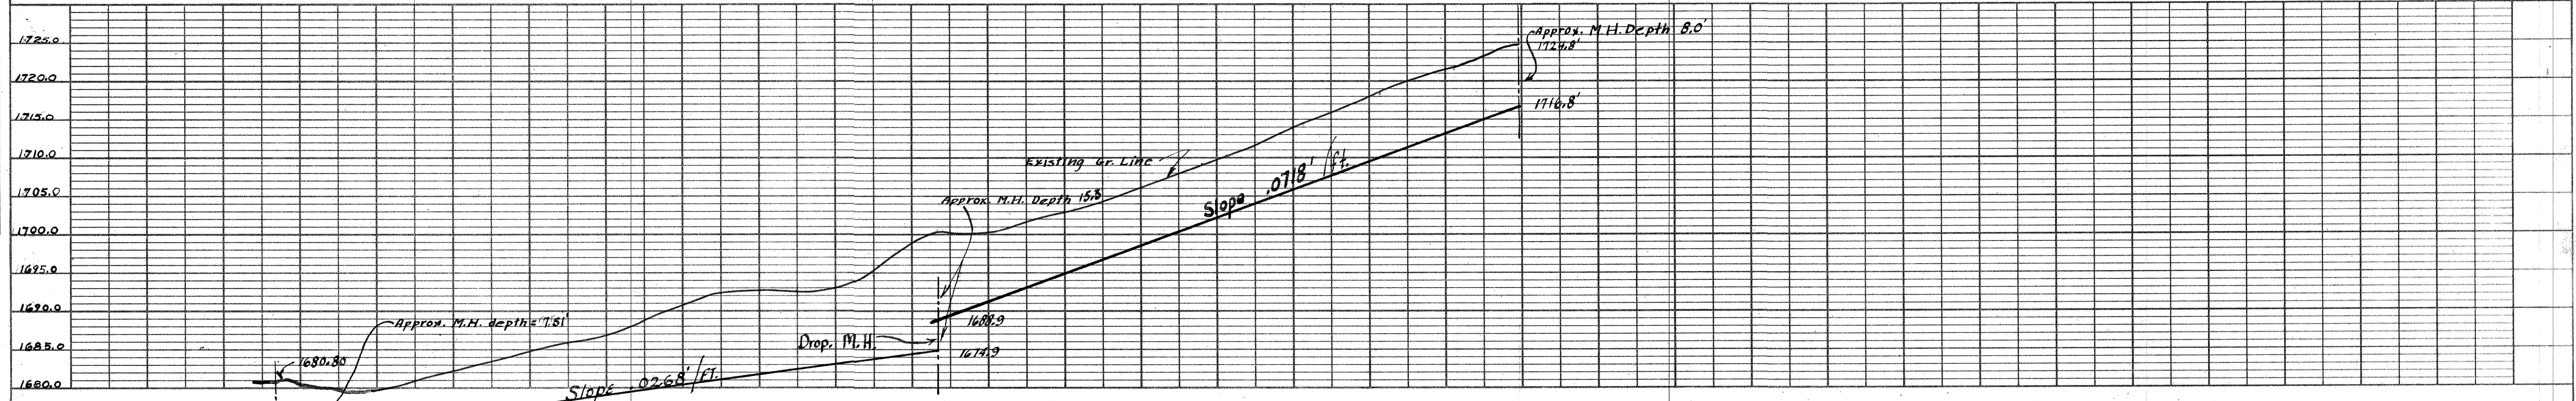


PLAN
 SURVEYED, PLOTTED, ALIGNED, CHECKED, REVISIONS CHECKED, NO. 1

PROFILE
 SURVEYED, PLOTTED, GRADES CHECKED, STRUCTURE NOTATIONS CHECKED, NO. 1

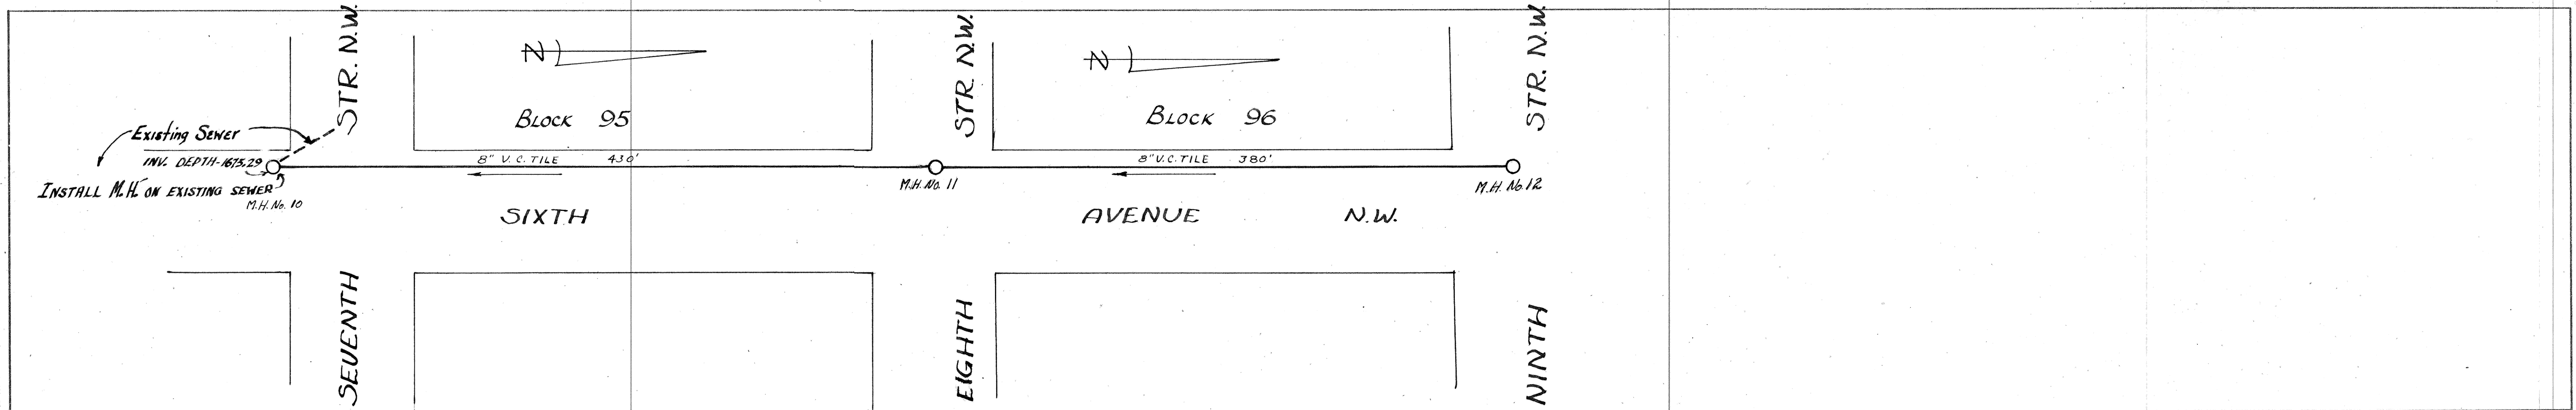

MANDAN, NORTH DAKOTA
 SANITARY SEWER DISTRICT
 NO. TEN
 SCALE

Drawn by: _____ Checked by: _____

SHEET NO. 4

George C. Toman, Consulting Engineer
 Mandan, No. Dak. September 14, 1950