
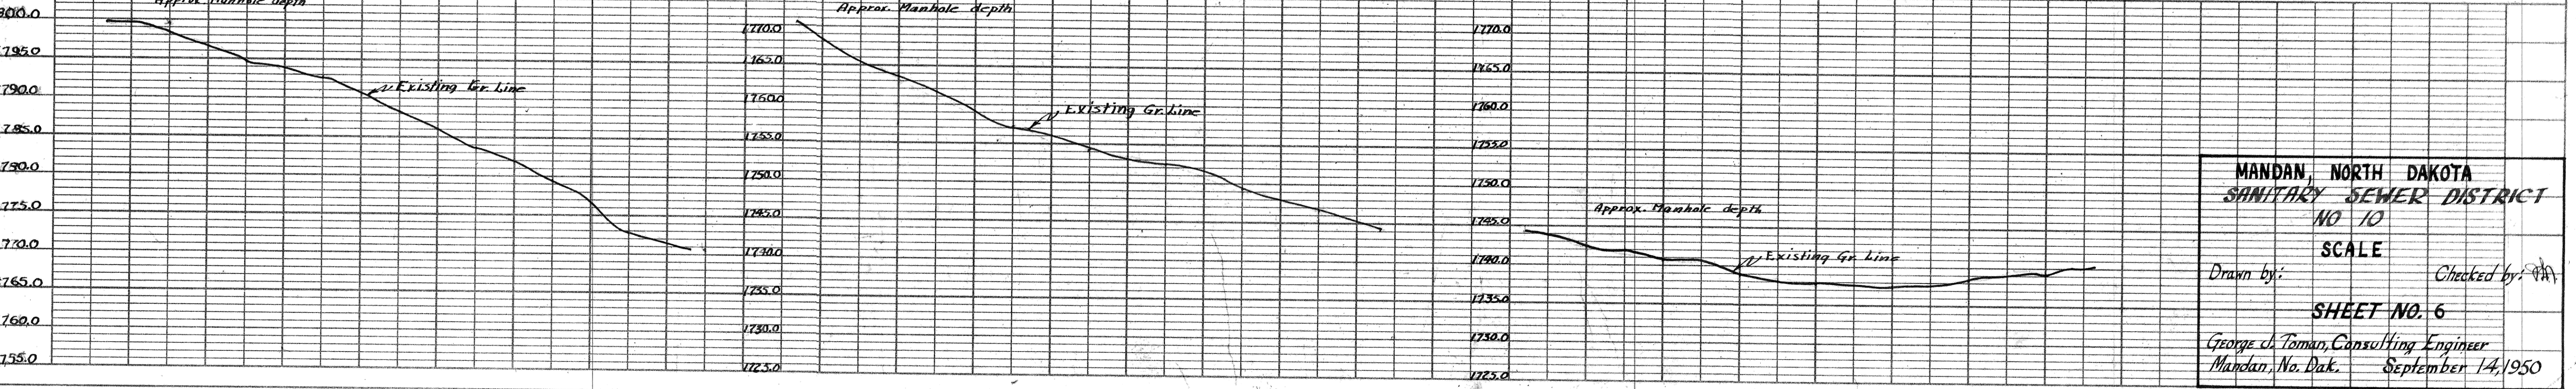
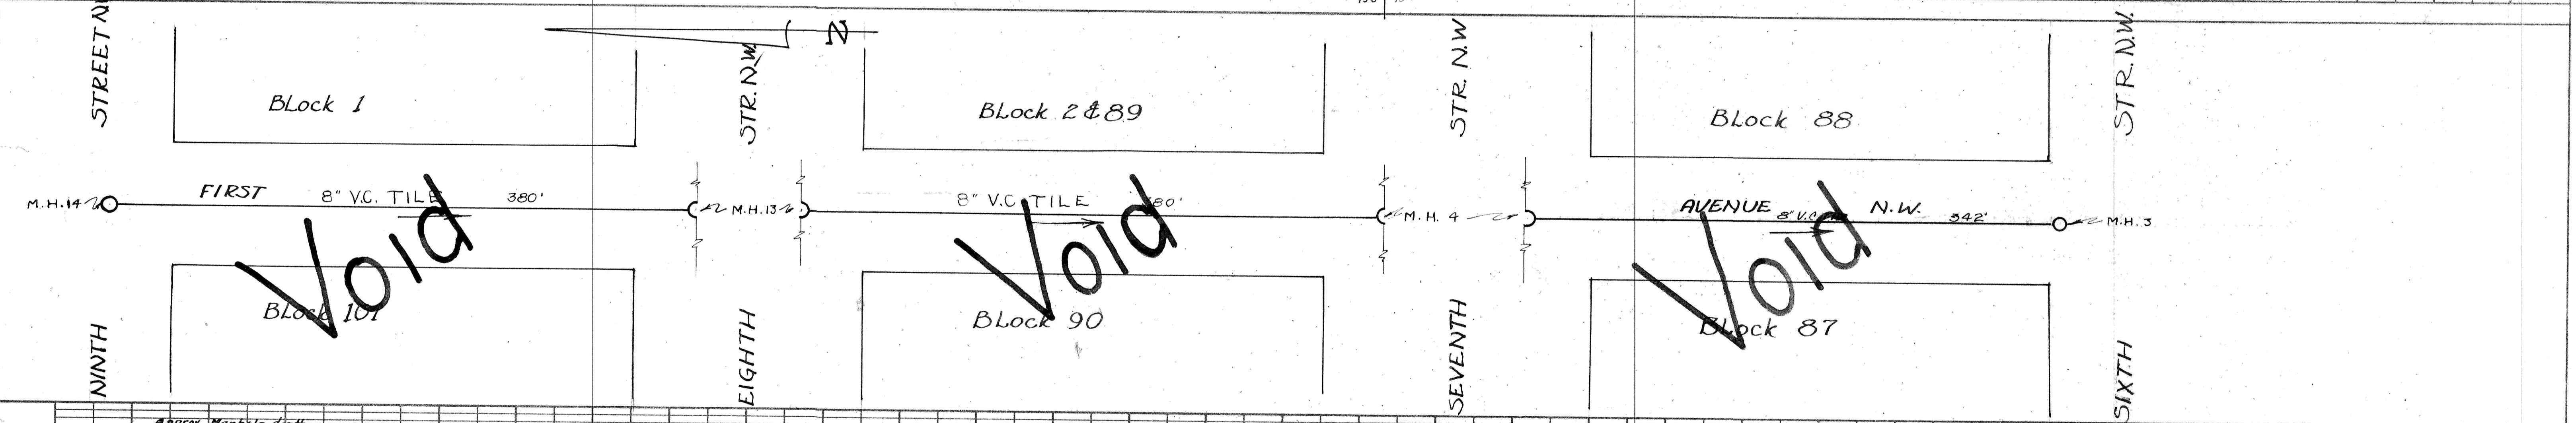
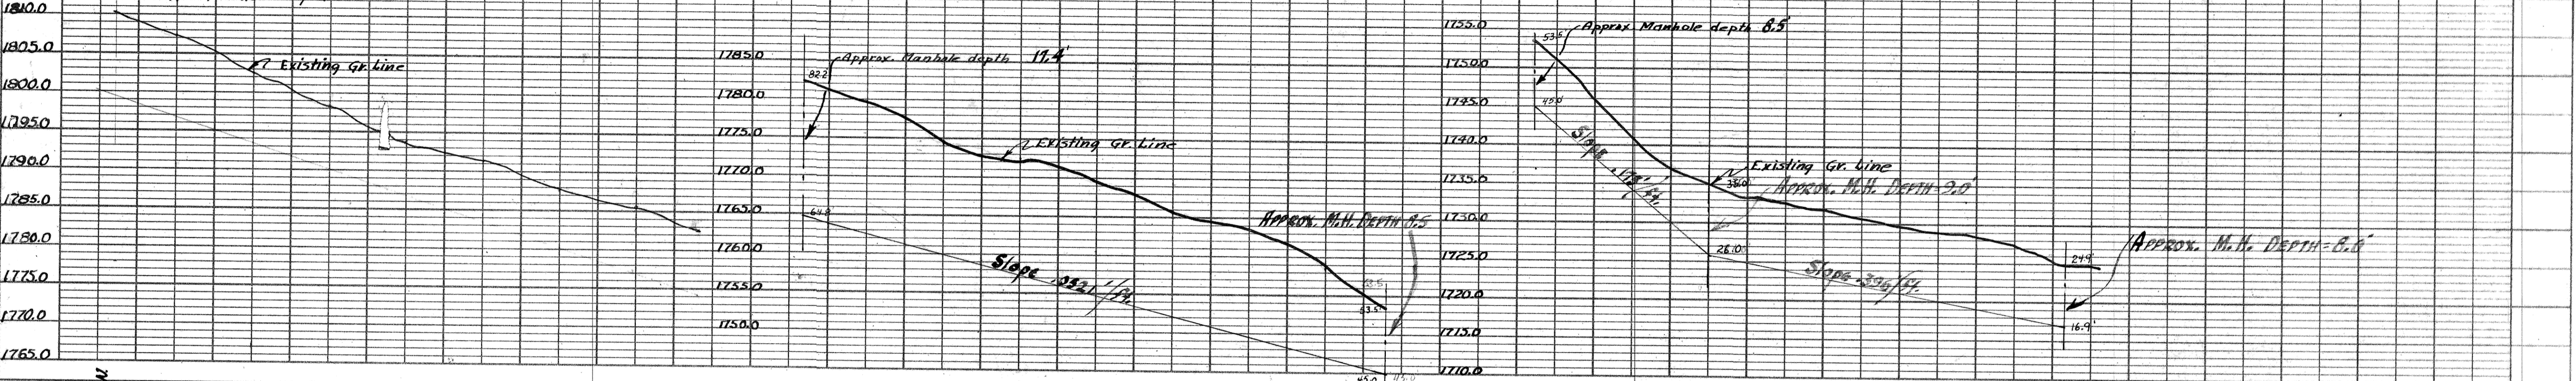


PLAN  
 SURVEYED  
 NOTE BOOK  
 PLOTTED  
 ALIGNMENT CHECKED  
 FIT OF WAY CHECKED  
 No.

PROFILE  
 SURVEYED  
 NOTE BOOK  
 GRADES CHECKED  
 B. M.'S. NOTED  
 STRUCTURE NOTATIONS CHECKED  
 No.

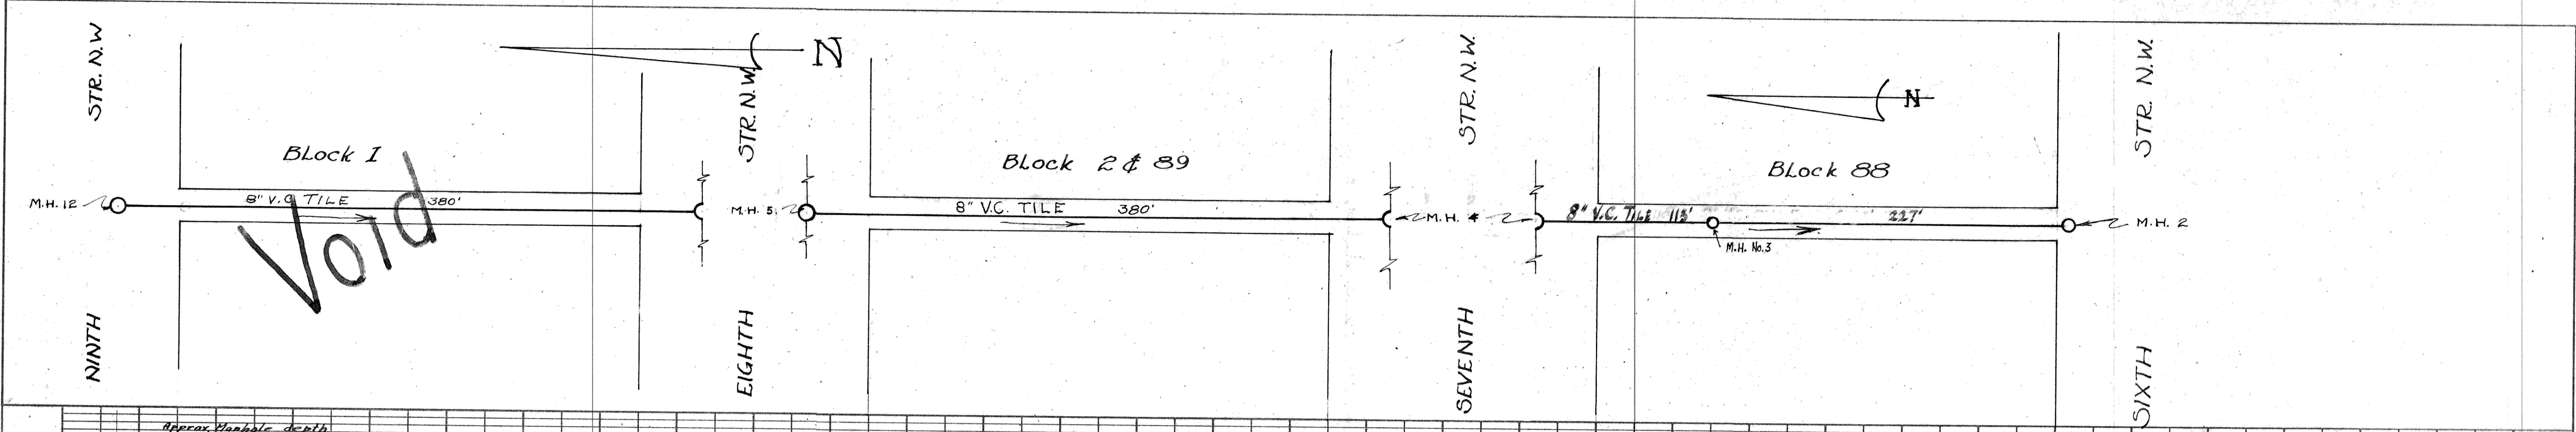

MANDAN, NORTH DAKOTA  
 SANITARY SEWER DISTRICT  
 NO 10  
 SCALE  
 SHEET NO. 6  
 Drawn by: *[Signature]* Checked by: *[Signature]*  
 George J. Toman, Consulting Engineer  
 Mandan, No. Dak. September 14, 1950