

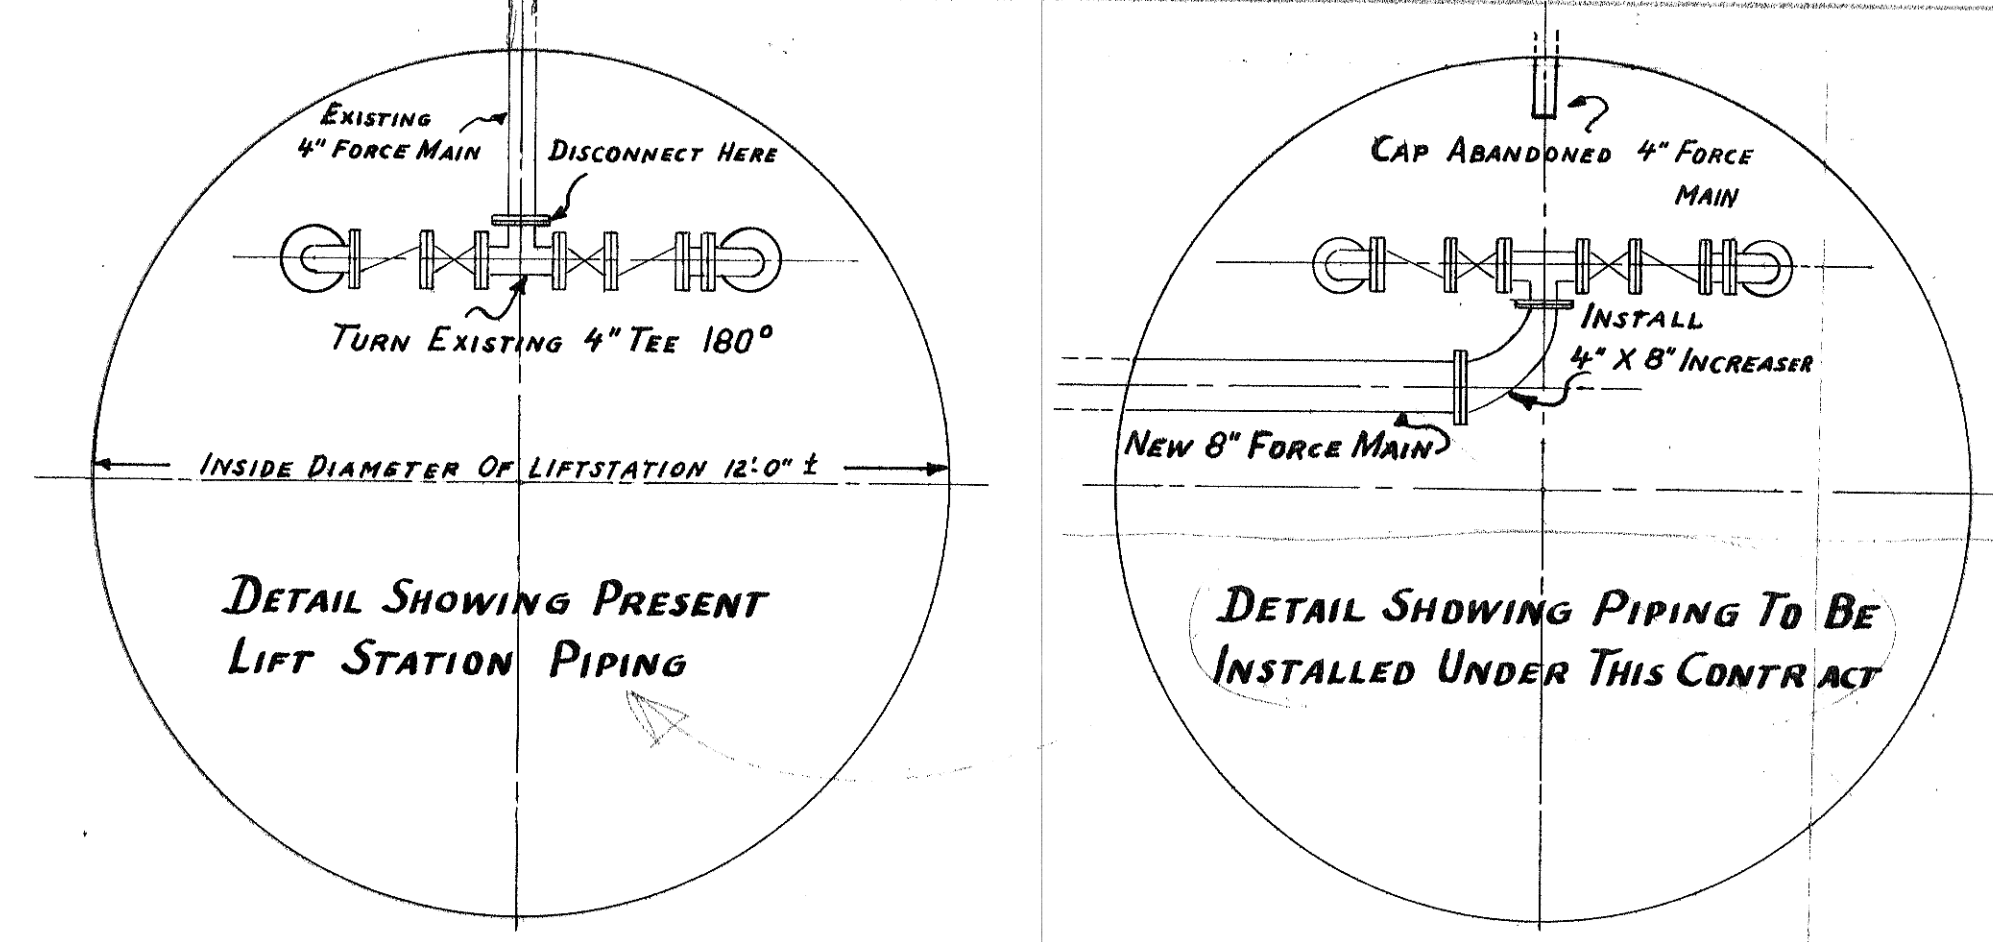
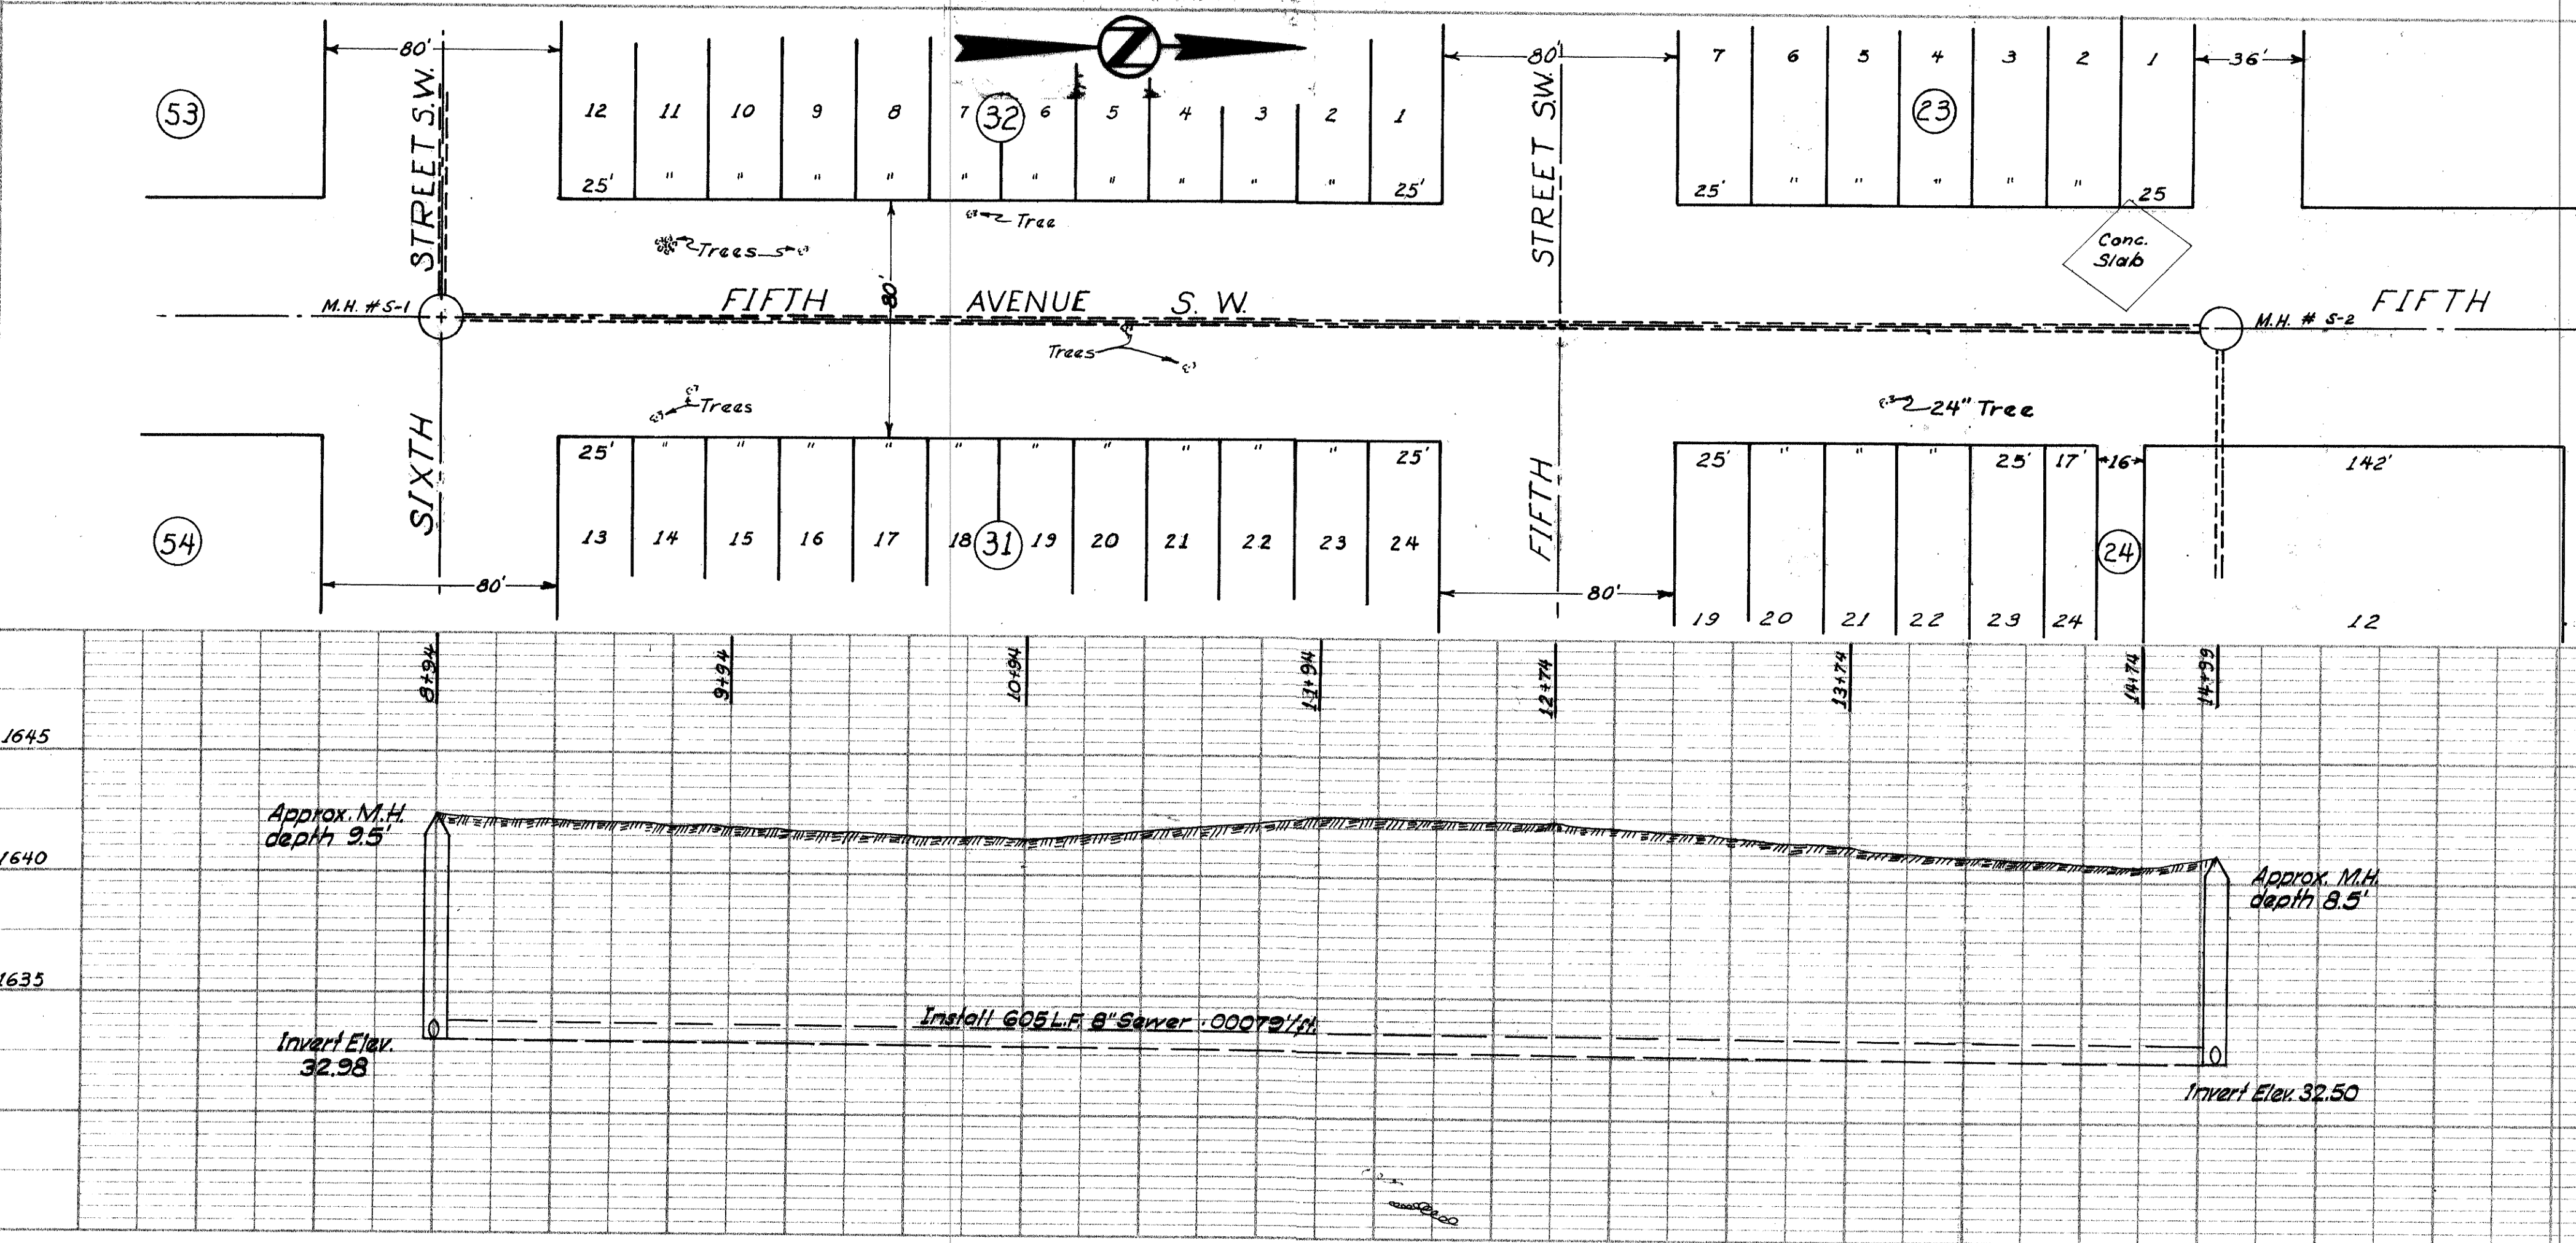


PLAN
 SURVEYED BY
 PLOTTED BY
 CHECKED BY
 DATE
 NOTE BOOK NO.
 ALUMINUM CHECKED BY
 AT OR BY CHECKED BY
 NO. STRUCTURE NOTATIONS CHECKED BY

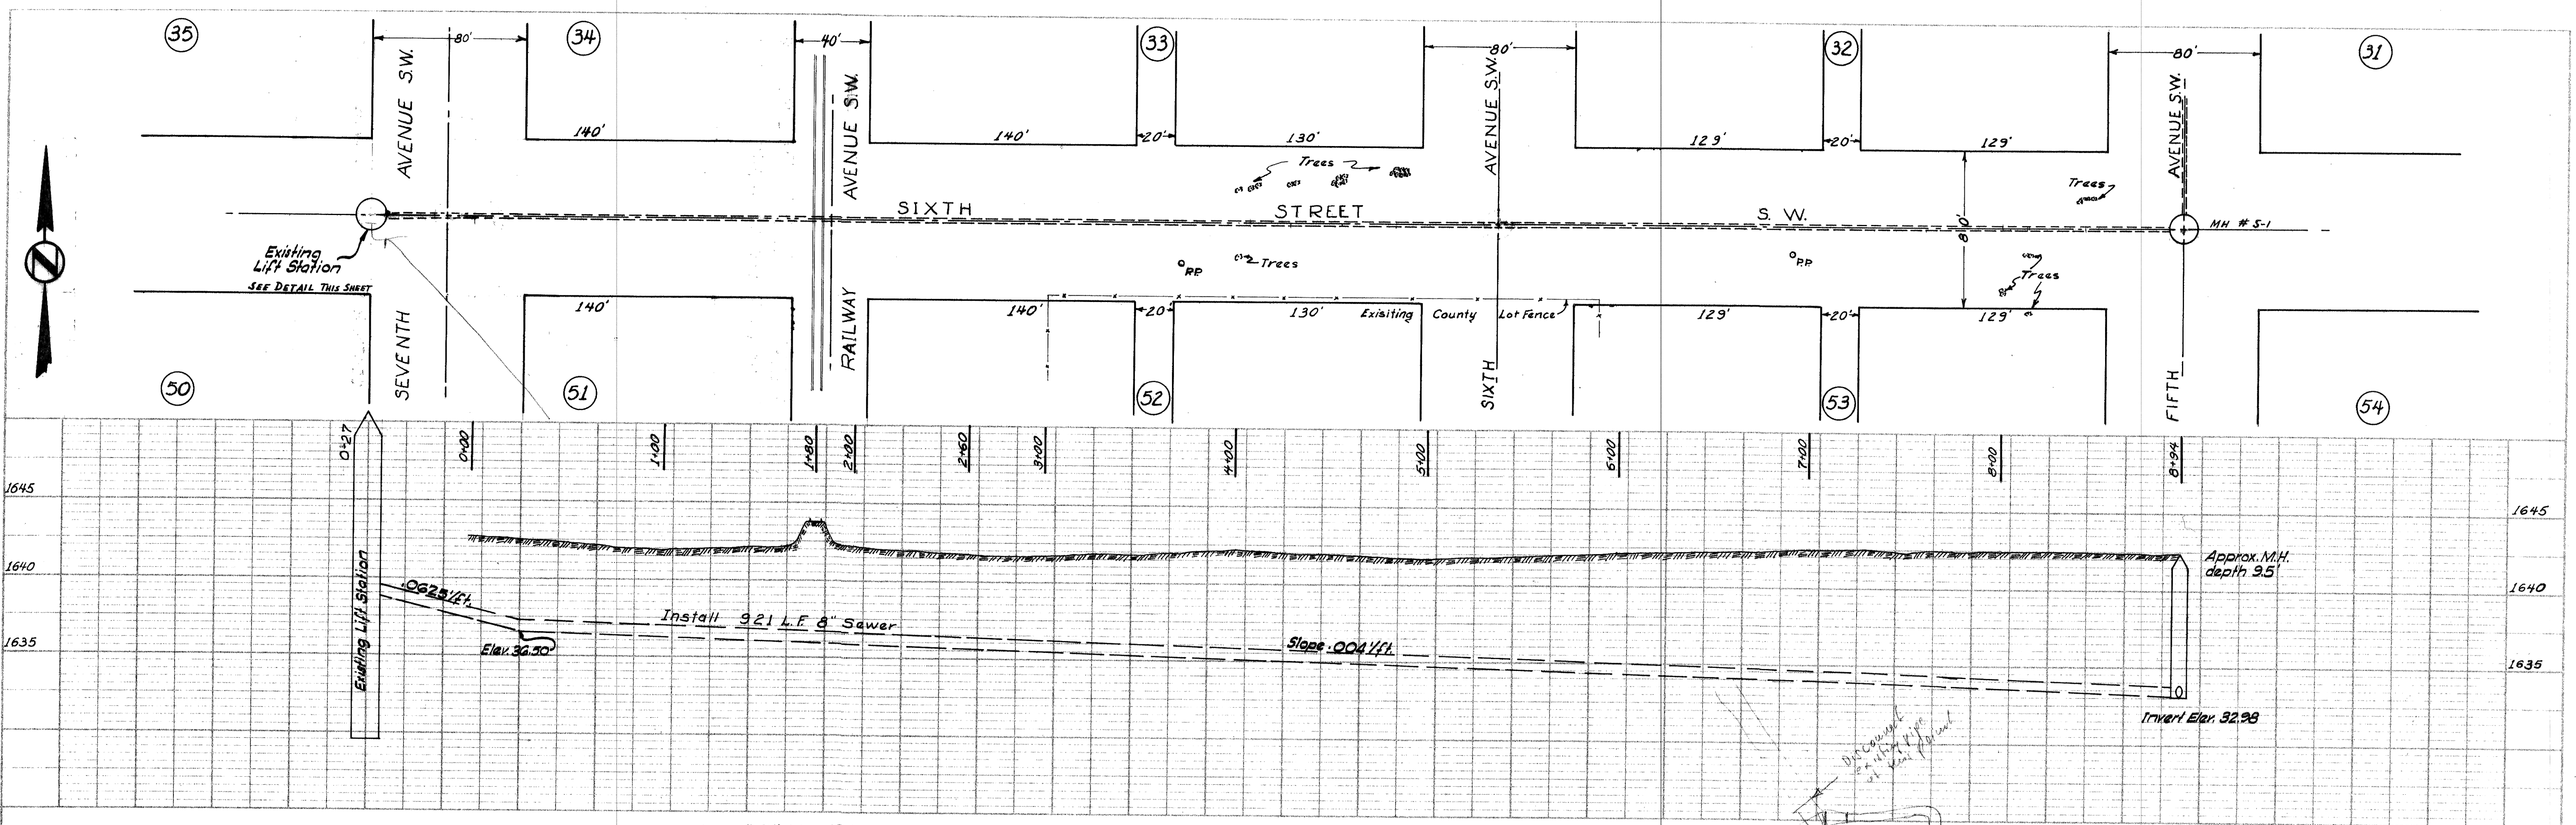

LIFT STATION MODIFICATION AT 7th AVE. & 6th ST. S.W.

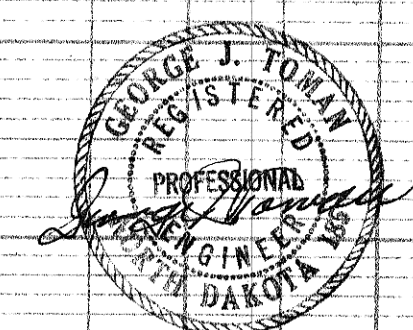

TOMAN ENGINEERING COMPANY
 CONSULTING ENGINEERS
 P.O. BOX 400
 MANDAN, NORTH DAKOTA 58554