

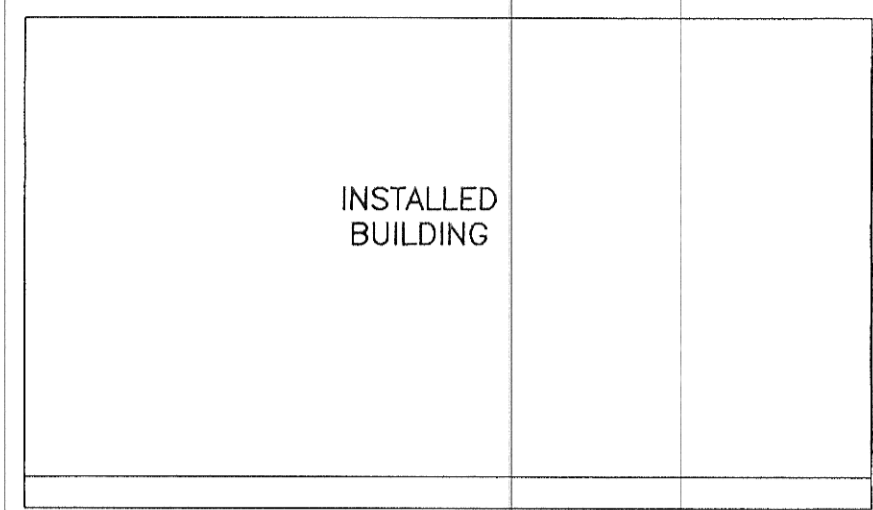



INSTALLED STRUCTURES

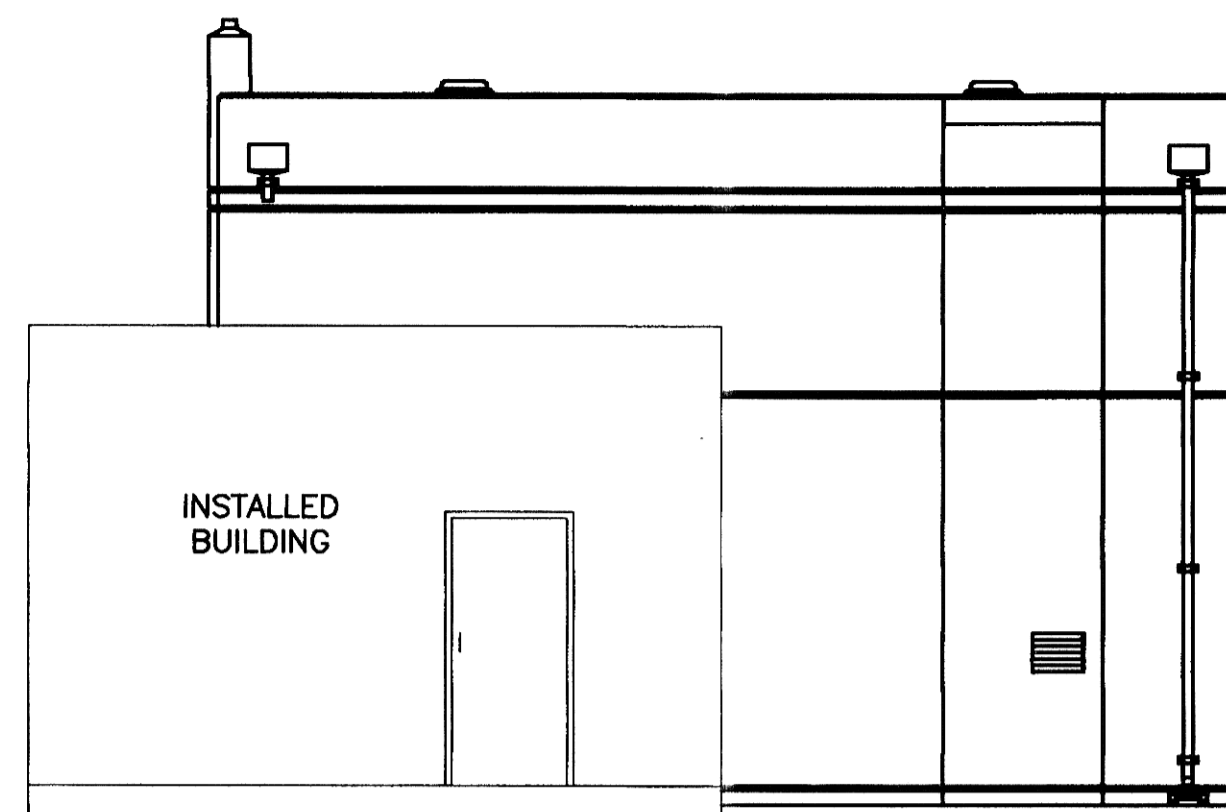




SOUTH LAYOUT

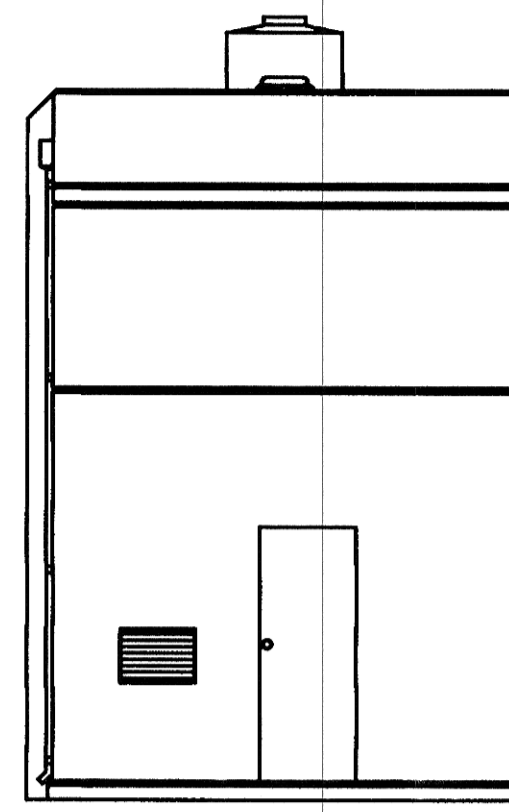

EAST LAYOUT

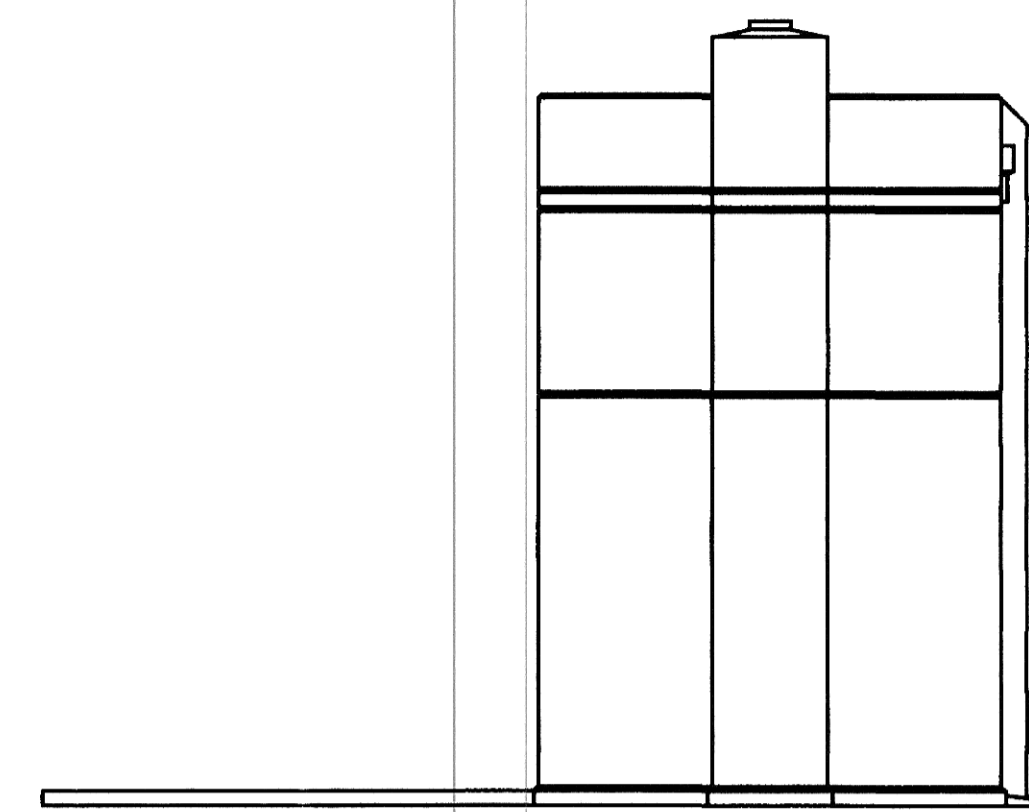

NORTH LAYOUT

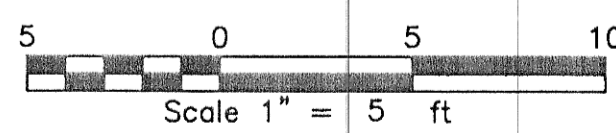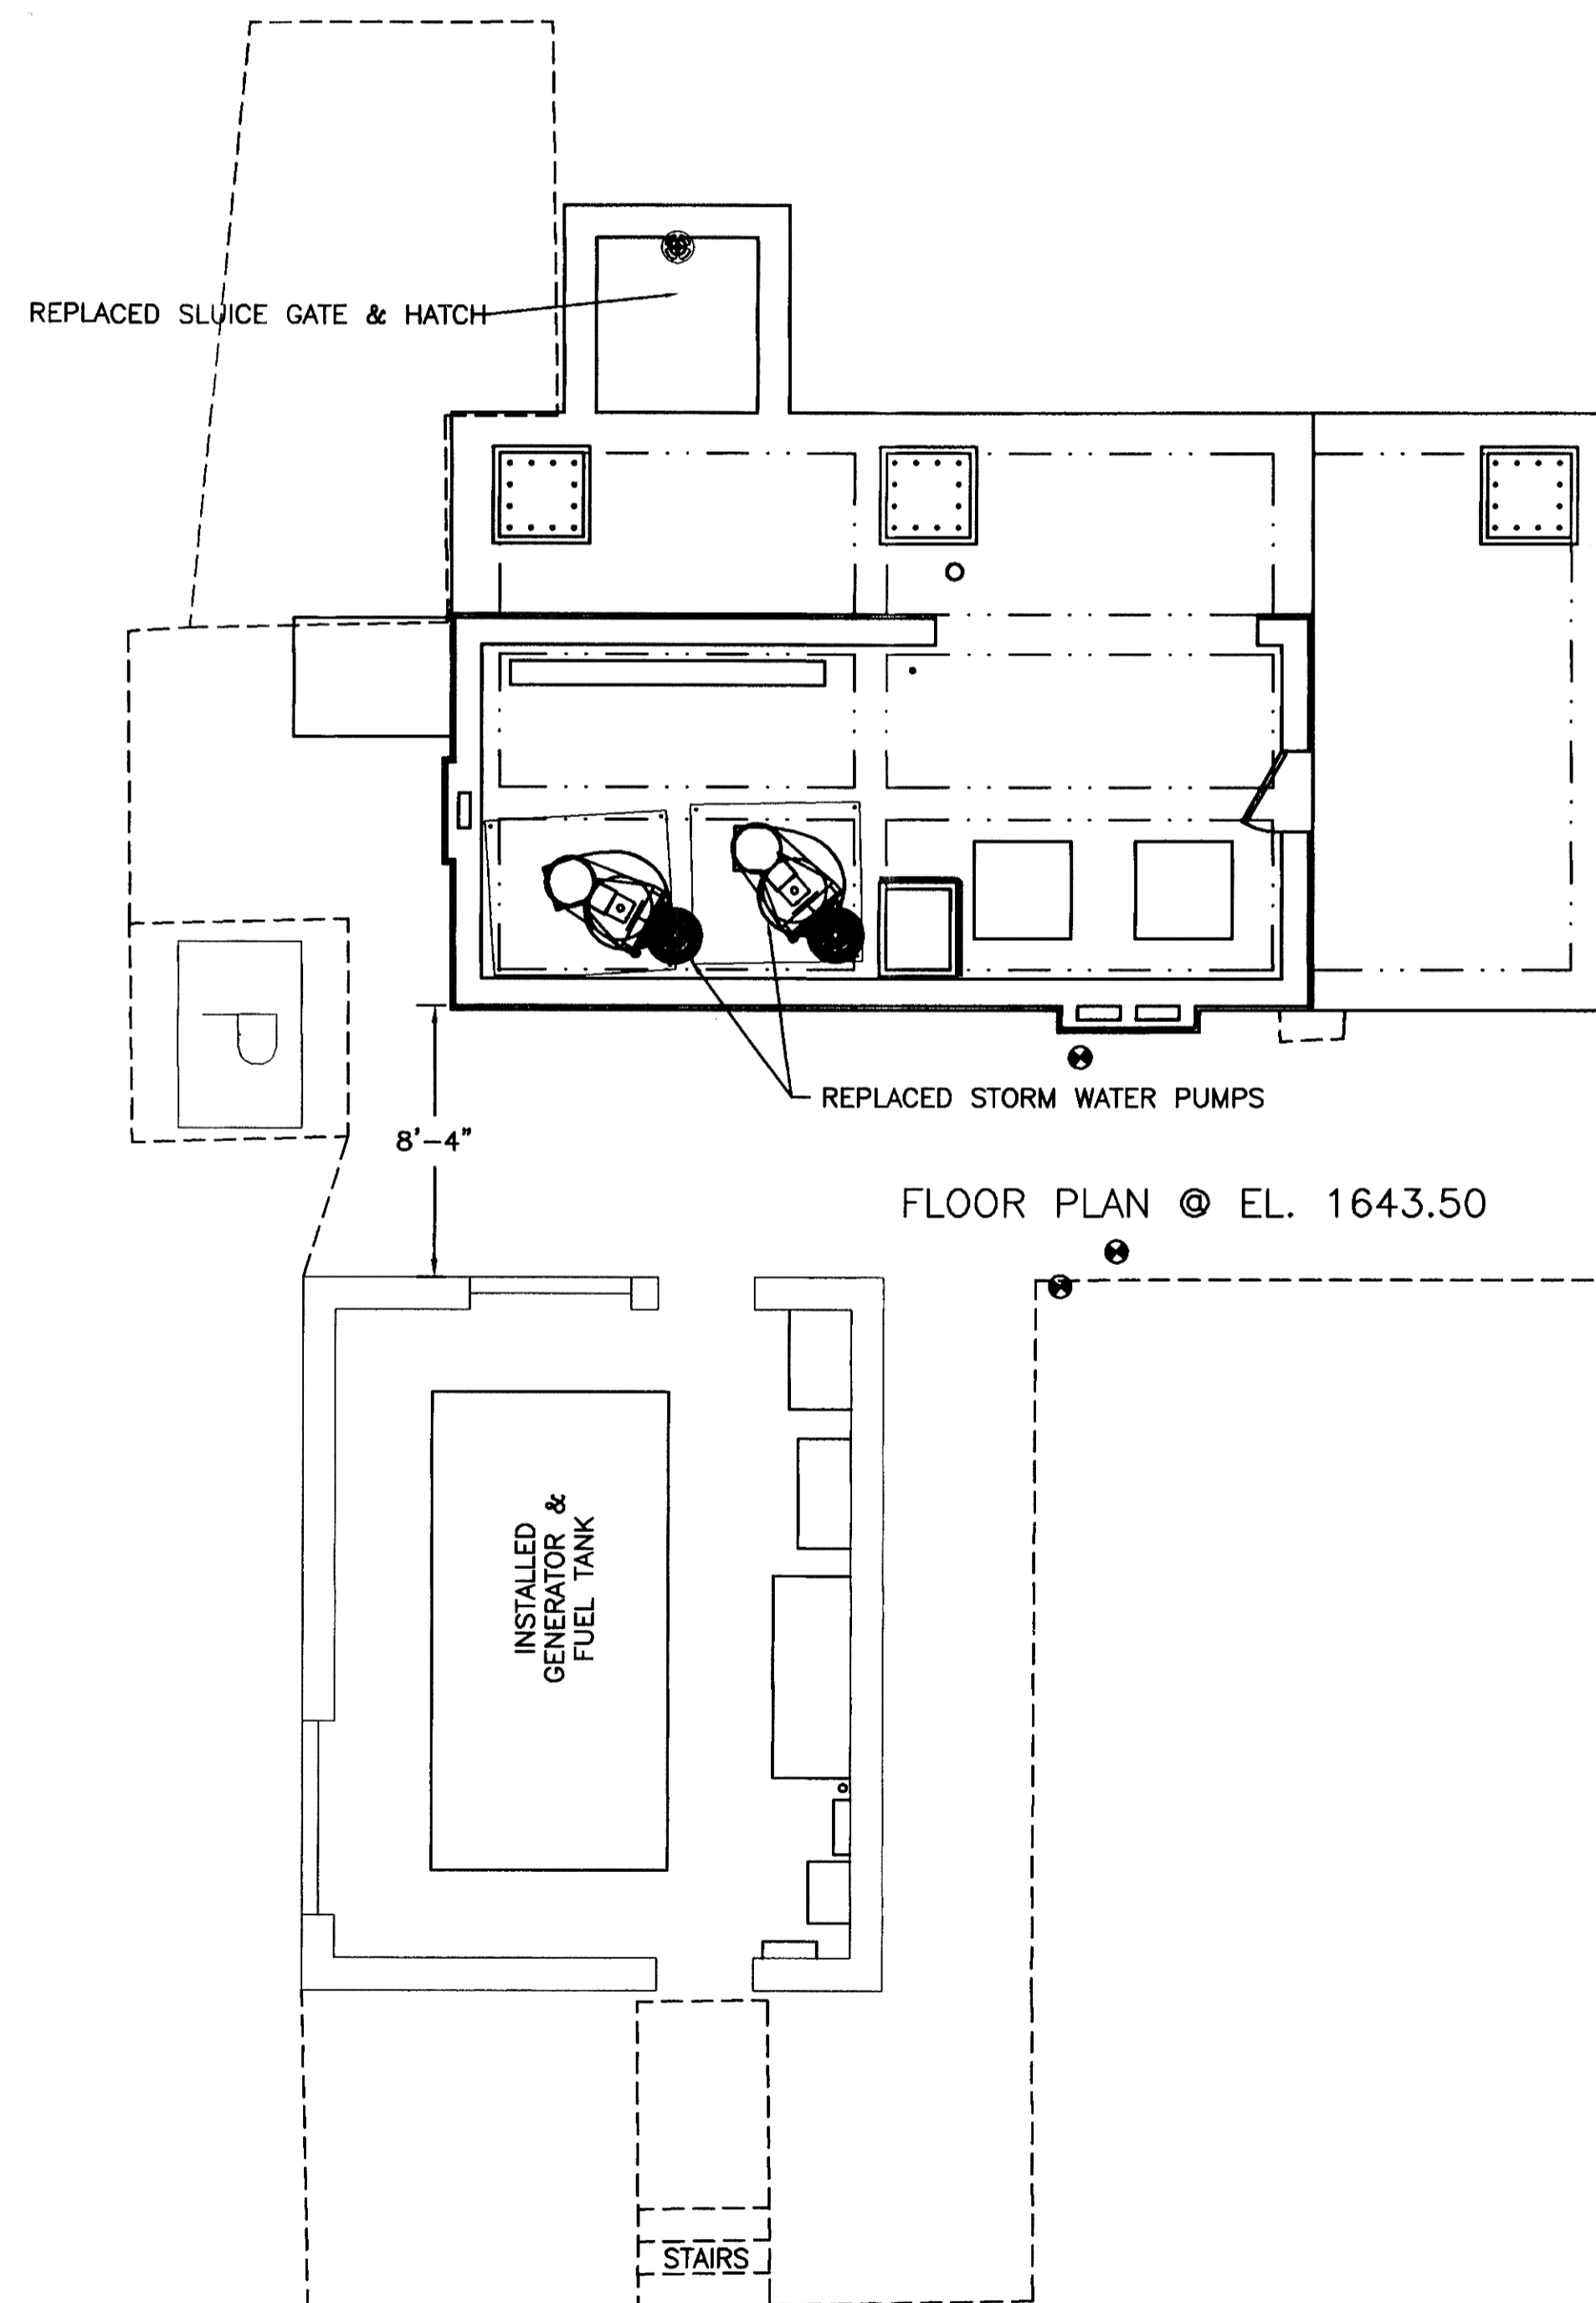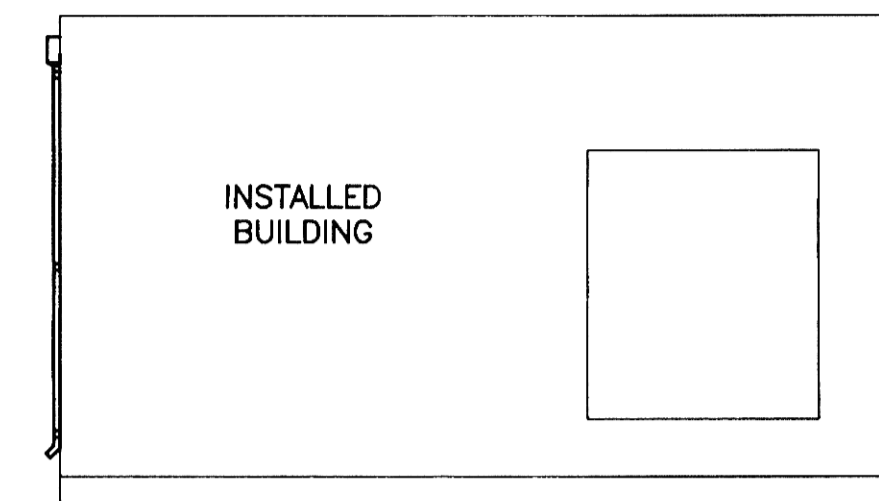

AVOID CUTTING UNDERGROUND UTILITY LINES IN YOUR AREA

TWO WORKING DAYS BEFORE YOU DIG-DRILL-BLAST IN NORTH DAKOTA - CALL TOLL FREE 1-800-795-0555

UTILITIES UNDERGROUND LOCATION CENTER



PROJECT: STANDBY GENERATOR & BUILDING REPLACEMENT
STORM WATER PUMP REPLACEMENT
INSTALLED STRUCTURES

NO.	DATE	BY	REVISIONS
1	7/24/2000	RM	ISSUE FOR PERMITS
2	9/7/2001	RM	REVISED PER COMMENTS
3	9/7/2001	RM	REVISED PER COMMENTS

TITLE: STORM WATER PUMP REPLACEMENT

SHEET NUMBER

4

OF 17 SHEETS



TOMAN ENGINEERING COMPANY
CONSULTING CIVIL ENGINEERS
908 2ND ST. N.W. • GRANDFORD, NORTH DAKOTA 58854 • 701-683-6483