
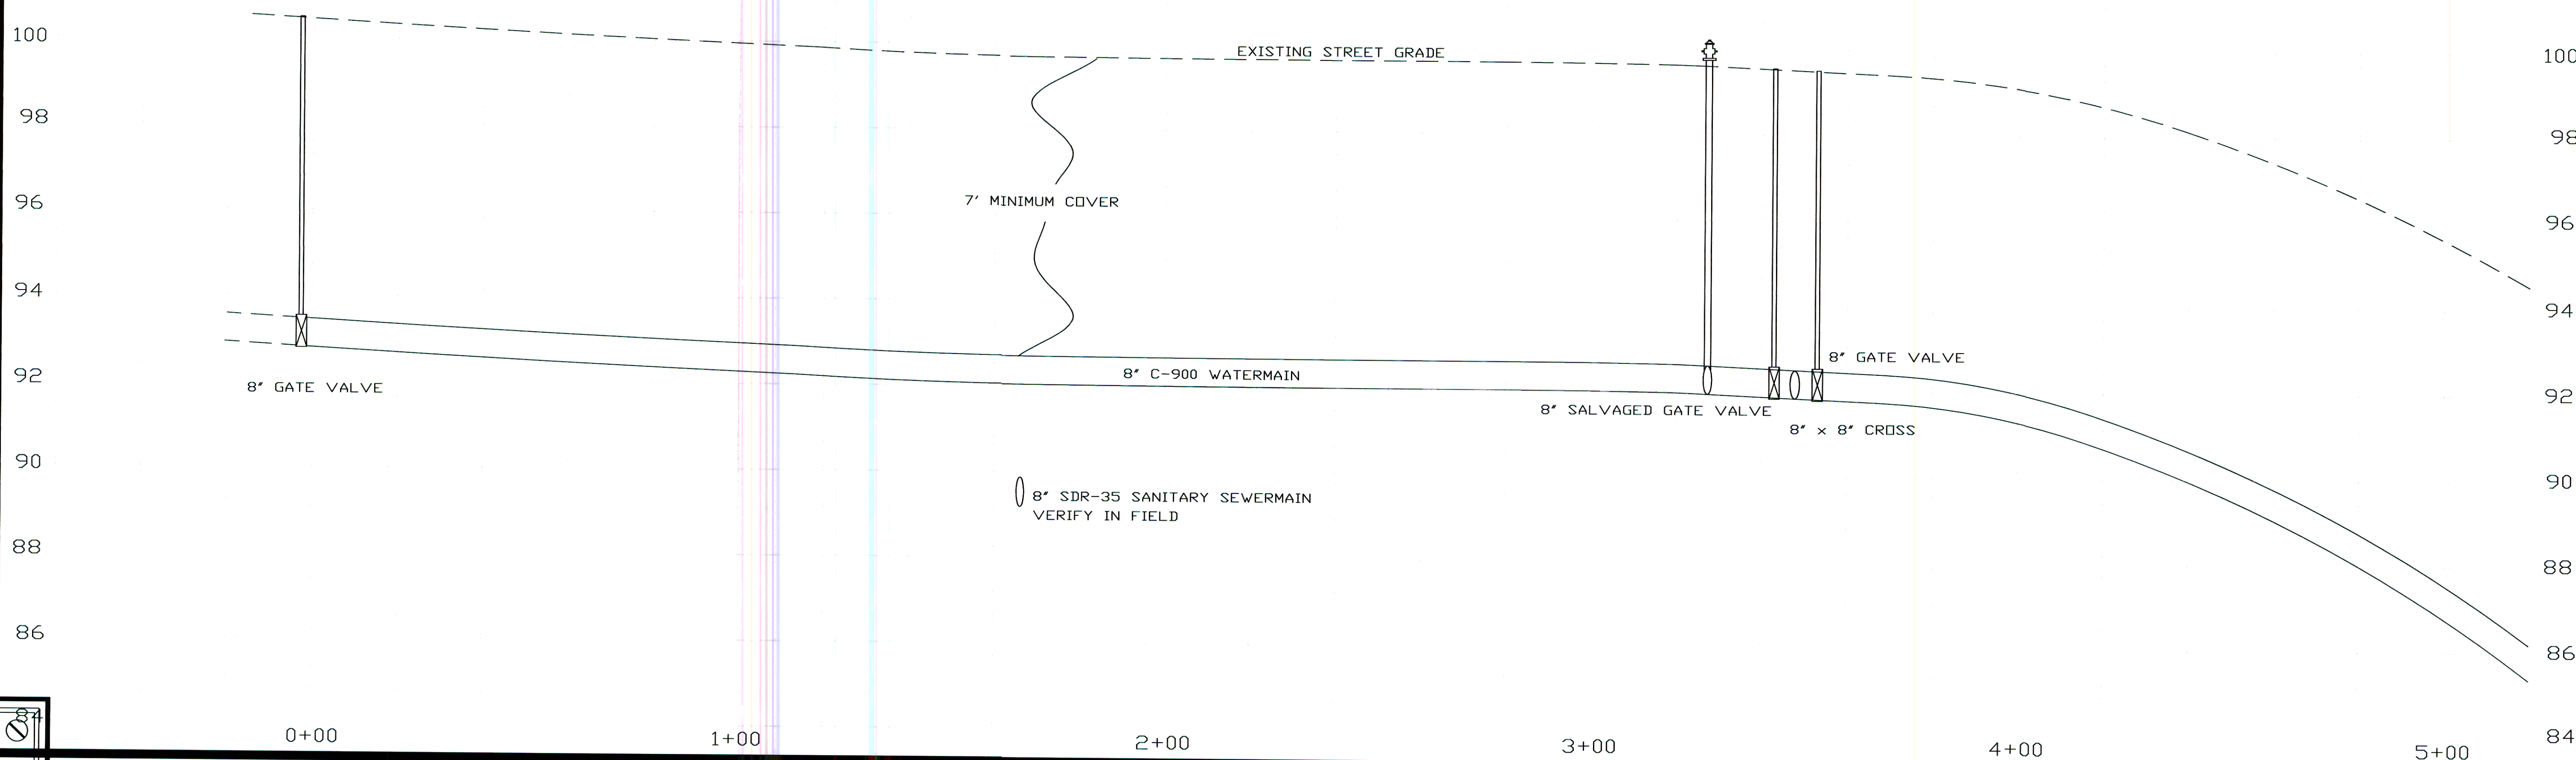


SEE SHEET 2 OF 8

--- Warning --- All utilities are to be located before digging.
Overhead utilities may be present.

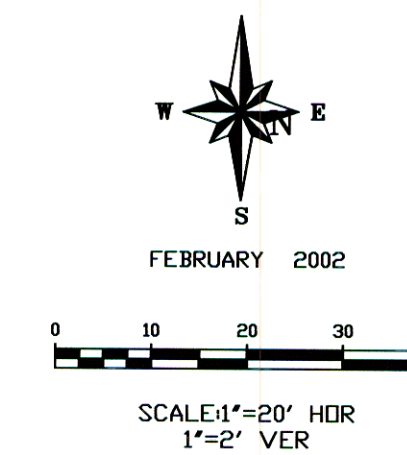

City Eng. T LITTLE	Drawn By: J L W	Description	Checked By
	Approved By: T R L		Abuilt
Project No. 2002-03	Date: 2/5/2002	Date	10/02
District No. N/A	Scale: AS SHOWN	Drawn By	jlw

City of Mandan

Watermain Replacement Project 2002-03
2ND ST NW - FROM 12TH AVE TO 11TH AVE