
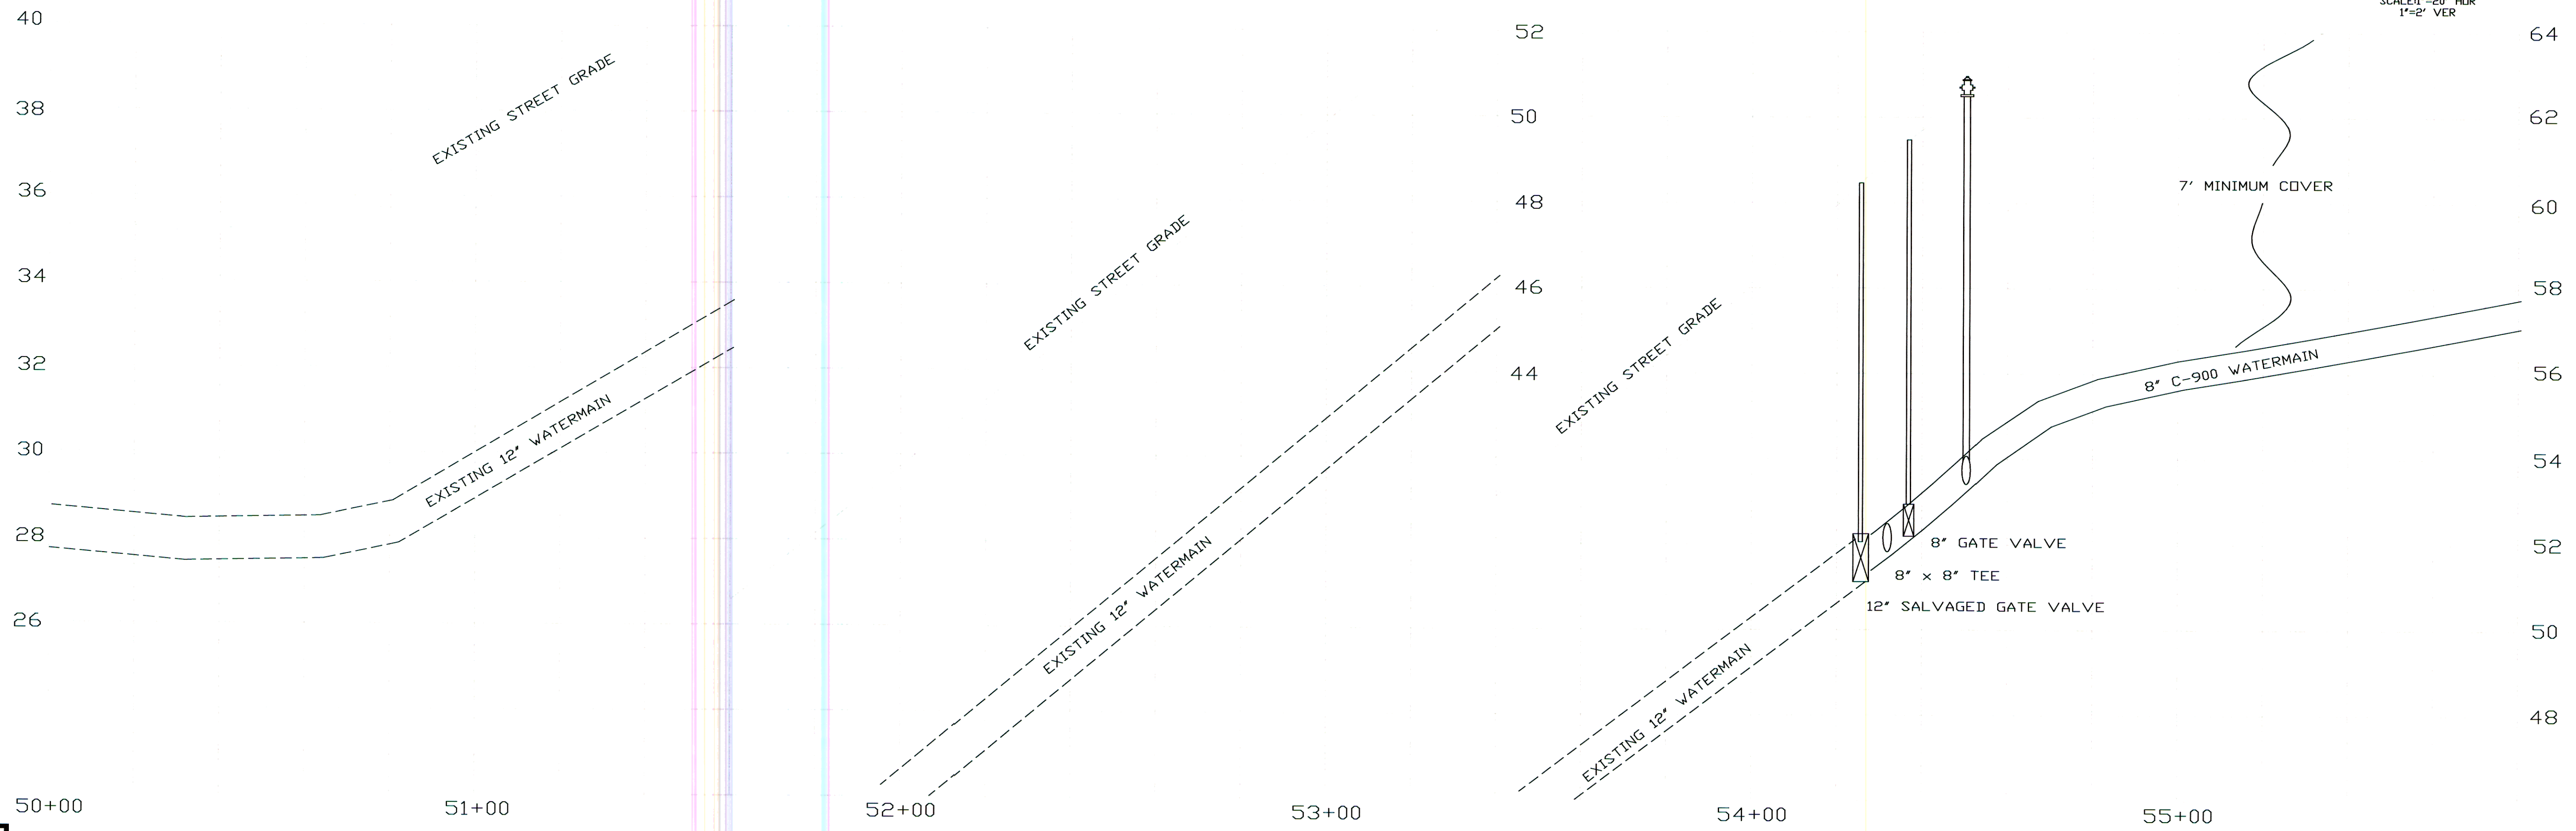


SEE SHEET 6 OF 8

--- Warning --- All utilities are to be located before digging.
Overhead utilities may be present.

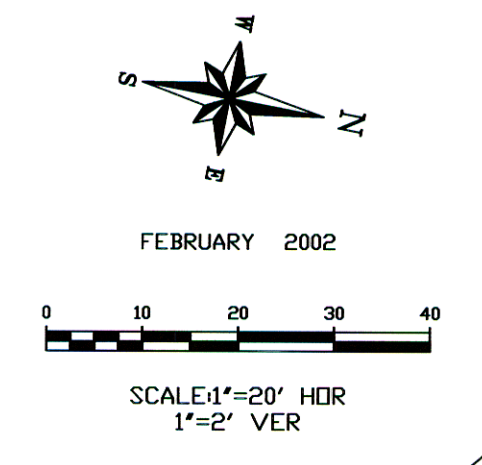

City of Mandan		Watermain Replacement Project 2002-03 7TH AVE NW - FROM 1ST ST TO 2ND ST	
City Eng. T LITTLE	Drawn By: J L W	Description	Asbuilt
Approved By: T R L	Checked By: T R L	Date	10/02
Project No. 2002-03	Date: 2/5/2002	Drawn By	jlw
District No. N/A	Scale: AS SHOWN	Checked By	jlw