


Record Drawing

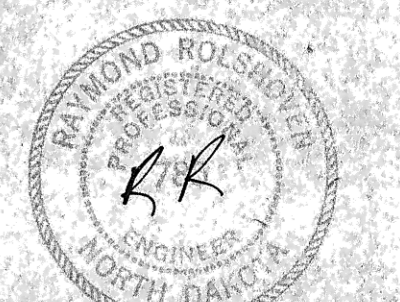

Record Drawing

PHASE 2

REV.	DATE	DESCRIPTION	BY
△			
△			
△			
△			

MANDAN INTERCEPTOR 1983 MANDAN, NORTH DAKOTA		
LOCATION MAP		
ULTEIG ENGINEERS, INC. CONSULTING ENGINEERS & ARCHITECT FARGO • BISMARCK • MINNEAPOLIS		
DRAWN BY: D.J.M.	SCALE: AS SHOWN	PROJECT NO. 4160.01
CHECKED BY: SD	DATE: AUGUST 1983	SHEET 2 of 20
APPROVED BY: RR		

