




DATE	
BY	
SURVEYED	
PLANNED	
NOTED	
ALIGNED	
AS BUILT	
NO.	

DATE	
BY	
SURVEYED	
PLANNED	
NOTED	
ALIGNED	
AS BUILT	
NO.	

NOTE: Property owners of 407 & 409 connected to stubouts Privately

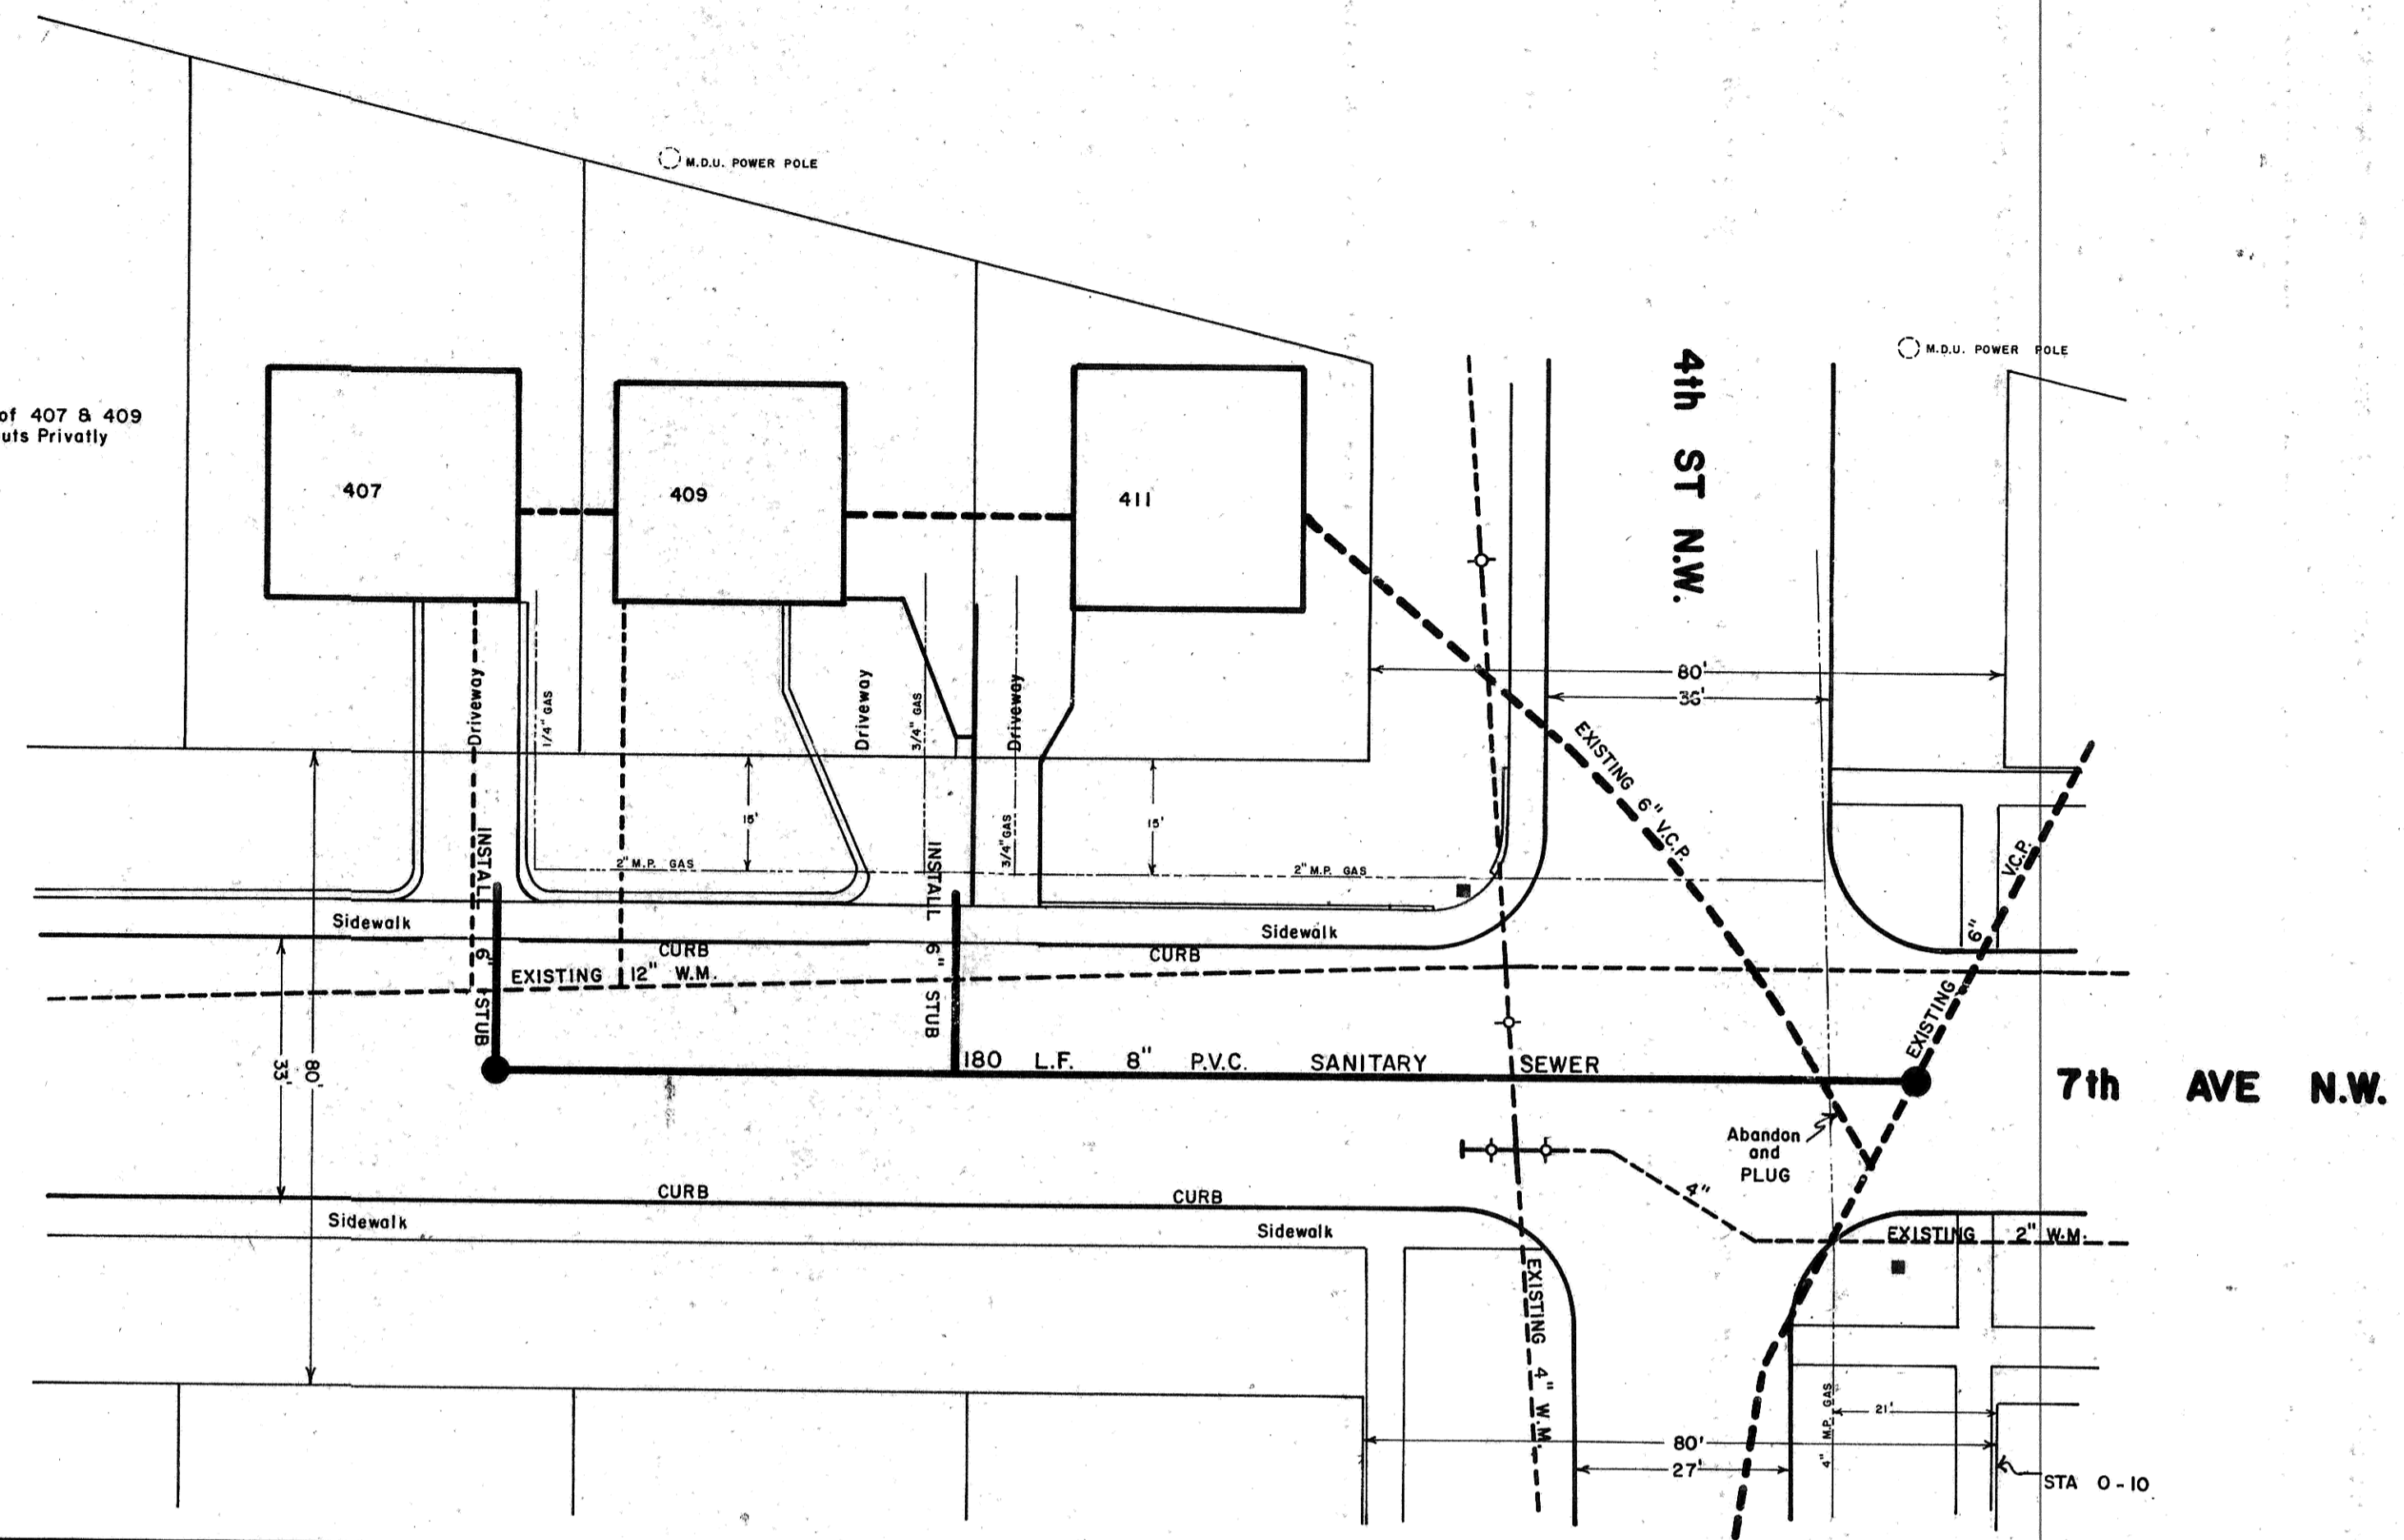

HORZ 1" = 20'
VERT 1" = 4'

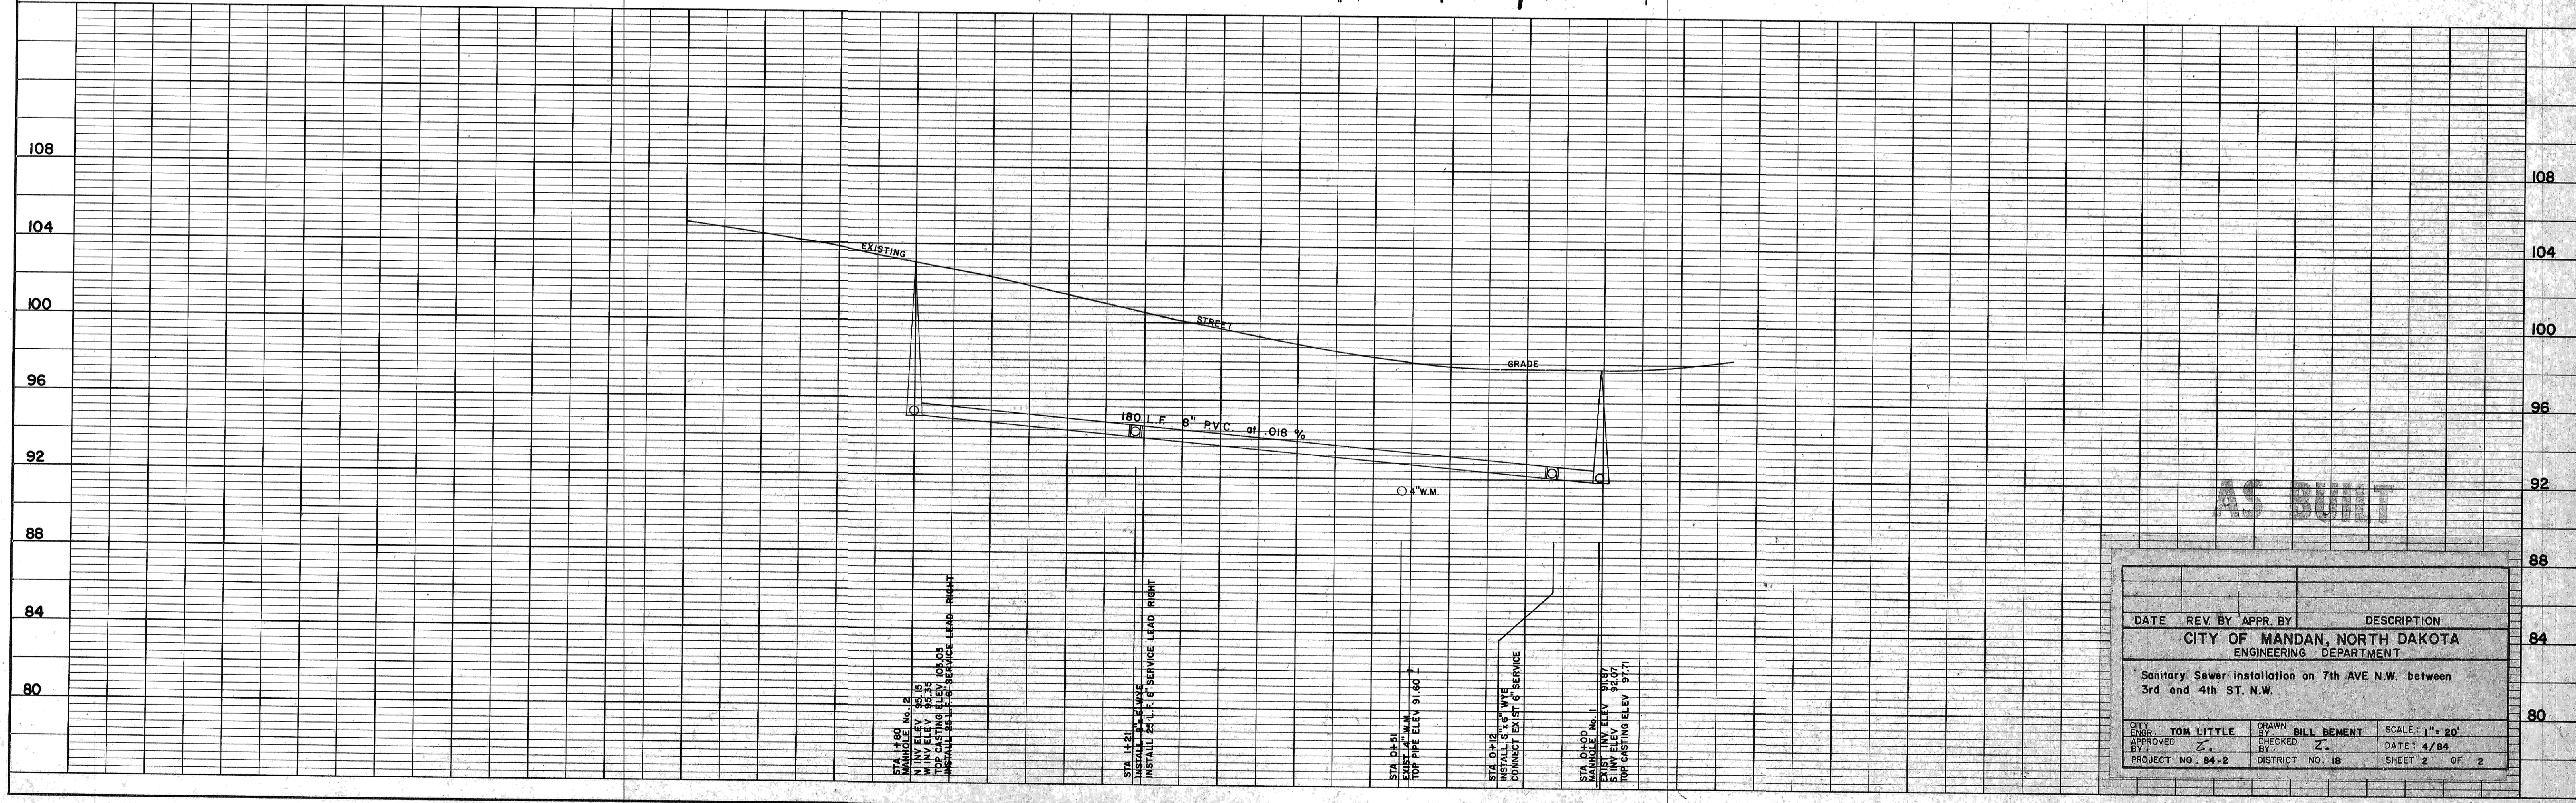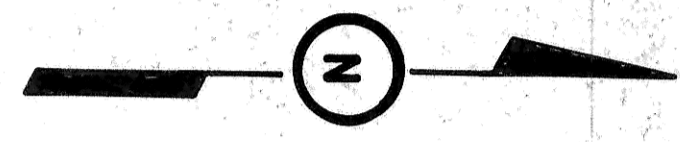

AS BUILT

DATE	REV. BY	APPR. BY	DESCRIPTION
			CITY OF MANDAN, NORTH DAKOTA ENGINEERING DEPARTMENT
Sanitary Sewer installation on 7th AVE N.W. between 3rd and 4th ST. N.W.			
ENGR.	TOM LITTLE	DRAWN	BILL BEMENT
APPROVED	Z.	CHECKED	Z.
PROJECT NO.	84-2	DISTRICT NO.	18
		DATE	4/84
		SHEET	2 OF 2