


PLAN VIEW
AERATOR CONTROL BUILDING
 1" = 1'-0"

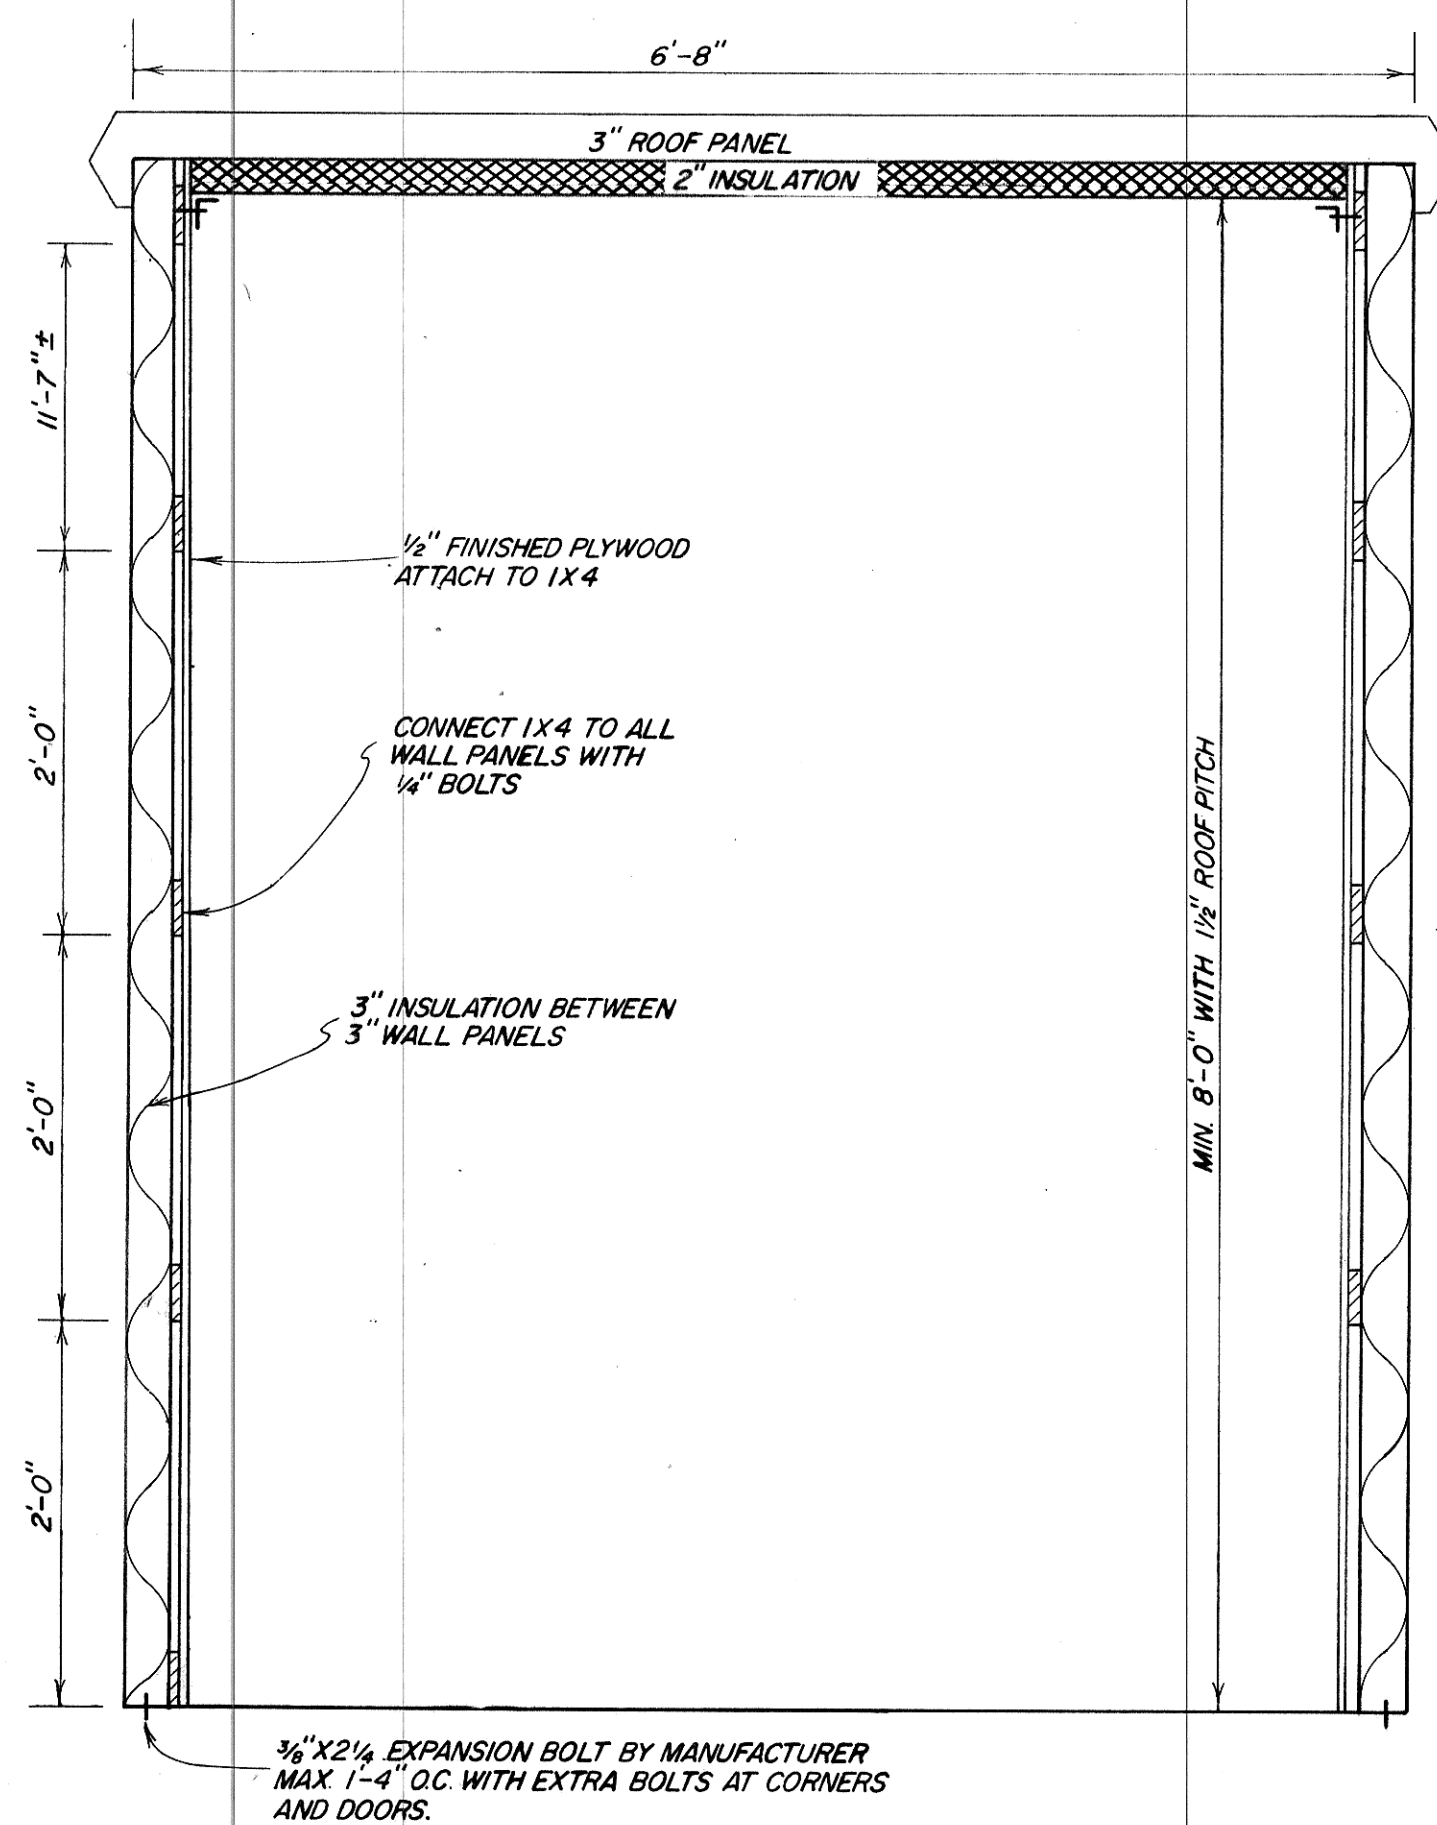

1 SECTION DETAIL
S-2
 1" = 1'-0"

Record Drawn
Raymond R. Johnson
 ULTEIG ENGINEERS, INC.
 CONSULTING ENGINEERS
 FARGO • BISMARCK • MINNEAPOLIS

REV.	DATE	DESCRIPTION	BY
△			
△			
△			
△			

AERATOR CONTROL BUILDING		
BLOWER AND SWITCH GEAR BUILDING		
MANDAN, NORTH DAKOTA		
DRAWN BY: RJ CHECKED BY: RR APPROVED BY: RR	SCALE: AS SHOWN DATE: NOV. 1988	