



WATER & SEWER IMPROVEMENT PLANS 3RD AVENUE S.E.

NOTE: CONTRACTOR TO FIELD VERIFY LOCATION OF ALL UNDERGROUND UTILITIES PRIOR TO CONSTRUCTION

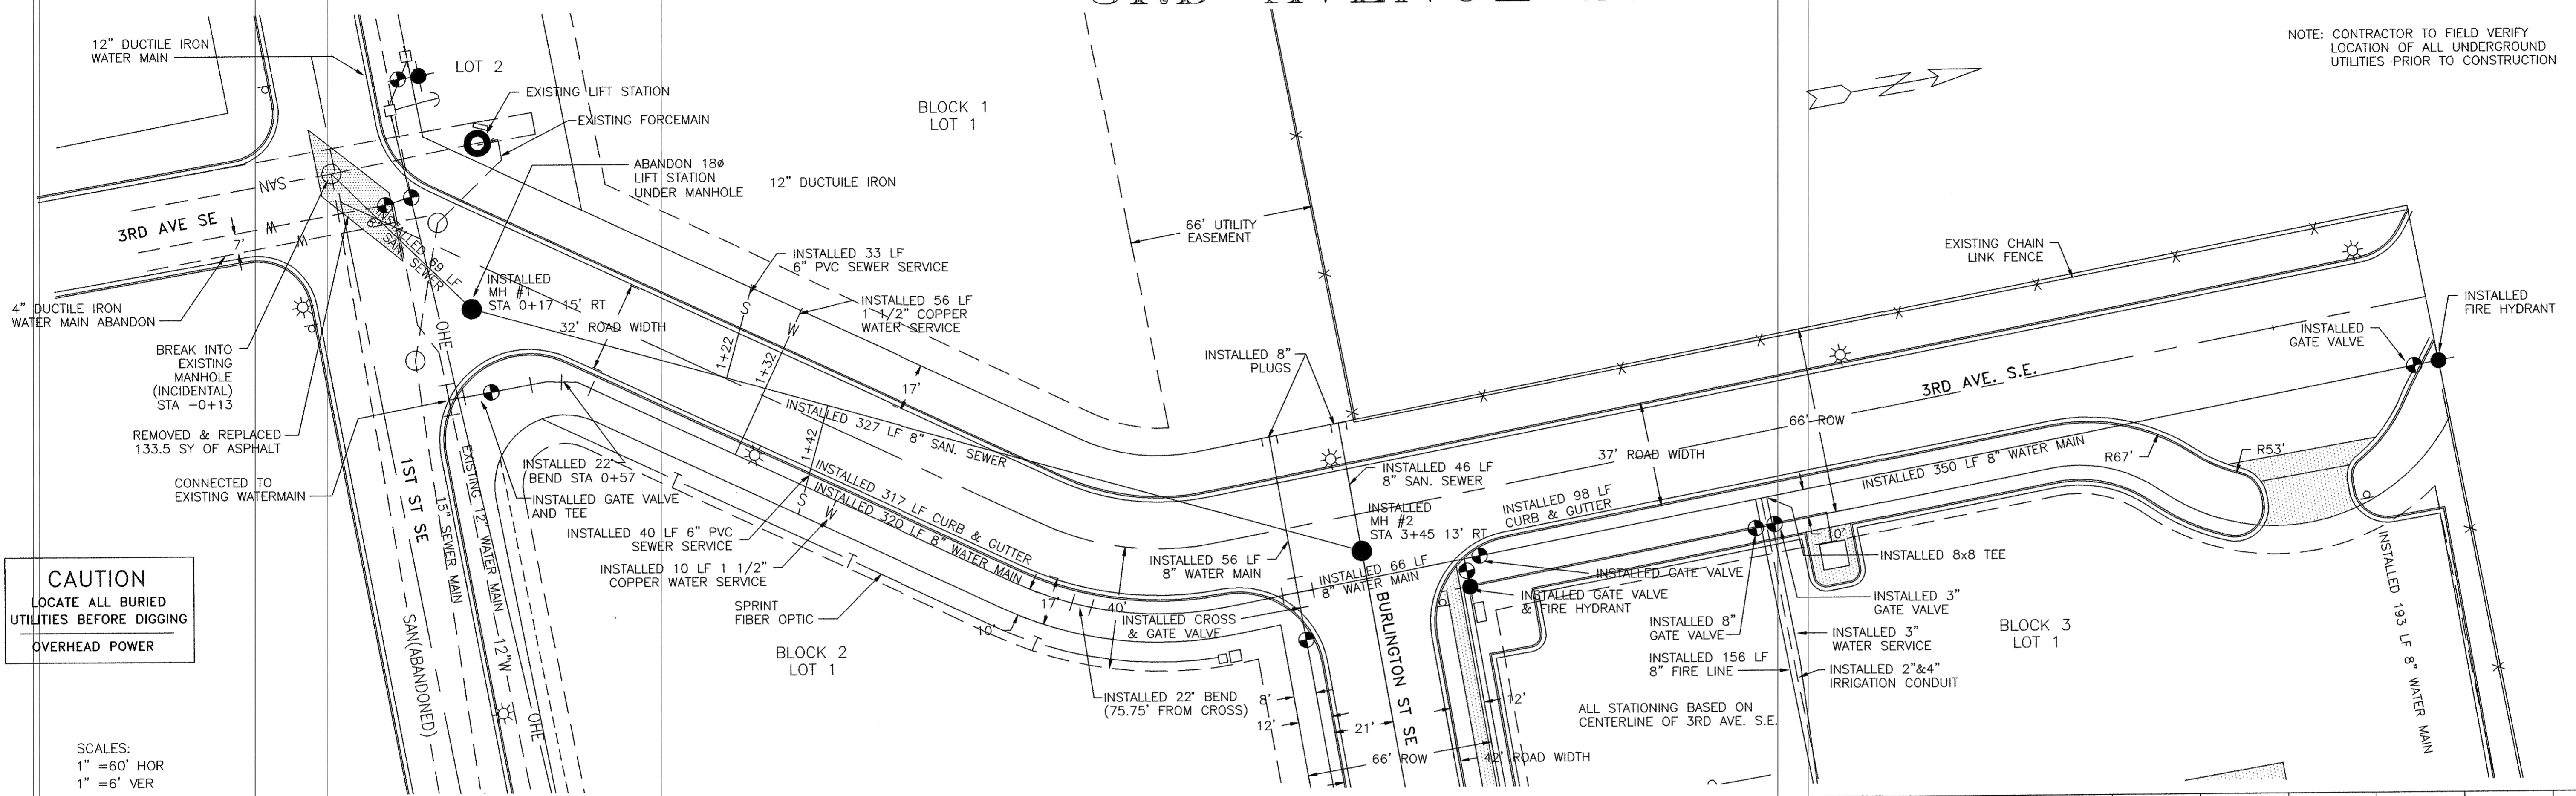

CAUTION
LOCATE ALL BURIED UTILITIES BEFORE DIGGING OVERHEAD POWER

SCALES:
1" = 60' HOR
1" = 6' VER

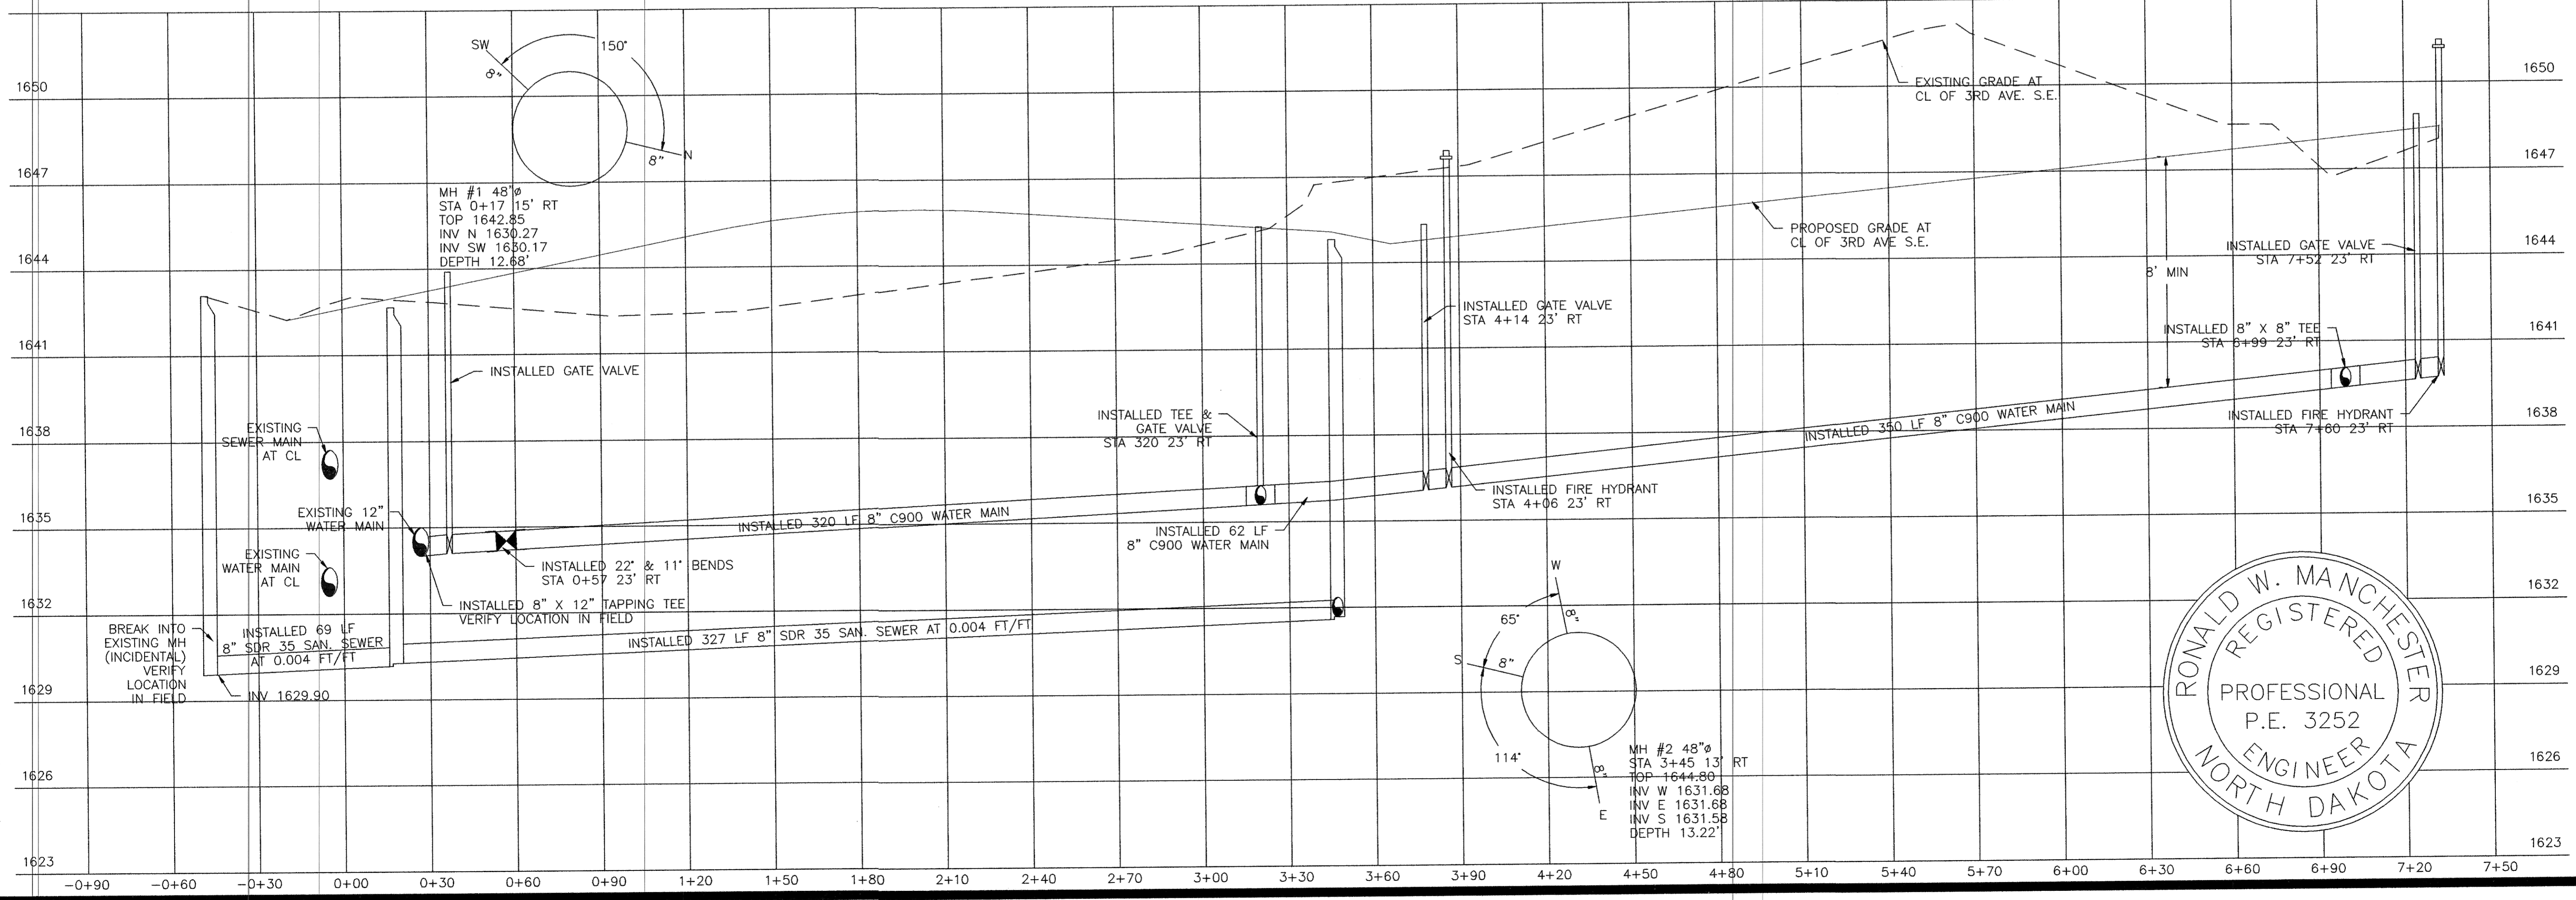

TOMAN ENGINEERING COMPANY
CONSULTING CIVIL & ENVIRONMENTAL ENGINEERS
906 2ND ST. N.W. • WARDIAN, NORTH DAKOTA 58554
(701) 663-6483

3RD AVENUE S.E.
WATER & SEWER
PLAN & PROFILE

PROJECT:

NO.	DATE	BY	DATE	REVISIONS
1	8/19/97	HS/AM	8/19/97	MOVE BLDG. & W. & S. LINES
2	12/99	AR	12/99	AS-BUILT DRAWINGS

SHEET NUMBER

3

OF 5 SHEETS

DWGNAME: R601002.dwg PLOT DATE: 02/05/99 PLOT TIME: 16:34:48 TOMAN #3