


AS-BUILTS WATER & SEWER IMPROVEMENT AS-BUILTS DAN'S SUPERMARKET, INC. MANDAN, NORTH DAKOTA


CITY PROJECT NO. 97-17

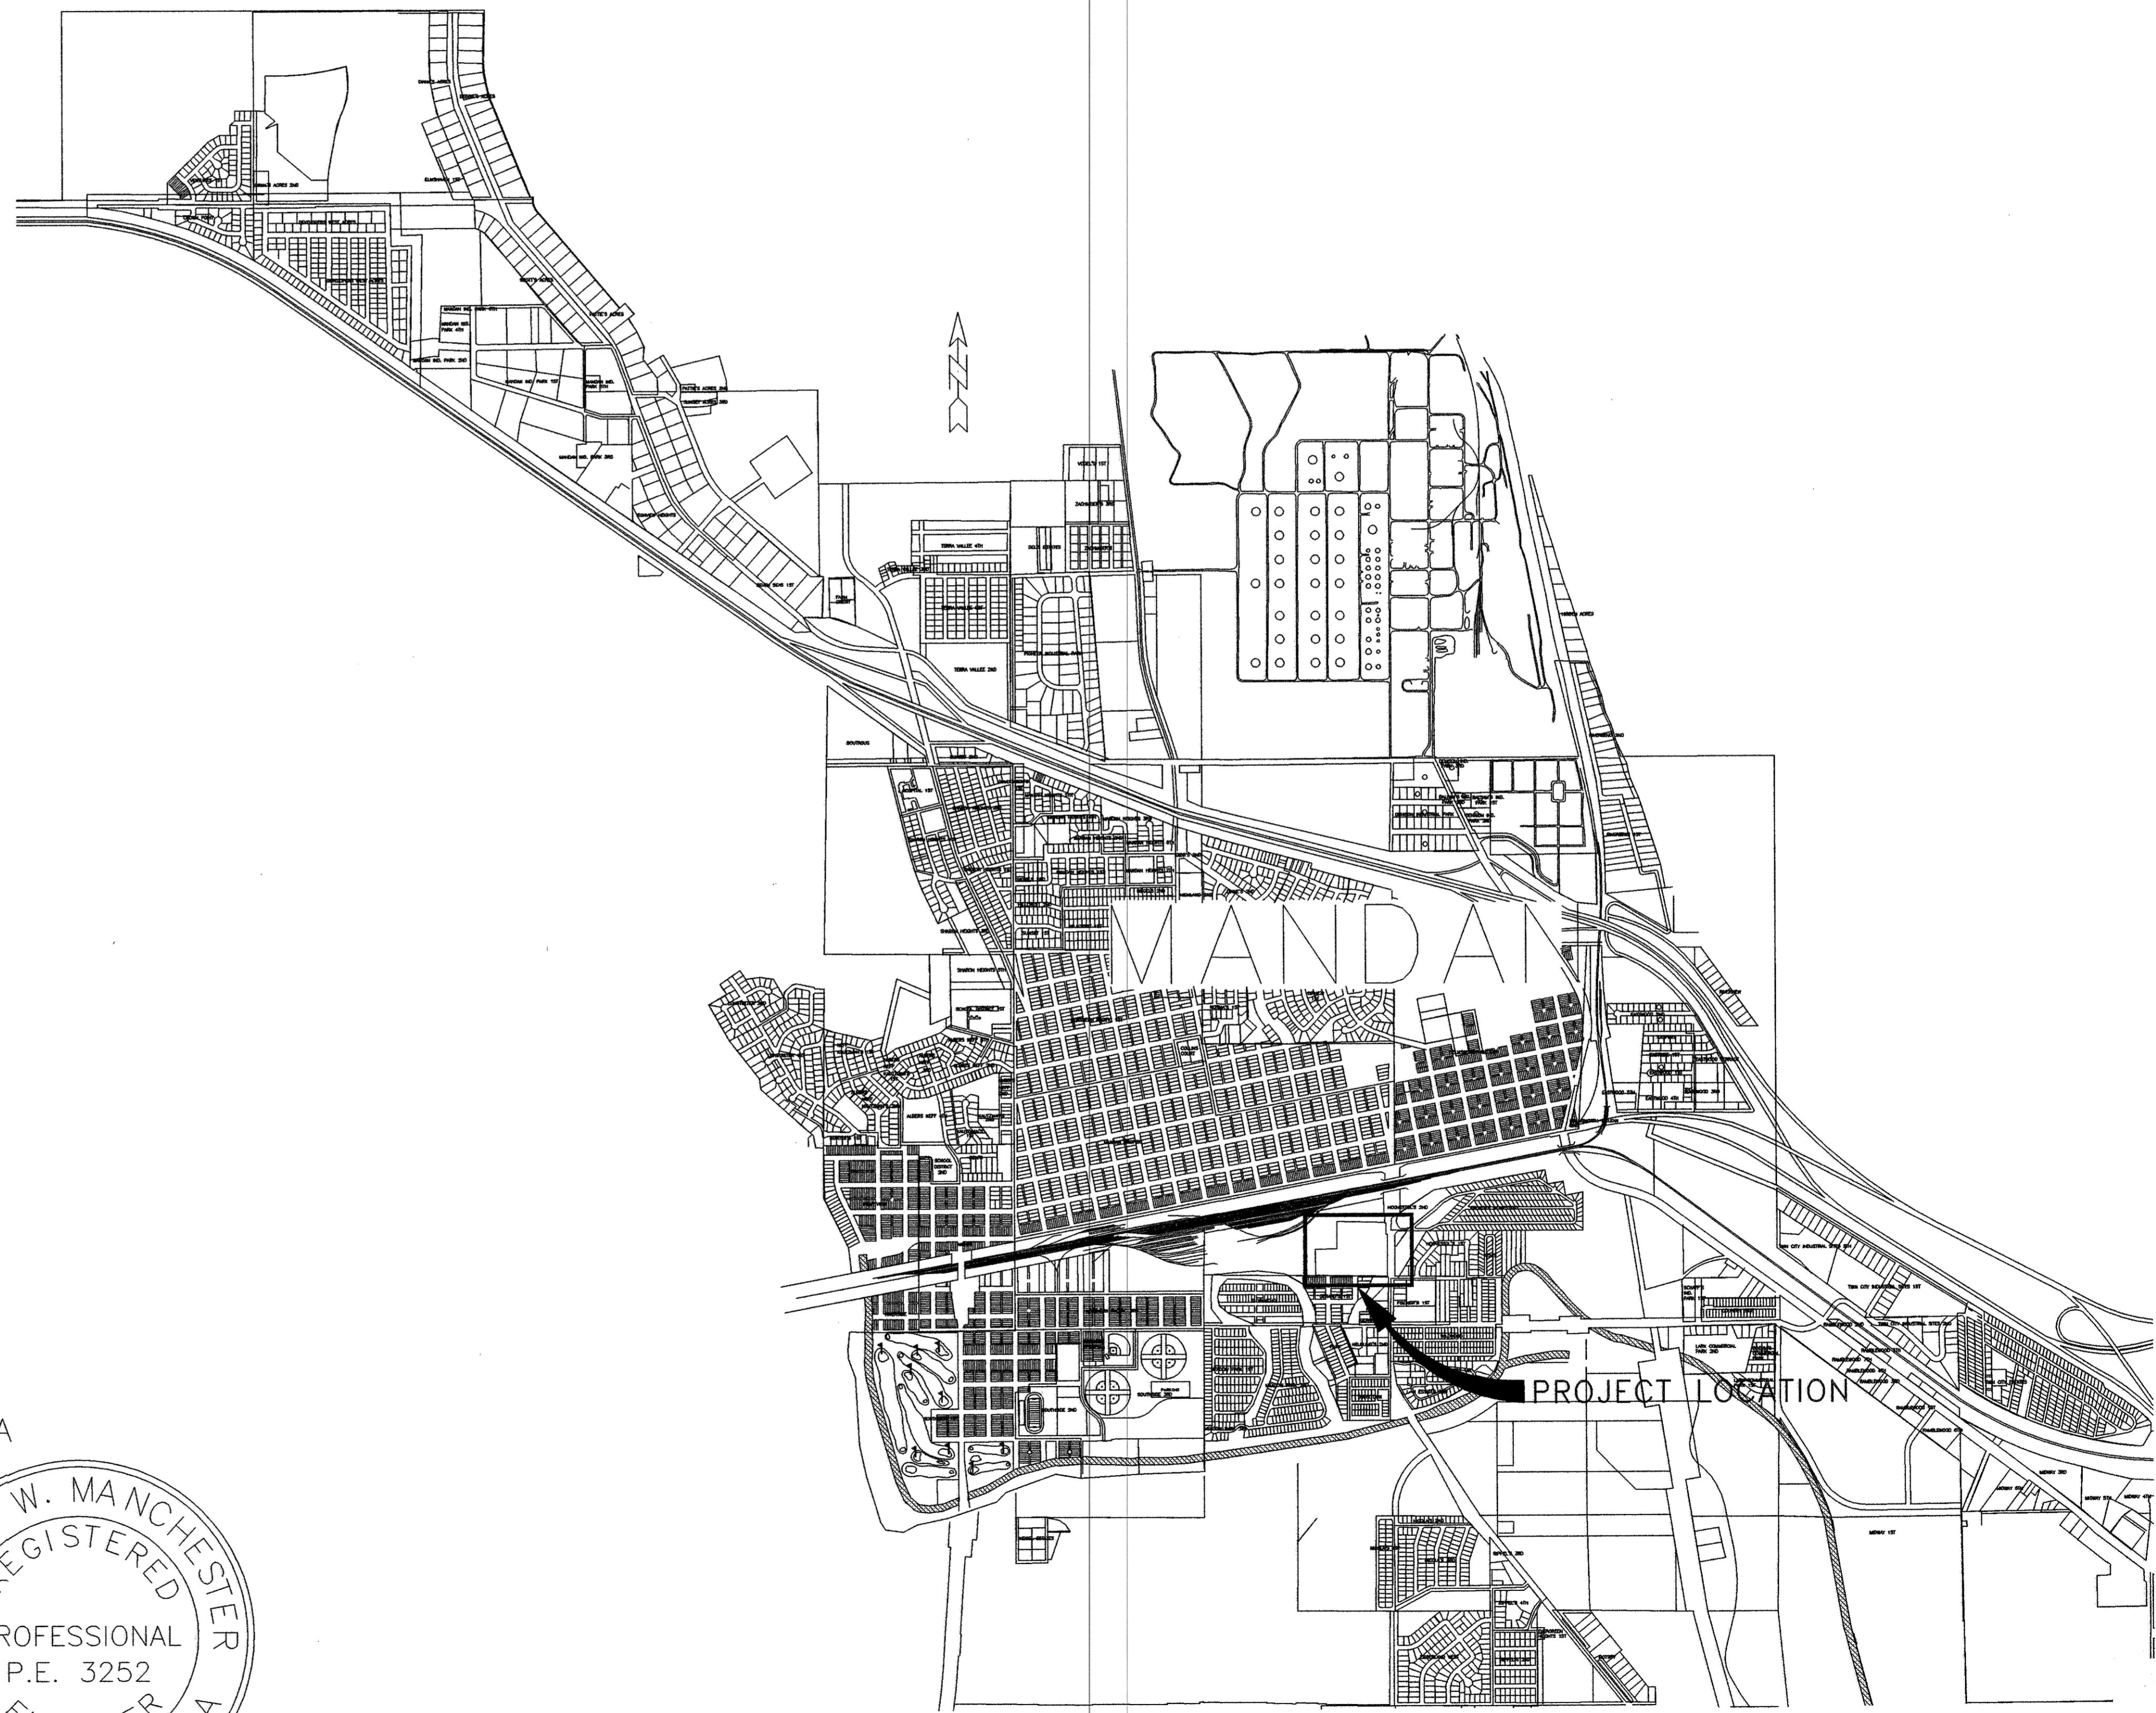

INDEX OF DRAWINGS	
SHT #	TITLE
1	TITLE SHEET
2	PROJECT LAYOUT & GRADING PLAN
3	3RD AVENUE S.E. WATER & SEWER PLAN & PROFILE
4	BURLINGTON ST. S.E. WATER & SEWER PLAN & PROFILE
5	DETAIL SHEET

CONTRACTOR — TITUS CONSTRUCTION
PROJECT INSTALLED CONSTRUCTION
SEASON 1997

THOMAS LITTLE, R.P.E. CITY ENGINEER, MANDAN, NORTH DAKOTA

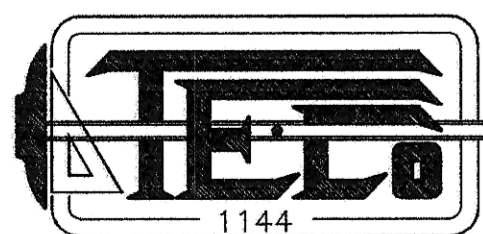

TOMAN ENGINEERING COMPANY
CONSULTING CIVIL & ENVIRONMENTAL ENGINEERS
906 2ND STREET NW * MANDAN, NORTH DAKOTA 58554
(701) 663-6483

PREPARED BY:
TOMAN ENGINEERING
RONALD MANCHESTER R.P.E. 3252
DATE: AUGUST, 1997



DRAWING: 210010.dwg PLOT DATE: 02/05/99 PLOT TIME: 15:46:15 TOMAN #3