



CLEAR WELL DETAIL SHOWING WATER FLOW SCALE: 1/4" = 1'-0"

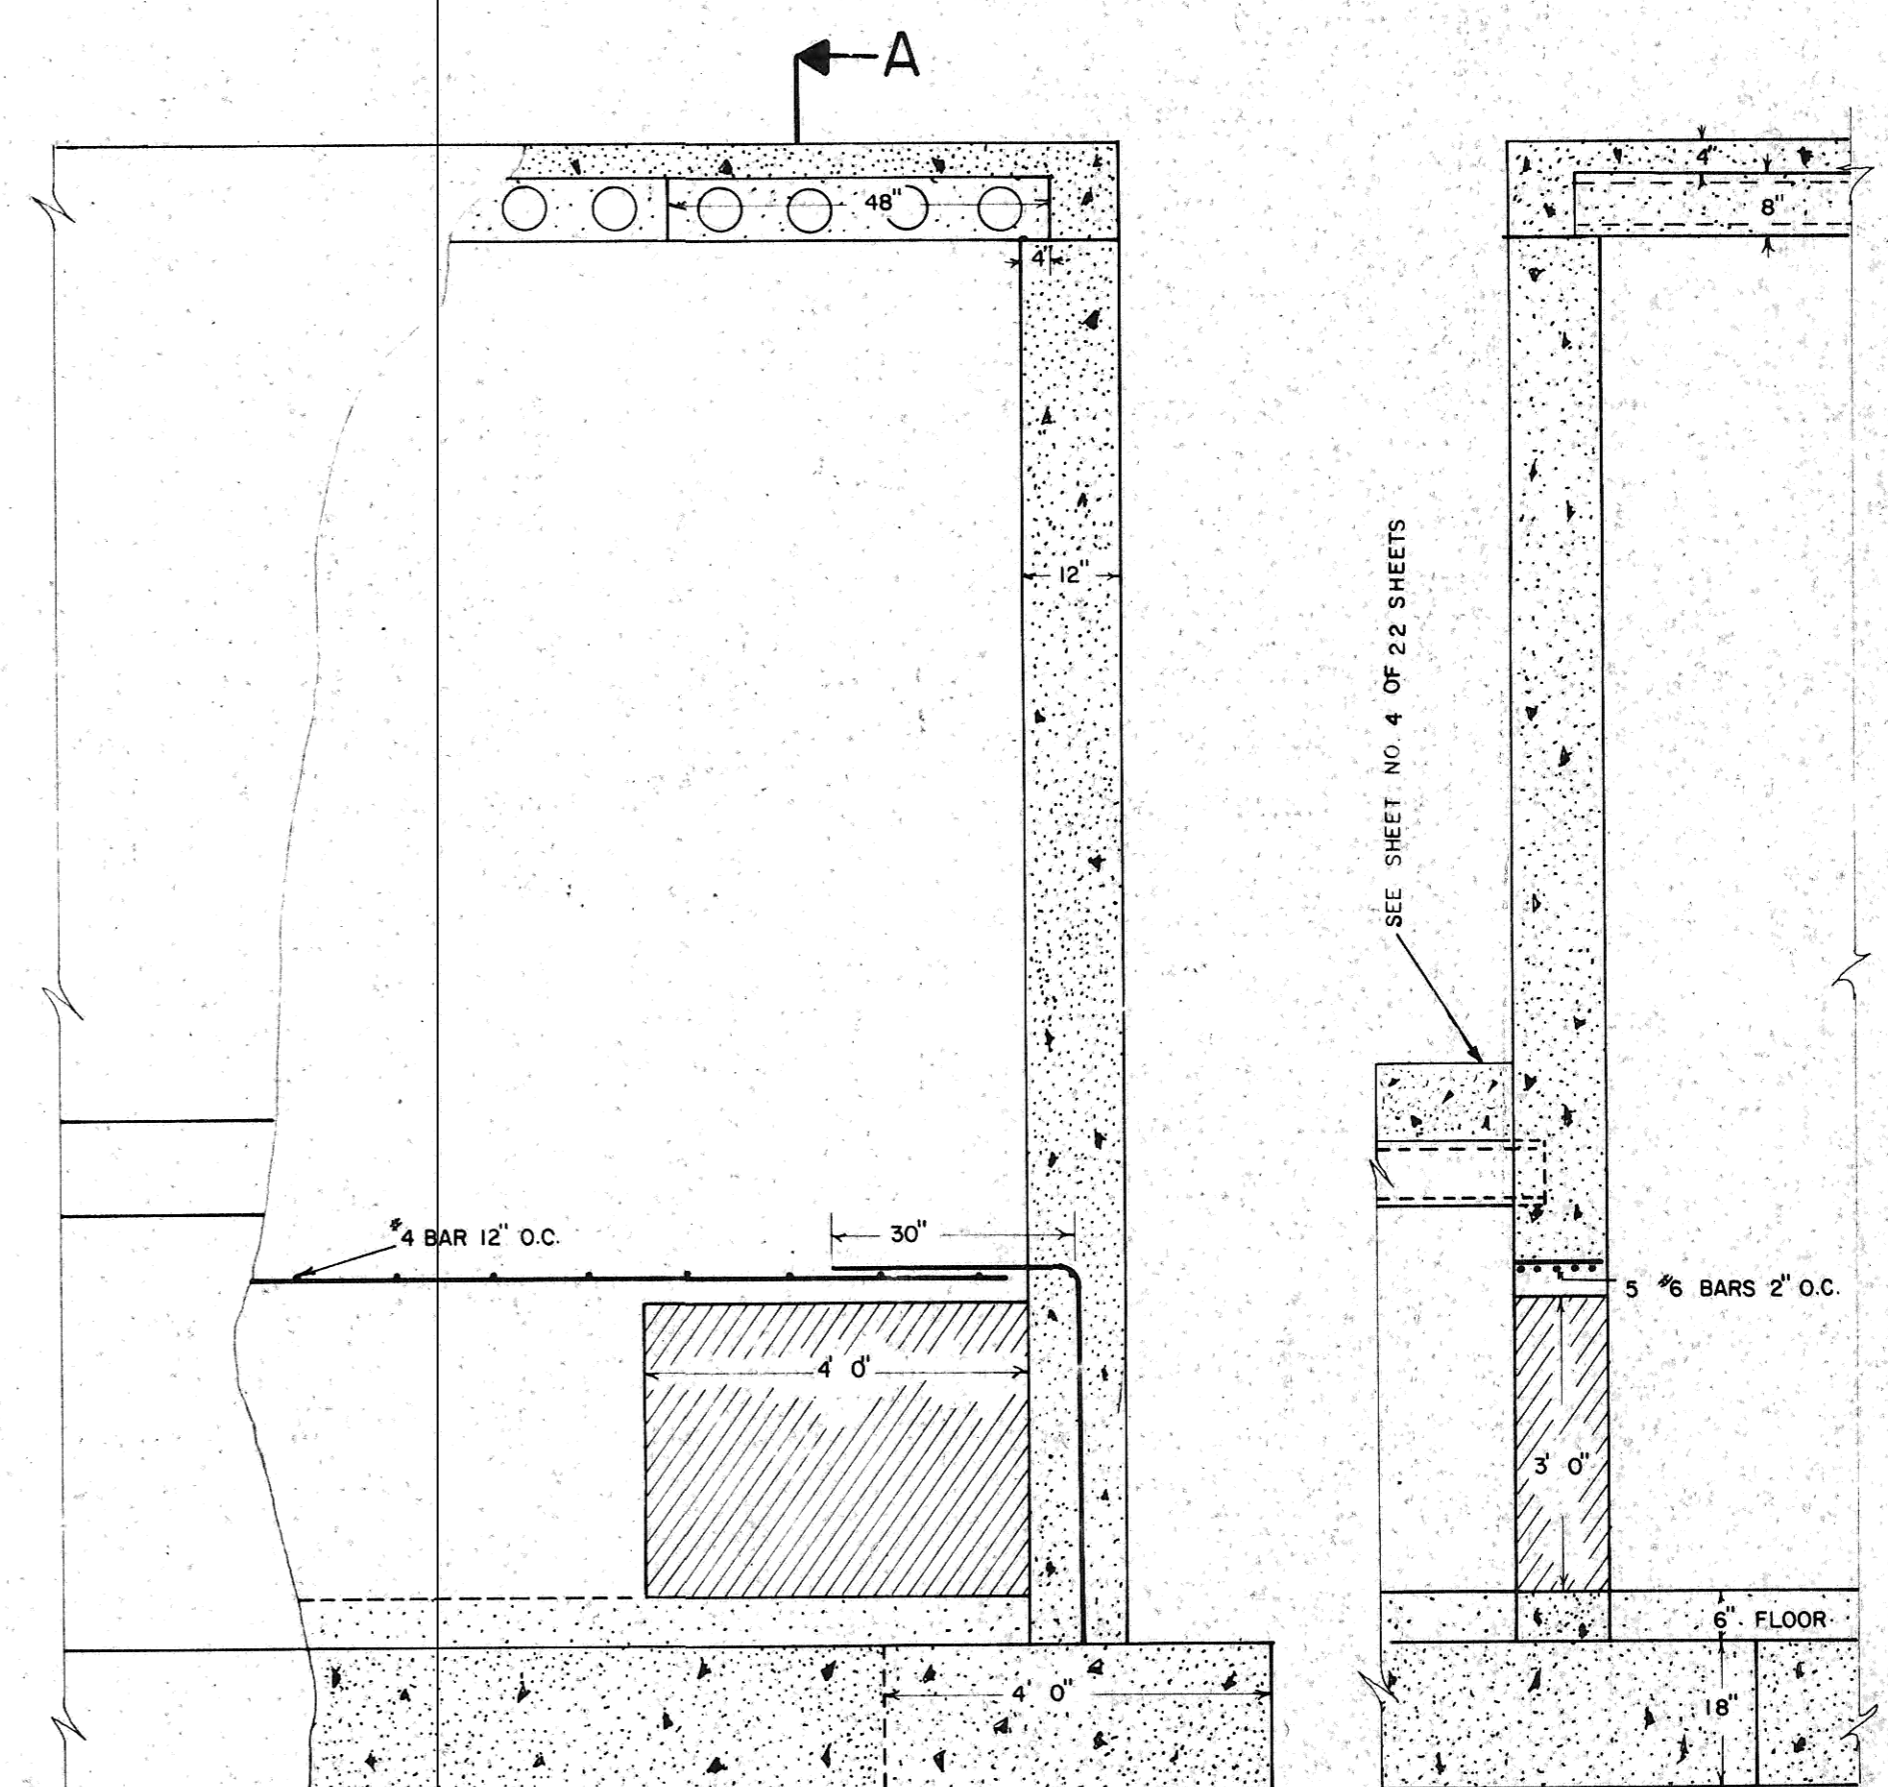


SECTION A-A


12" WALL DETAIL SCALE: 1/2" = 1'-0"

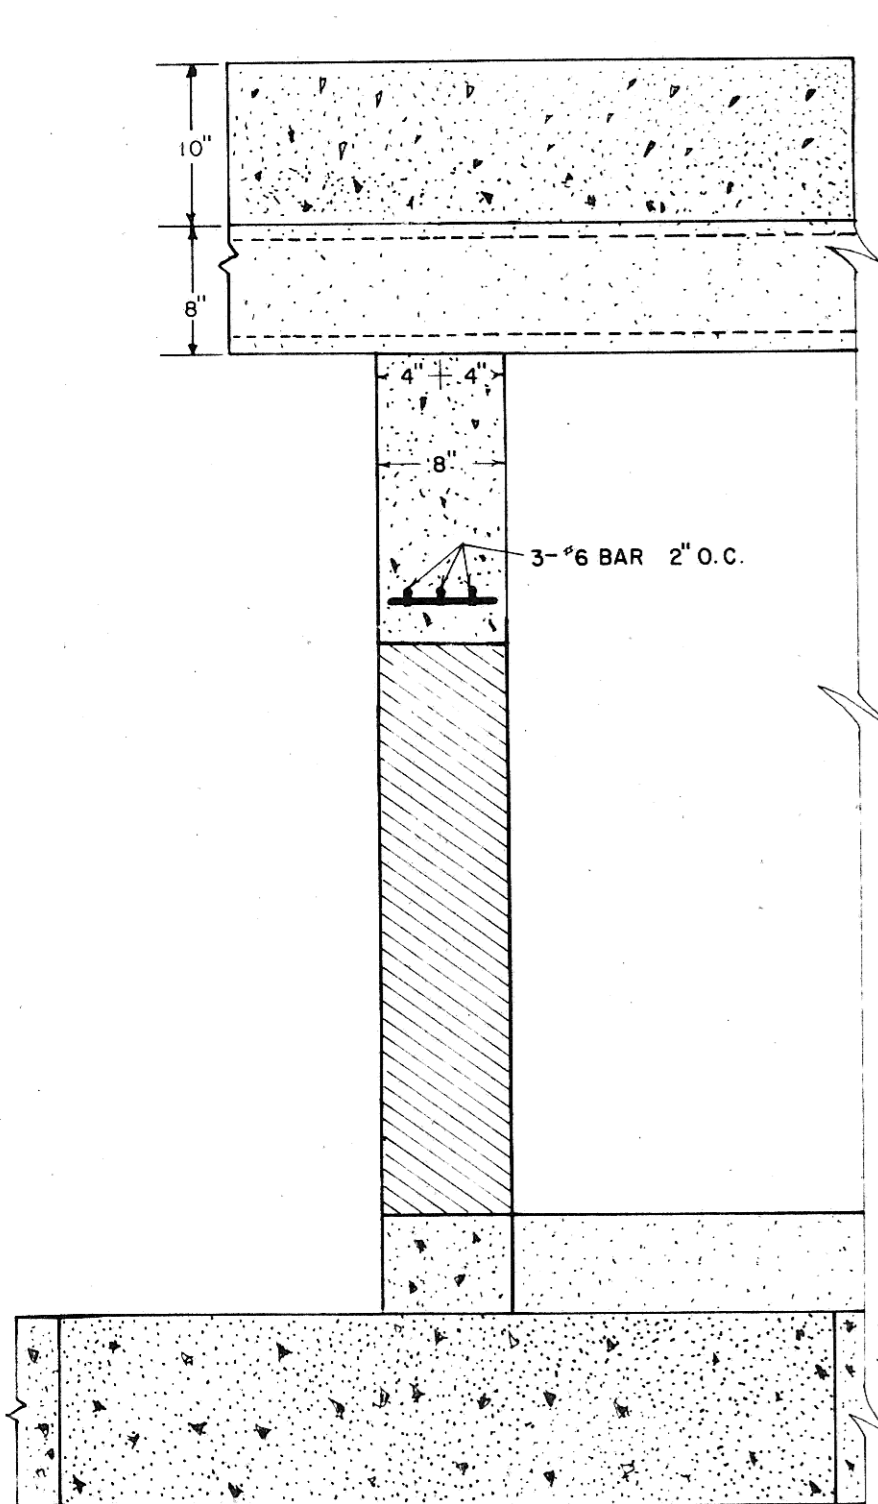


SECTION B-B

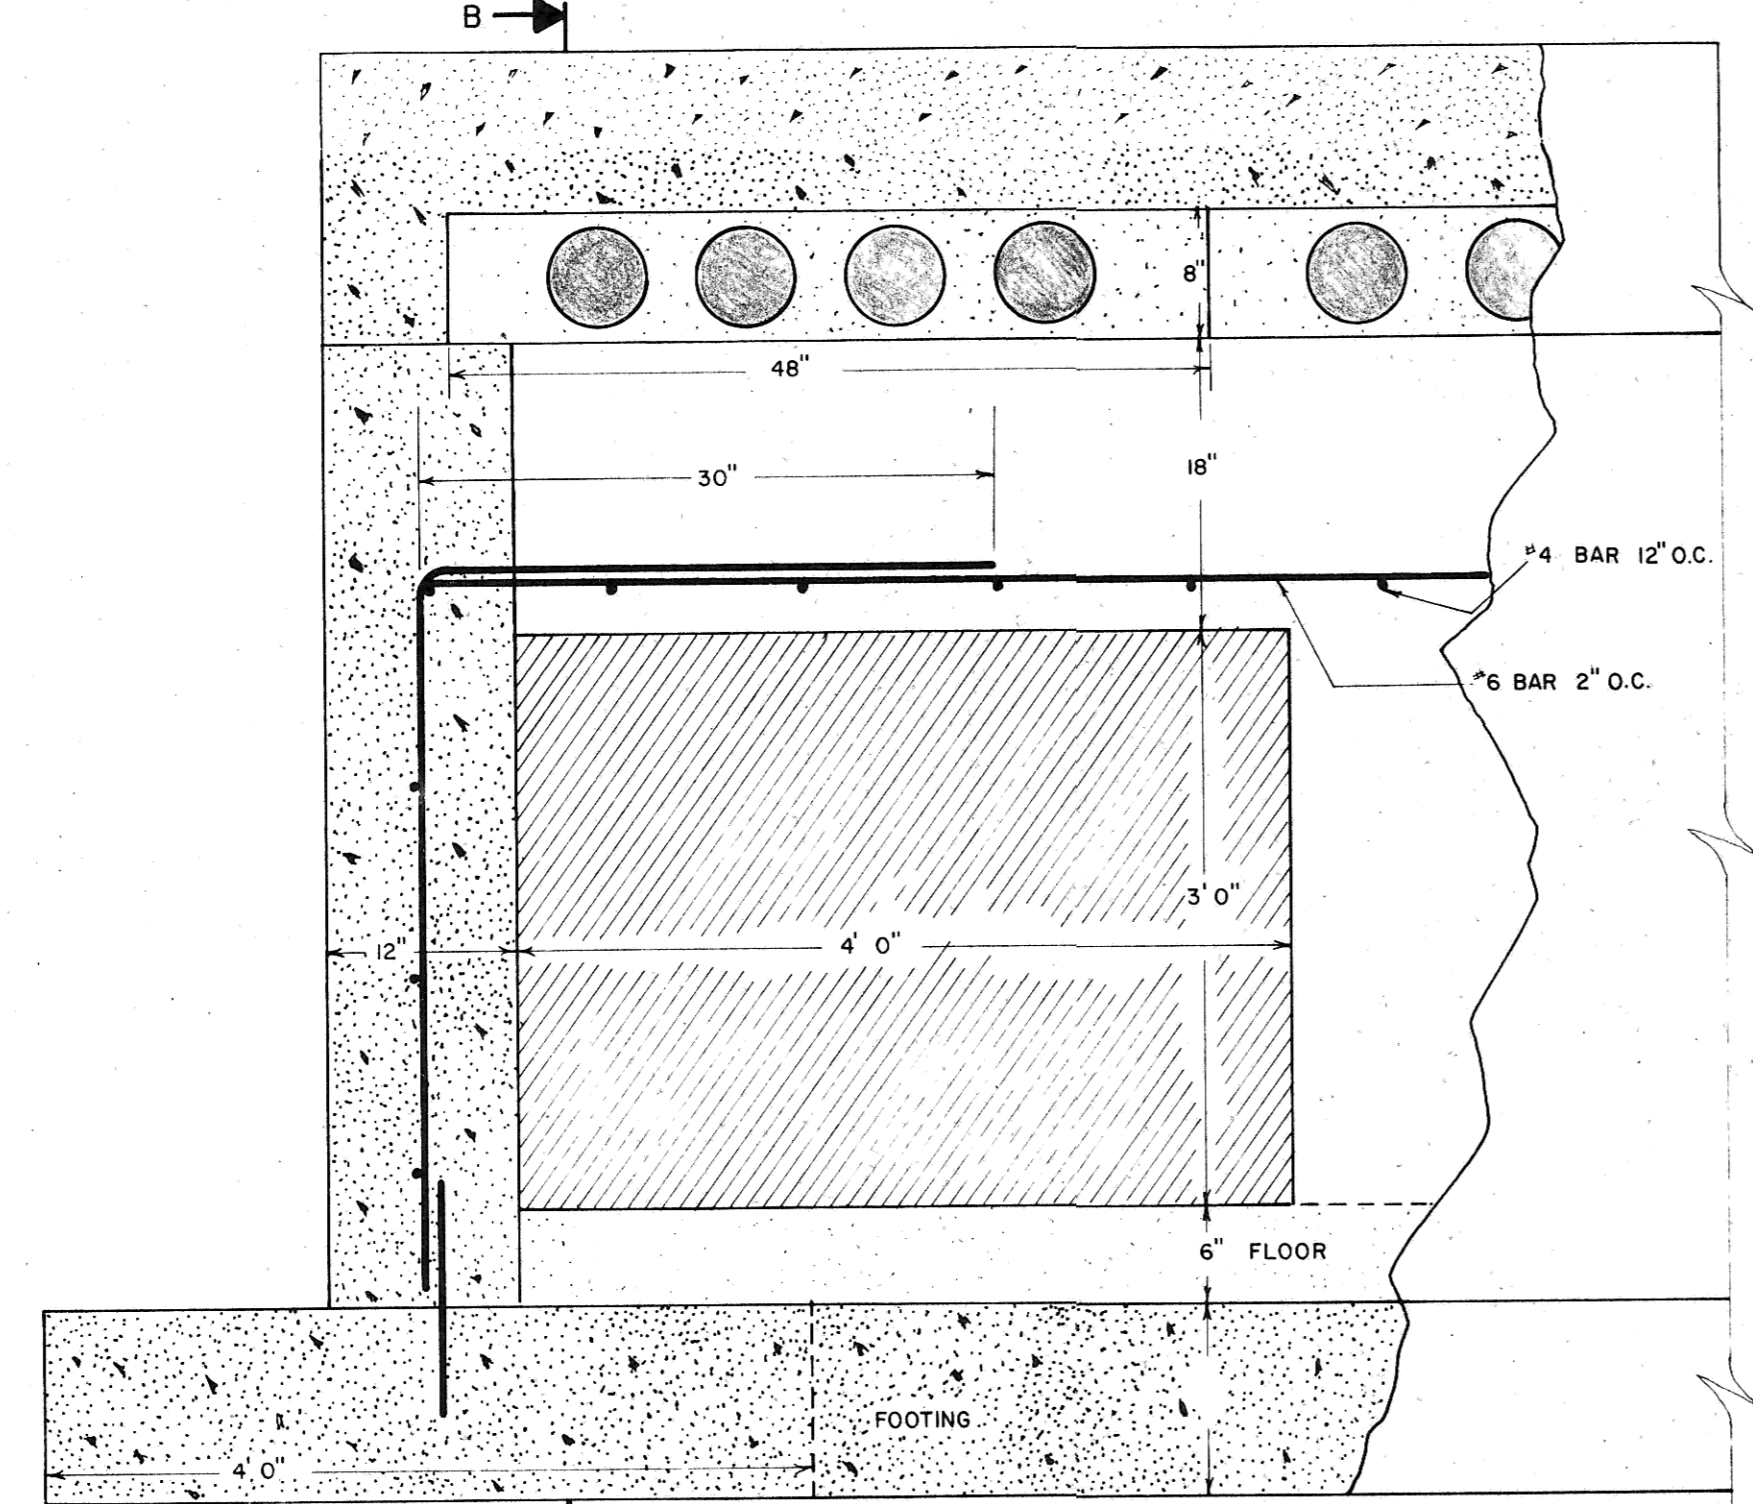

8" WALL DETAIL SCALE: 1" = 1'-0"

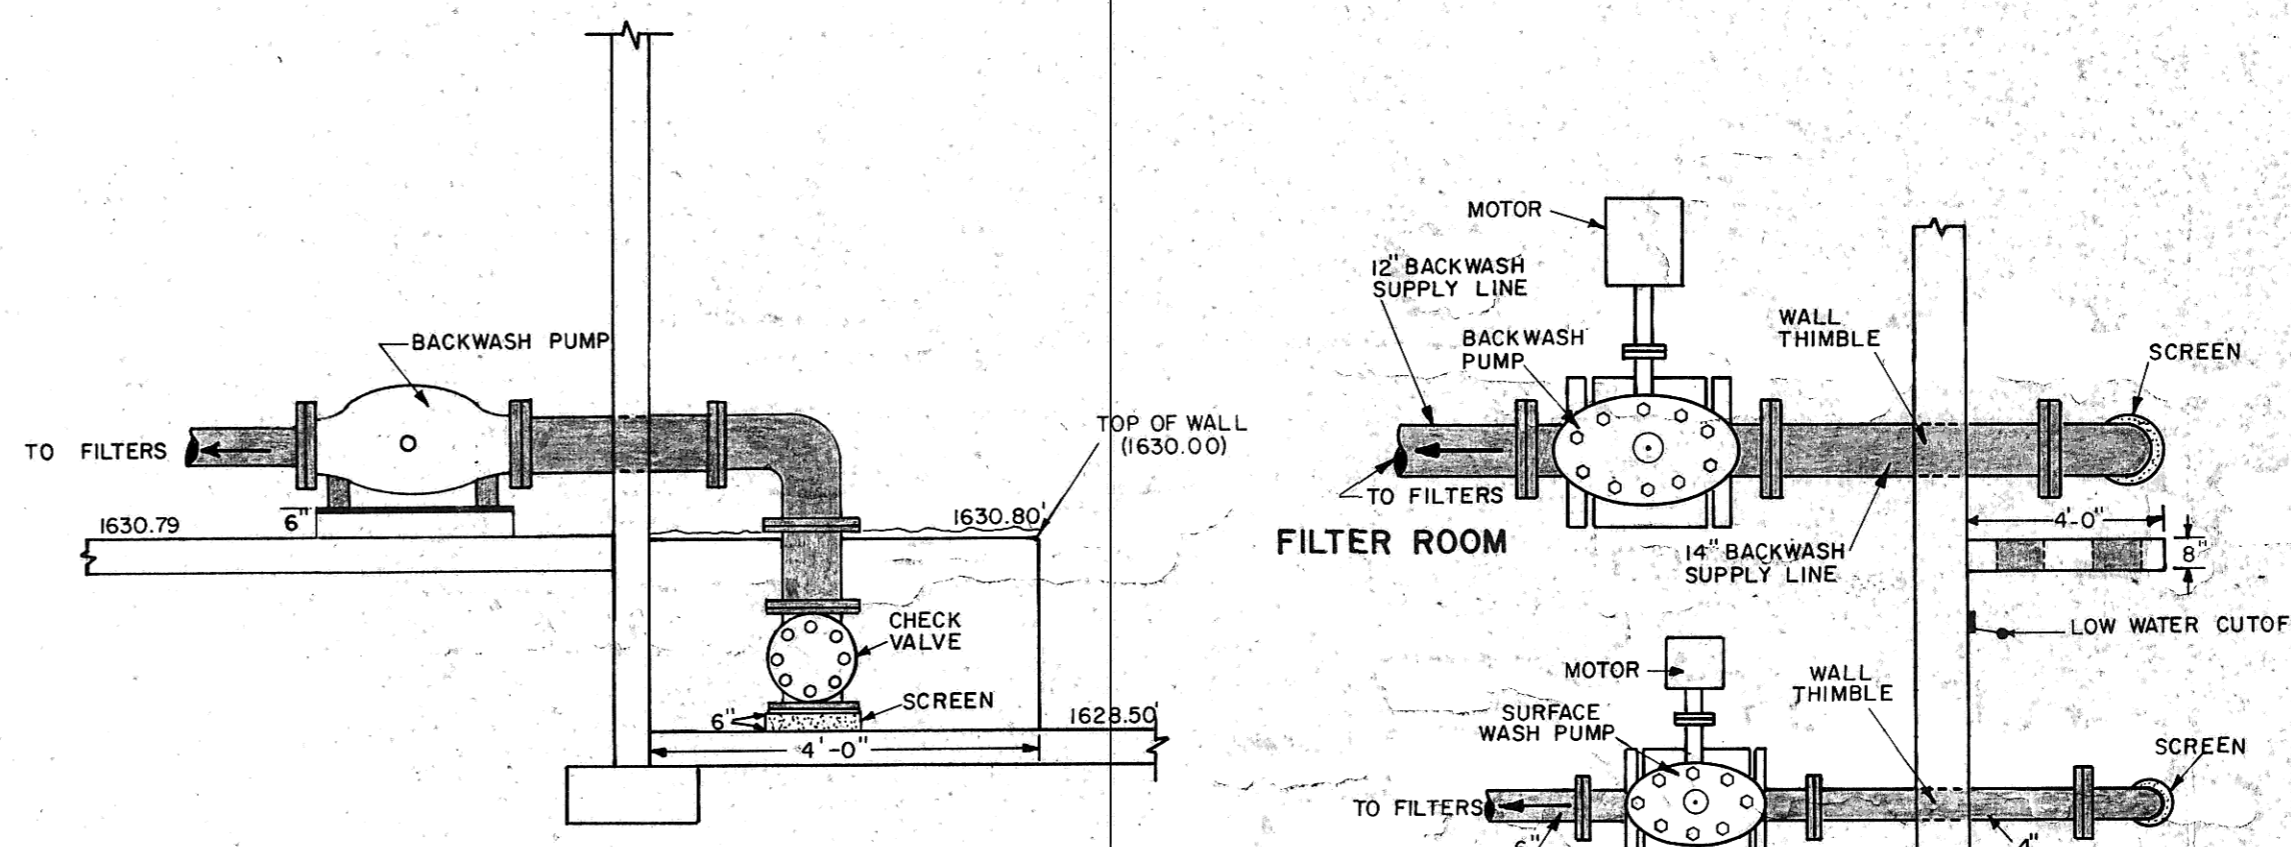

SURFACE WASH AND BACKWASH PUMP LAYOUT

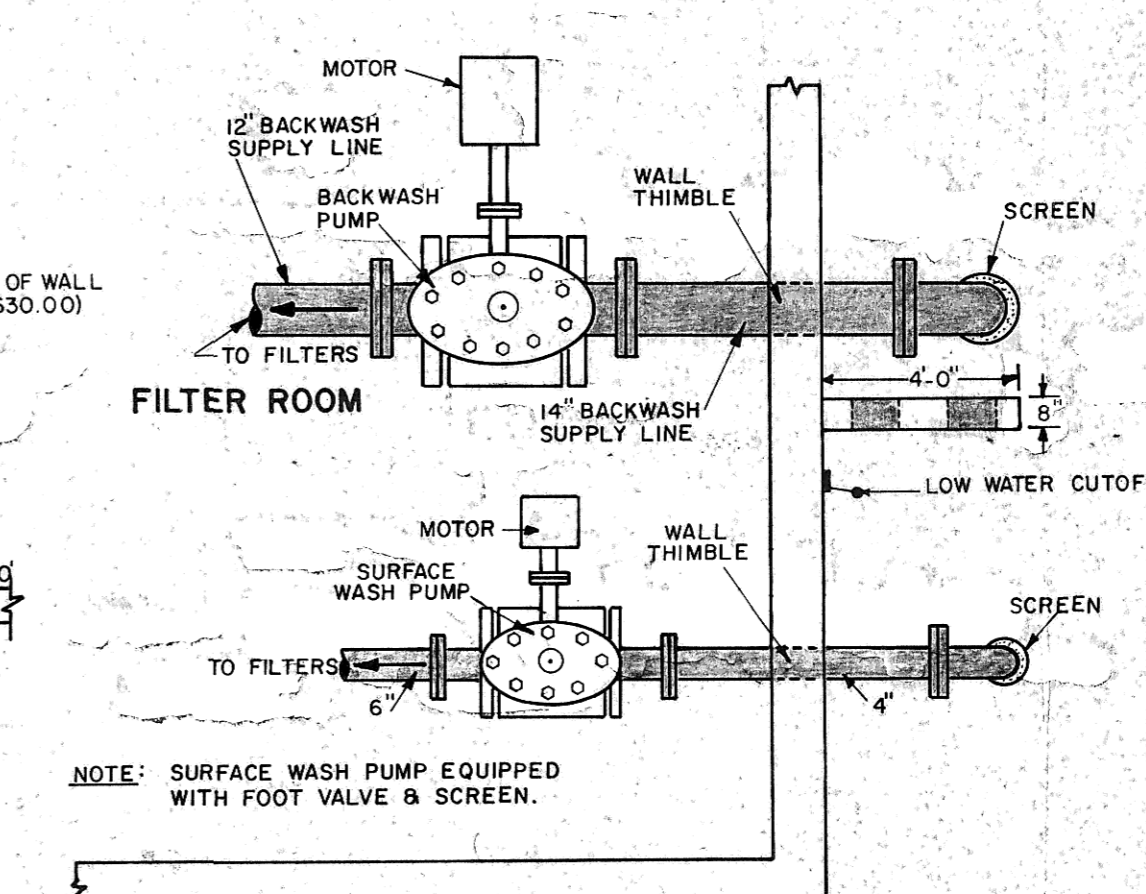

TOP VIEW

JOB: UPGRADE WASTEWATER TREATMENT FACILITIES  
 INCREMENT NO. 1 E.P.A. NO. C 380325-03  
 CONTRACTOR'S RECORD DRAWINGS (AS BUILT)

FILE NO. \_\_\_\_\_ DATE: SEPTEMBER 1976  
 REVISED: \_\_\_\_\_

**SHEET NO. 12 OF 23 SHEETS**

DRAWN BY: TP CHECKED BY: \_\_\_\_\_  
 CLEAR WELL FLOW & WALL DETAILS, SURFACE & BACKWASH PUMP LAYOUT

Toman Engineering Company  
 Civil & Environmental Consultants  
 P. O. Box 708 P. O. Box 852  
 Mandan, ND Bozeman, Man RKO OEO