



SECTION A-A

EFFLUENT TROUGH  
SCALE: 1"=1'-0"

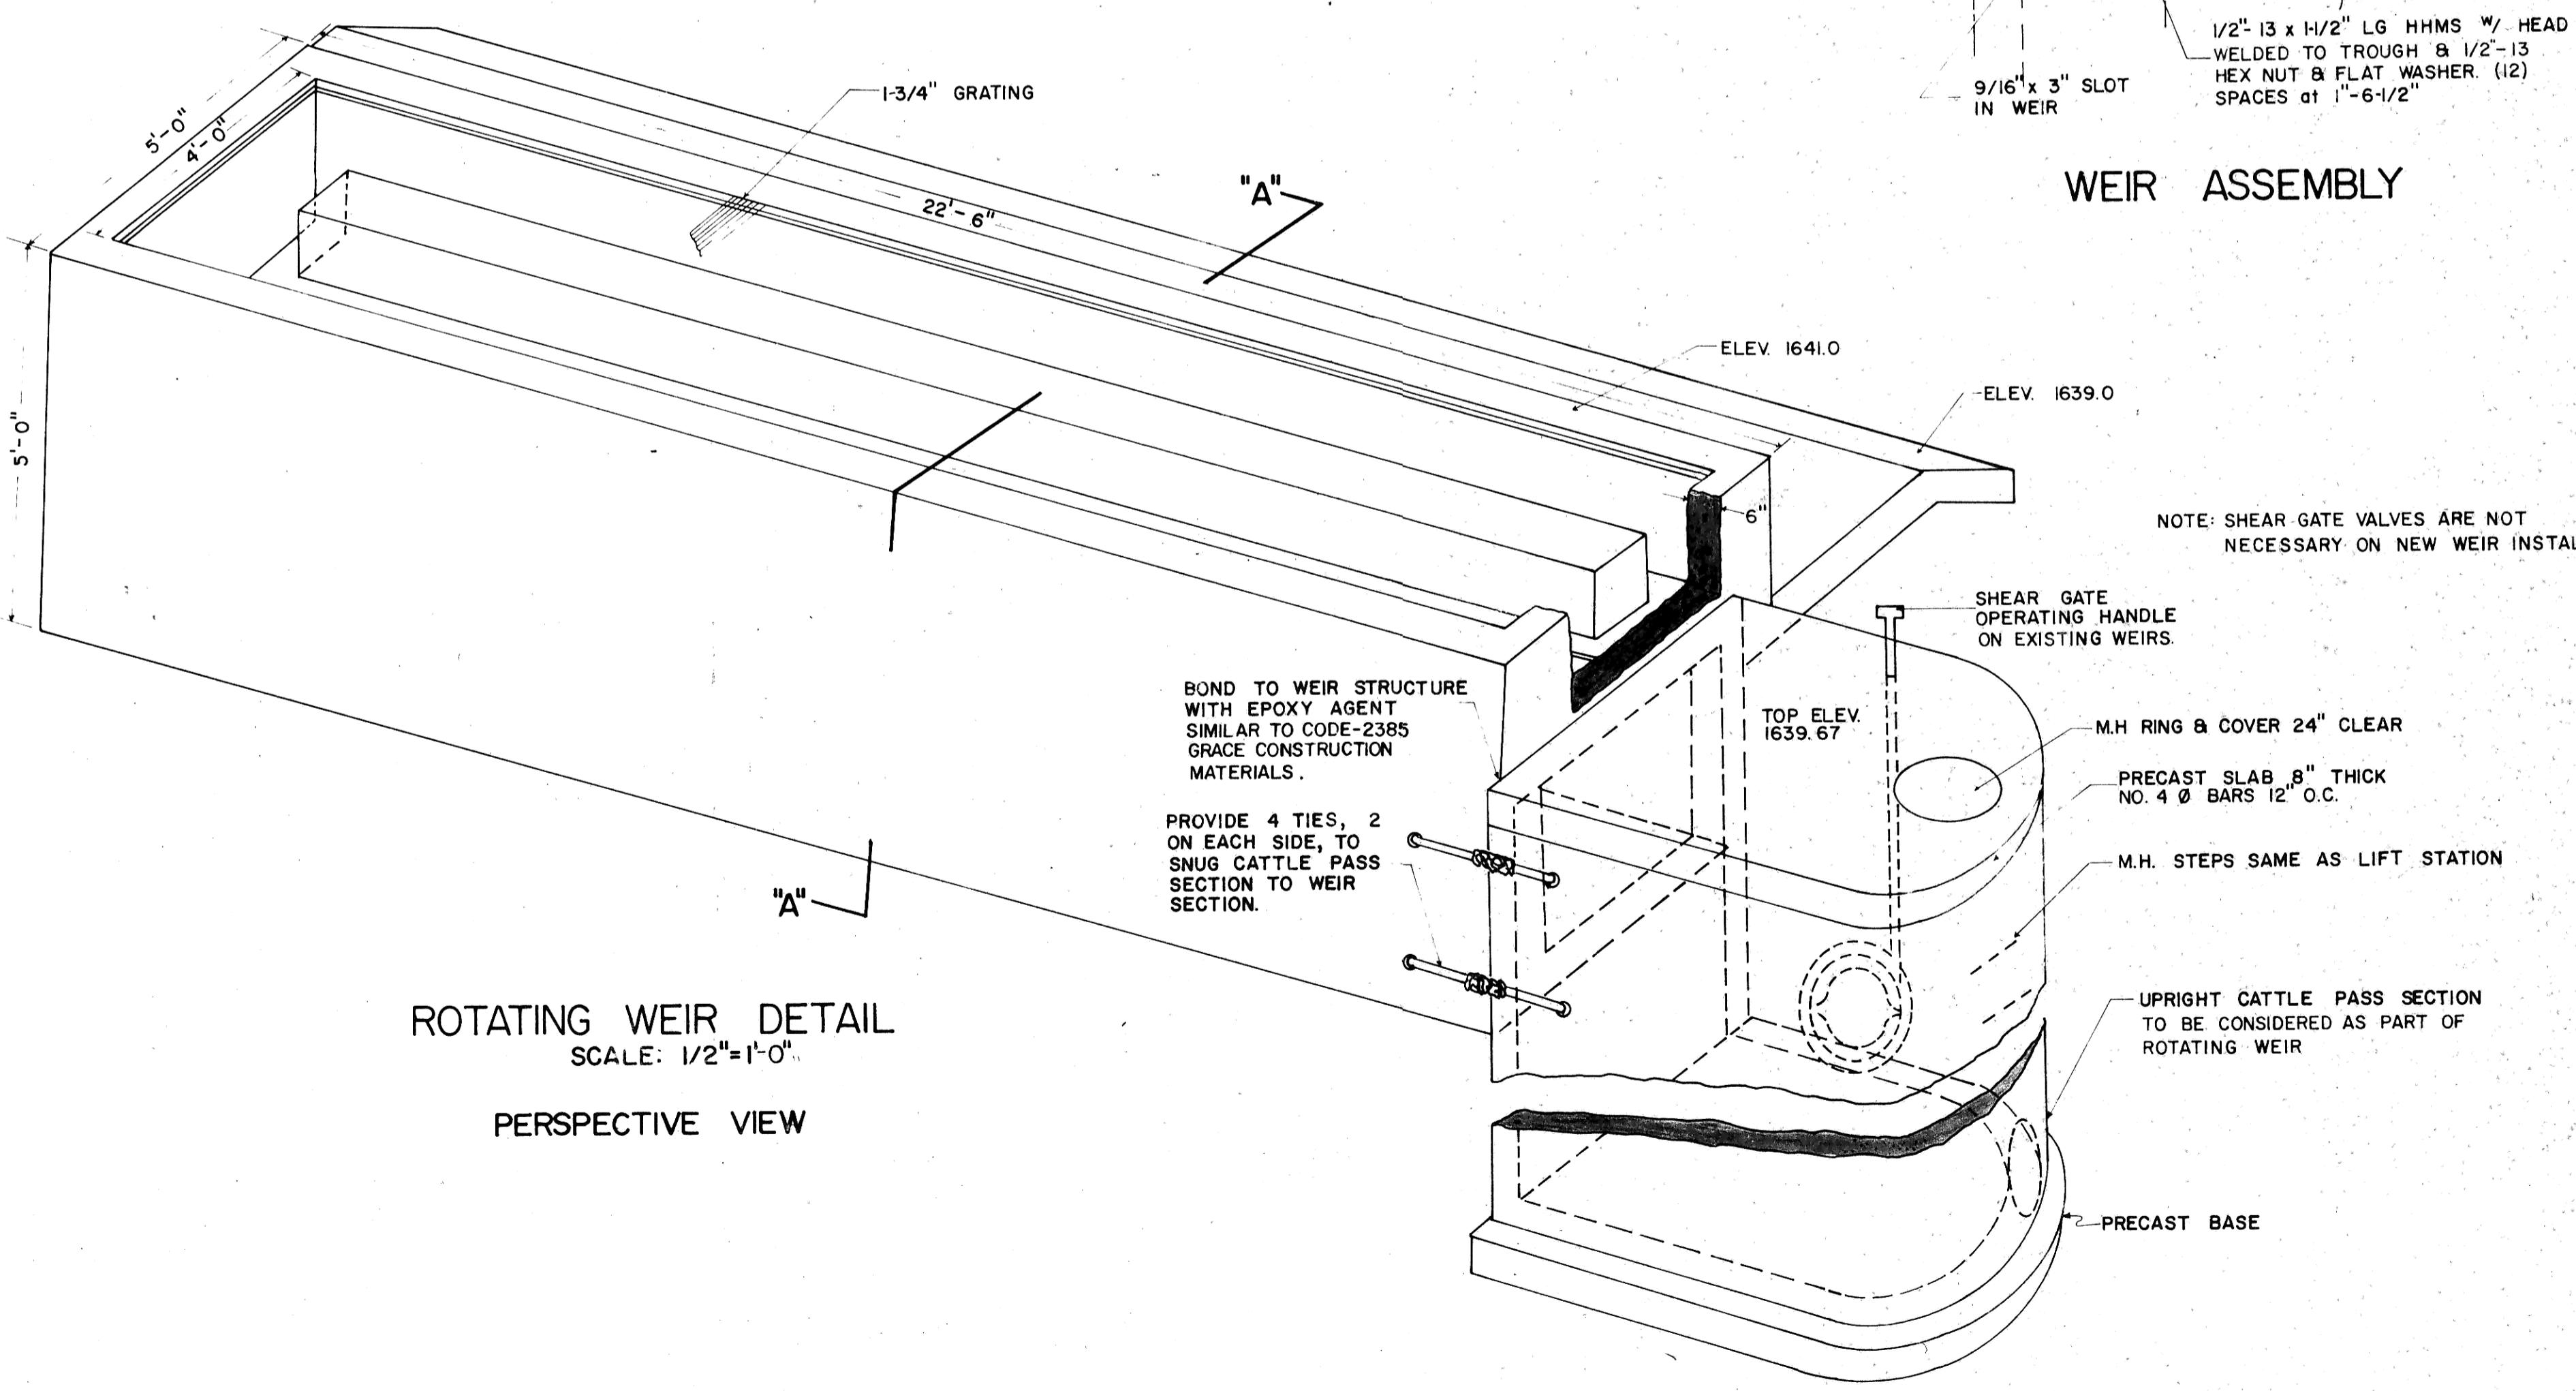


ROTATING WEIR DETAIL  
SCALE: 1/2"=1'-0"  
PERSPECTIVE VIEW

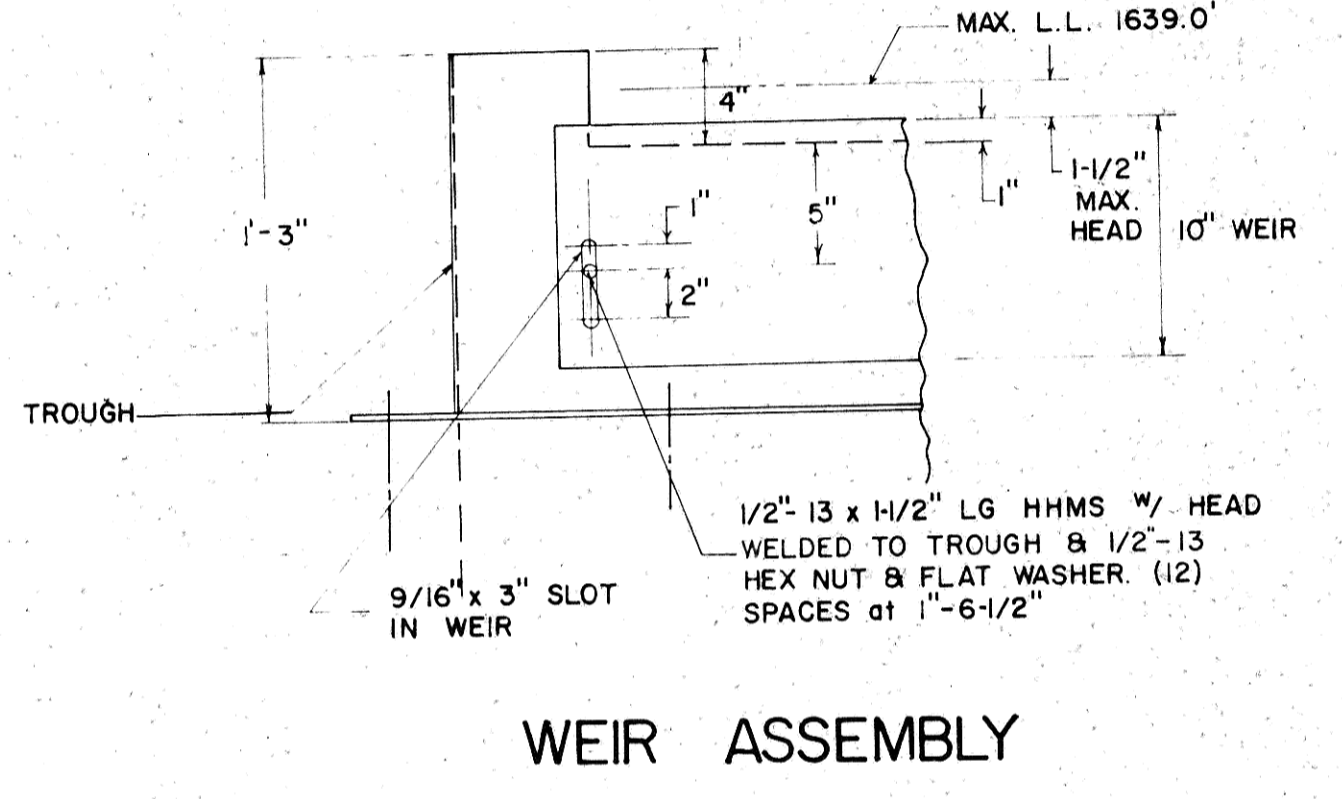


WEIR ASSEMBLY

NOTE: SHEAR GATE VALVES ARE NOT NECESSARY ON NEW WEIR INSTALLATIONS.

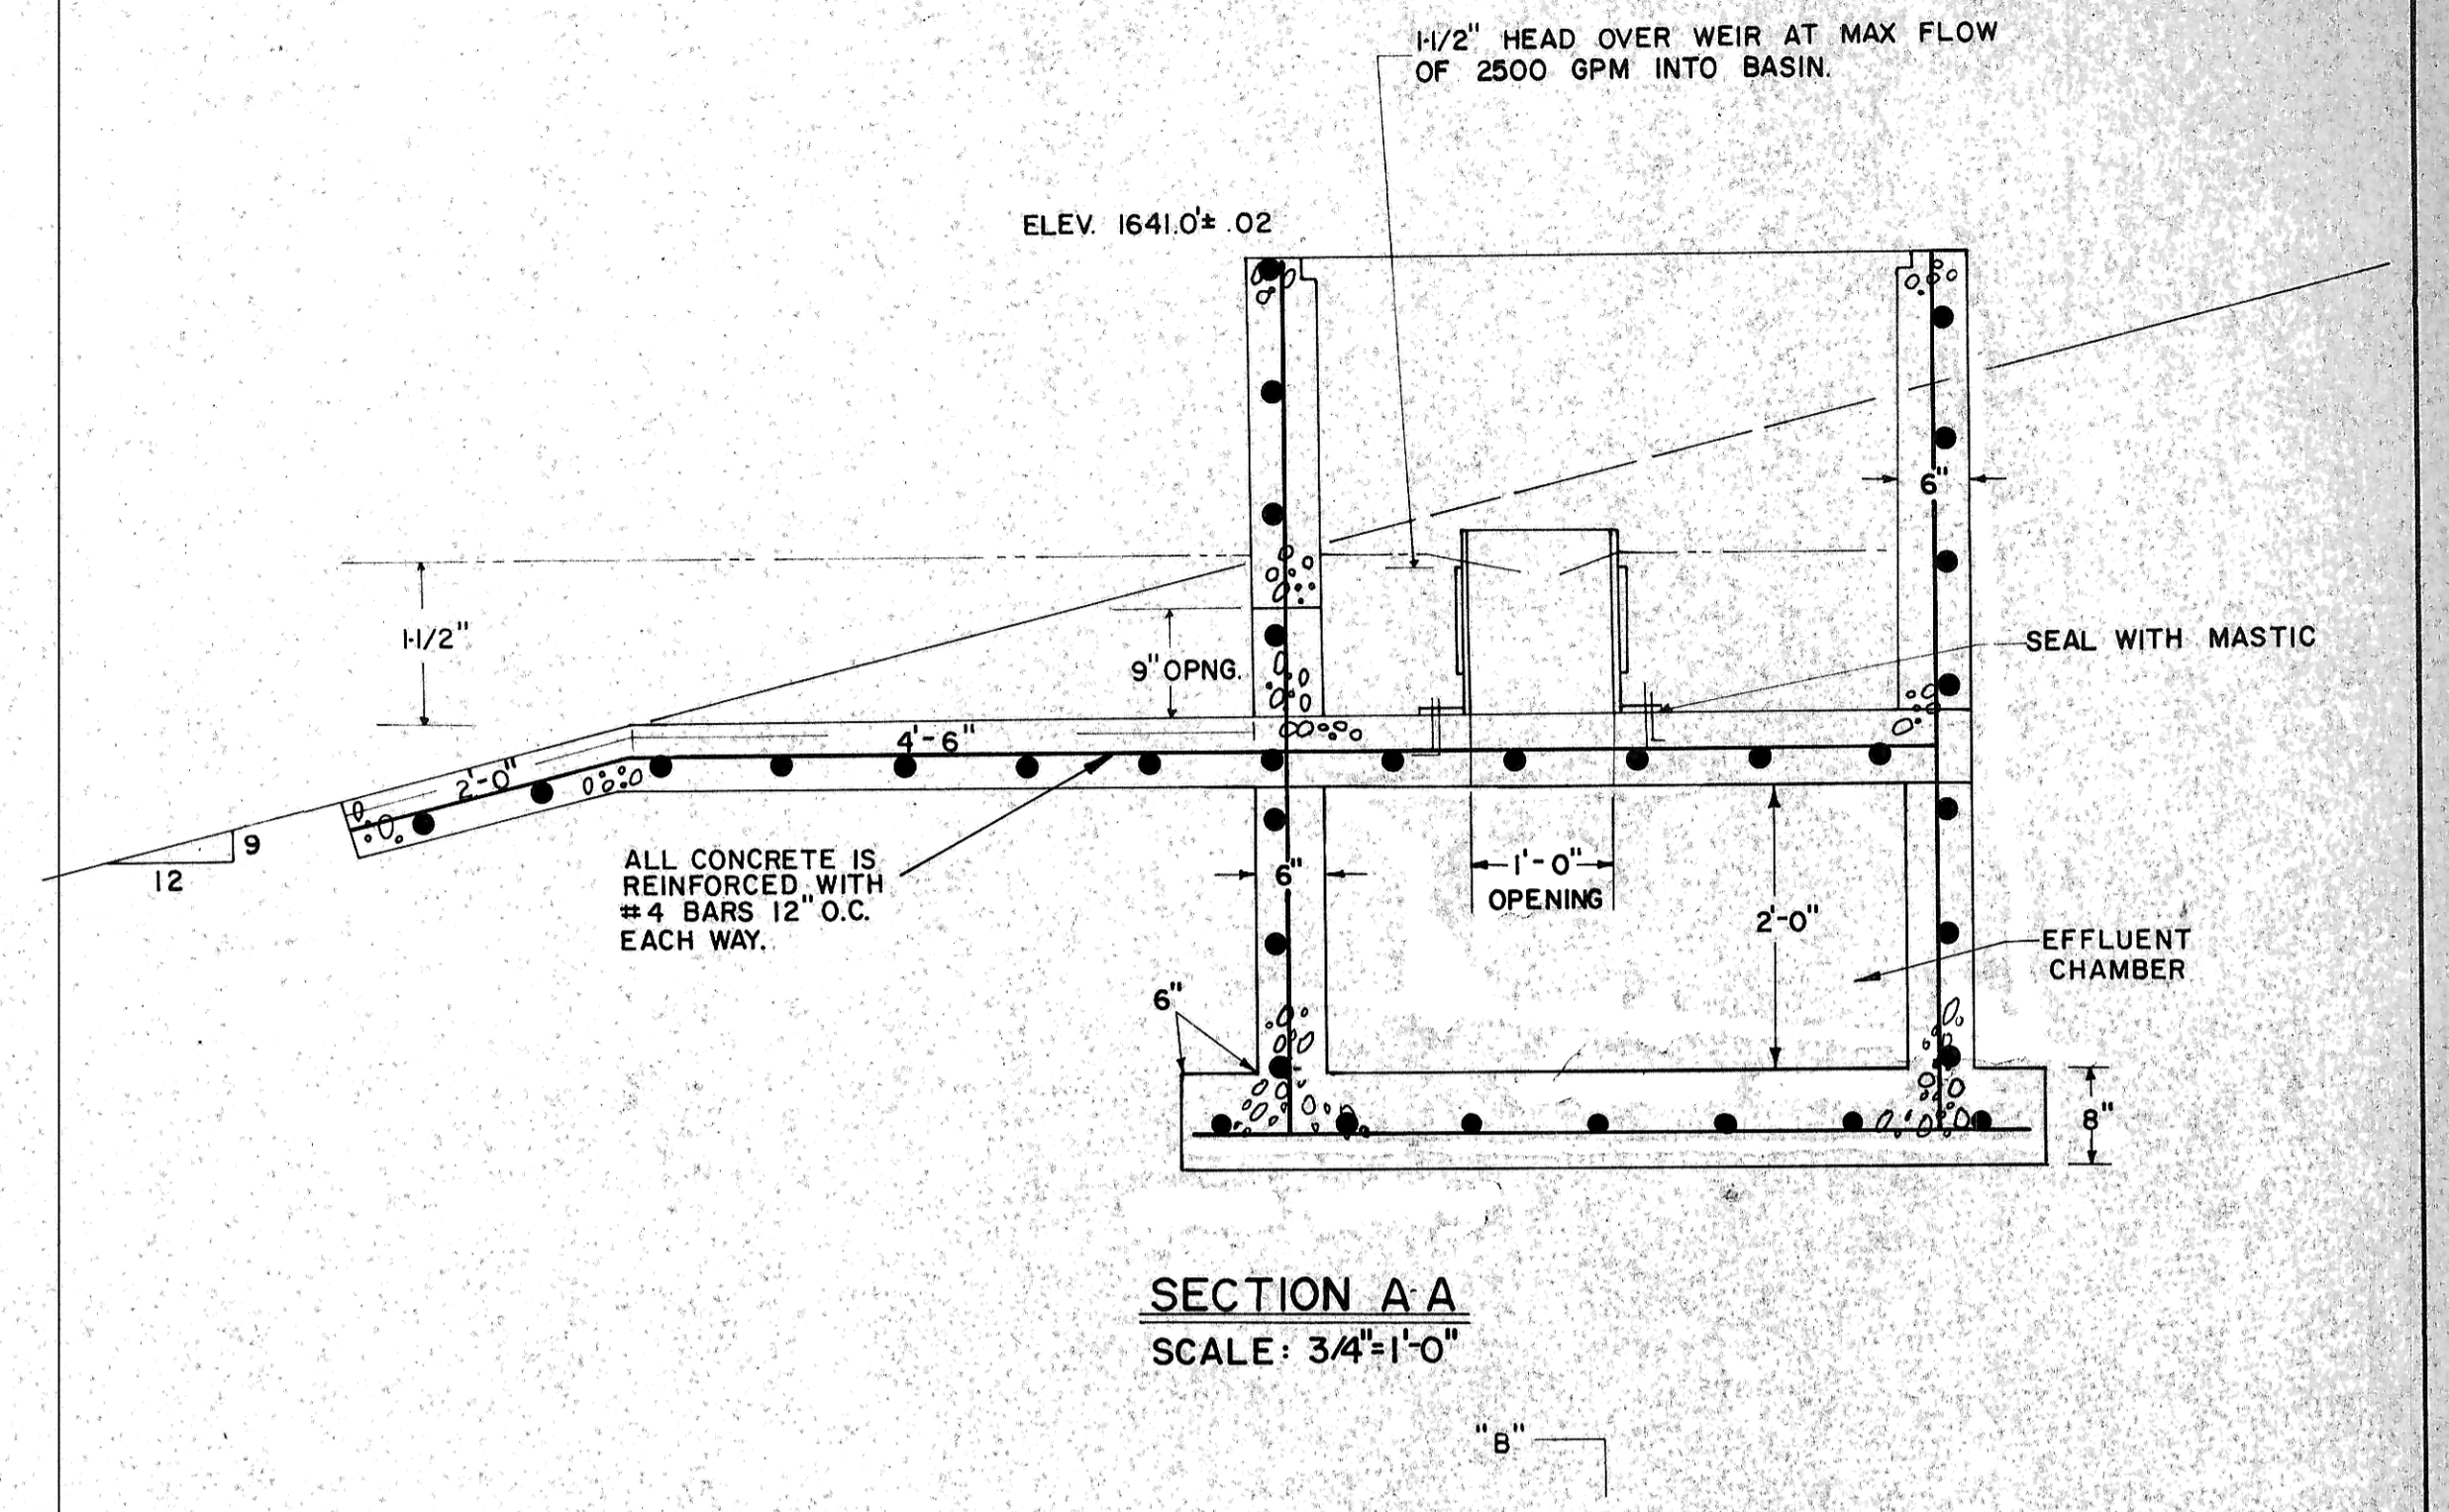

SECTION A-A  
SCALE: 3/4"=1'-0"

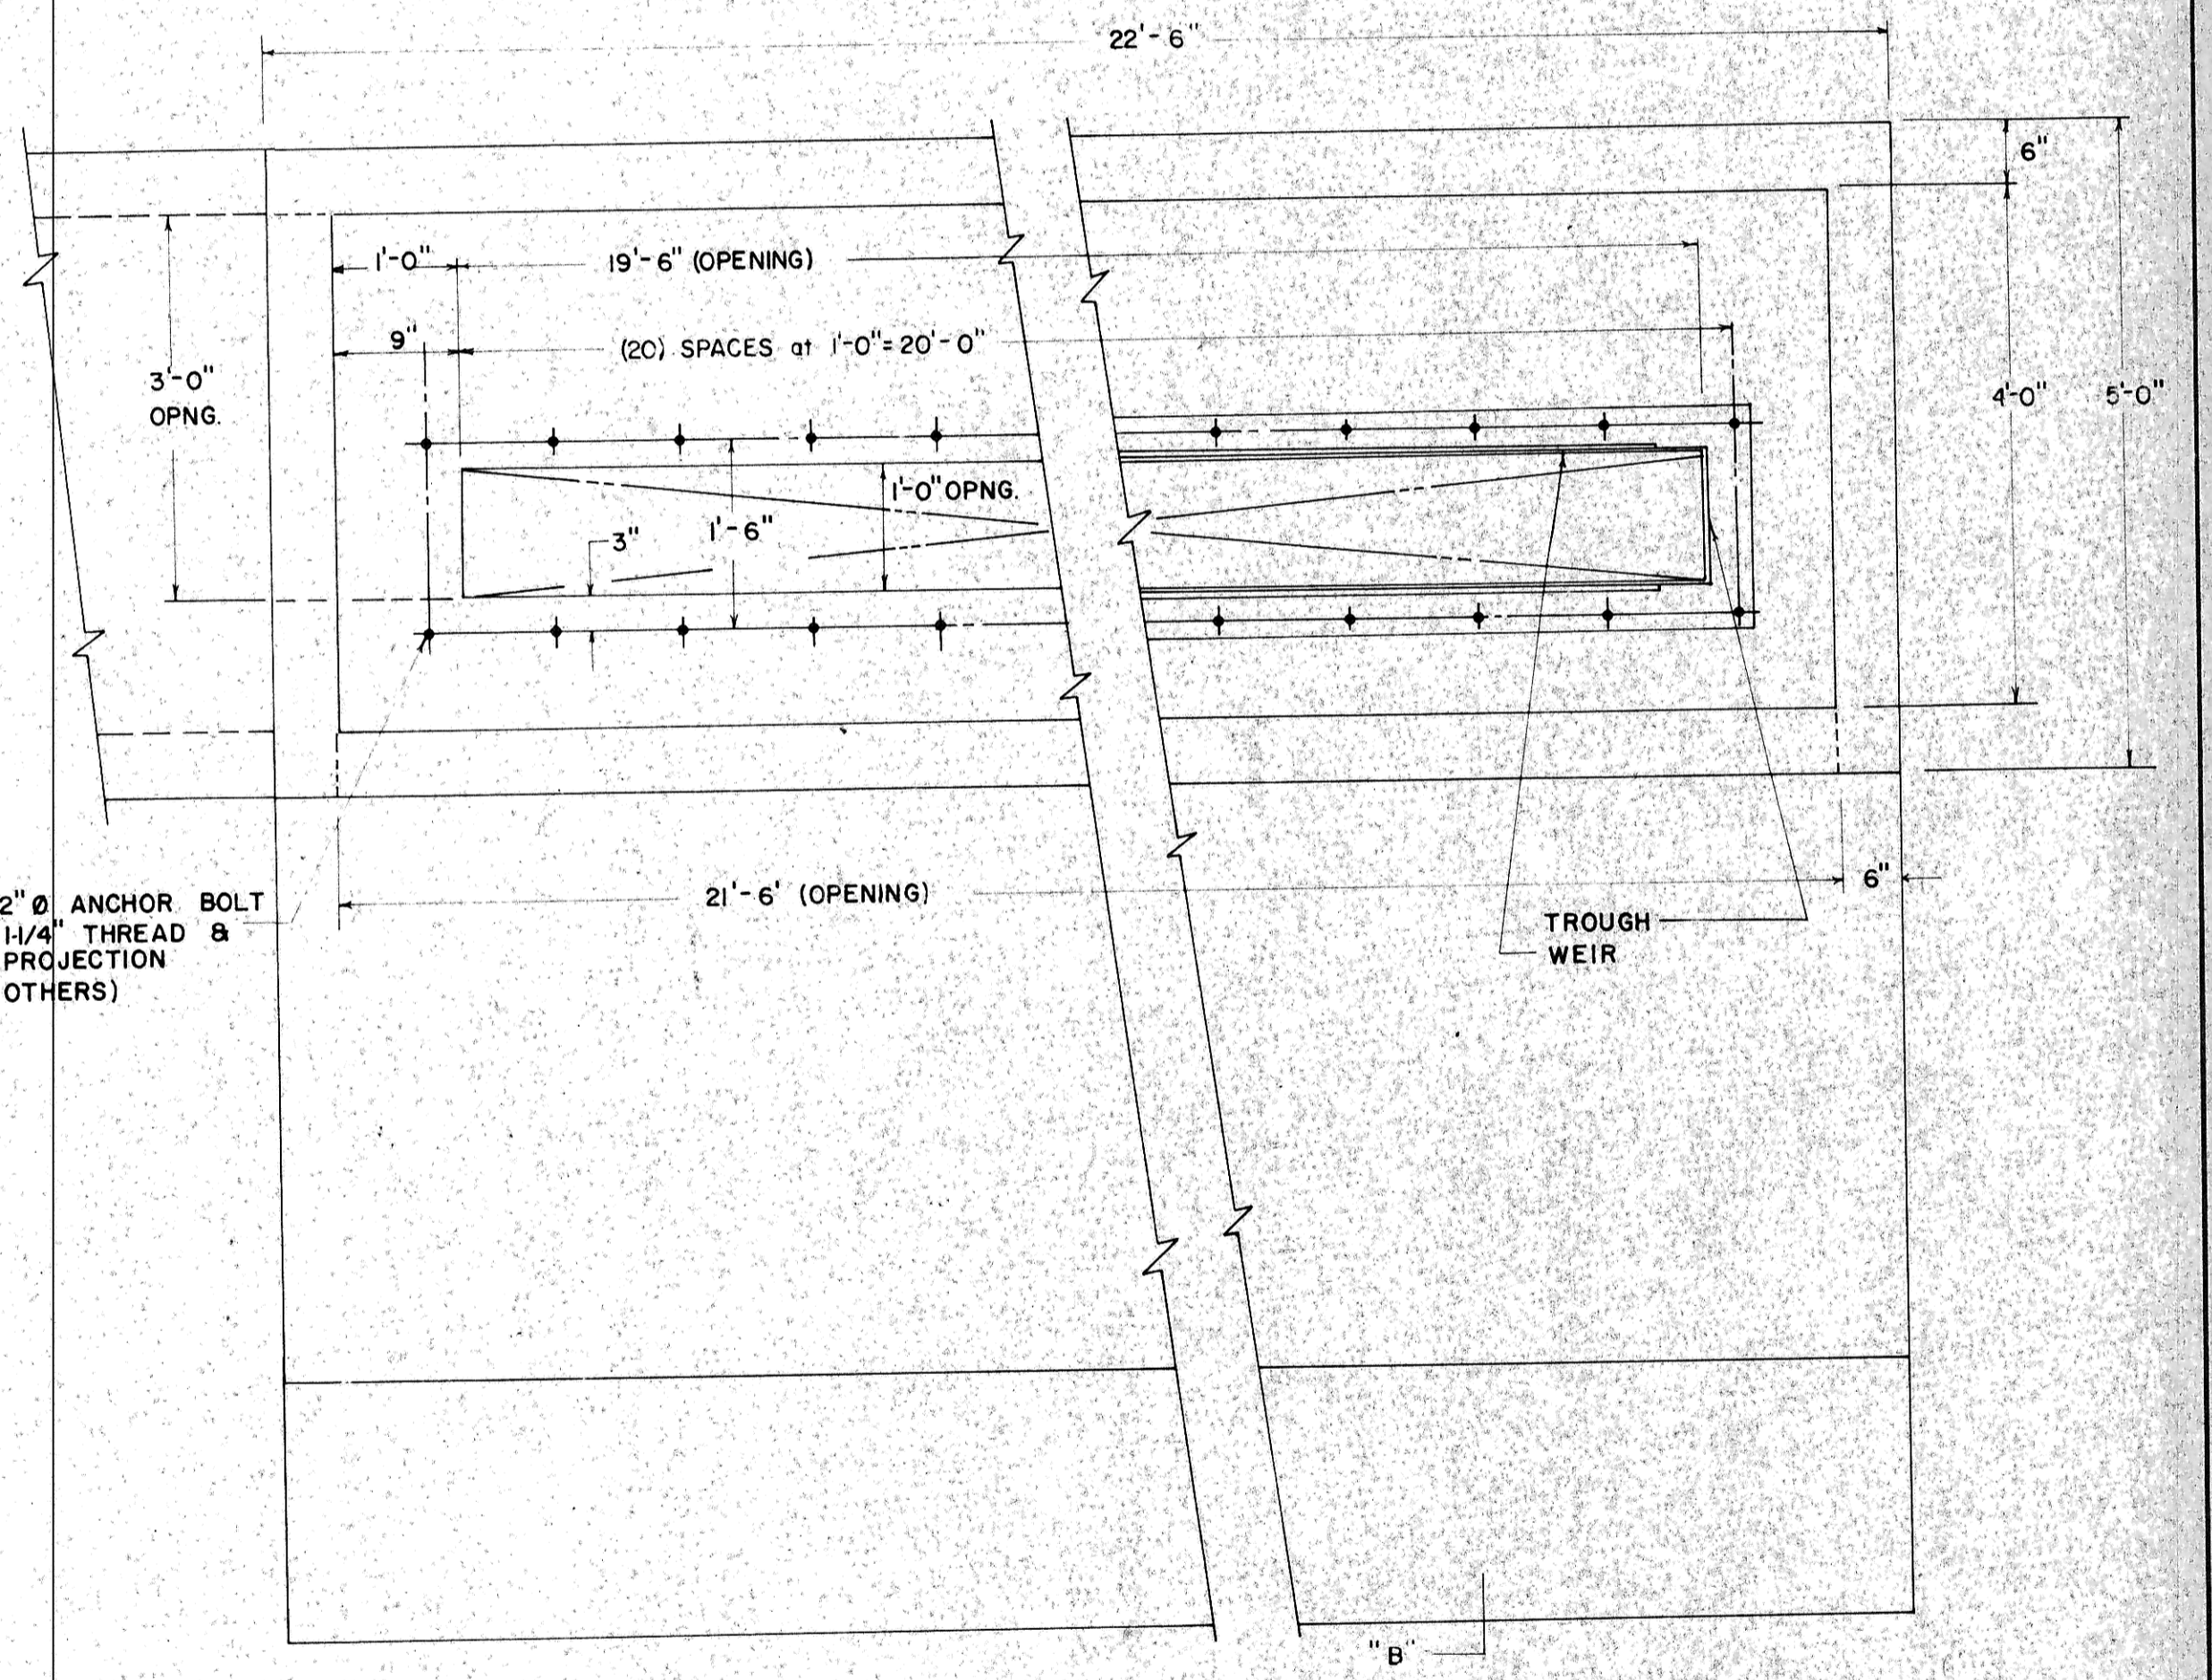

SCALE: 3/4"=1'-0"  
PLAN VIEW

UPGRADING WASTEWATER TREATMENT FACILITIES INCREMENT NO. 1 EPA NO. C 380325-03 CONTRACTOR'S RECORD DRAWINGS (AS BUILT)	
FILE NO.	DATE: SEPTEMBER 1976 REVISED: DECEMBER 1976
SHEET NO. 18 OF 23 SHEETS SCALE AS SHOWN	
DETAILS OF CIRCULAR ROTATING WEIR	
GEORGE J. TOMAN P. E. NO. 165	CONSULTING ENGINEER MANDAN, NORTH DAKOTA