



# AS BUILT WATER IMPROVEMENT PROJECT LAYOUT

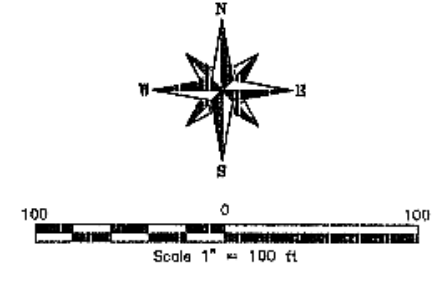

- LEGEND
- EXISTING
  - CULVERT
  - RAILROAD TRACKS
  - UTILITY PEDESTAL
  - ELECTRICAL BOX
  - POWER POLE
  - LIGHT POLE
  - GUY WIRE
  - INSTALLED HYDRANT
  - INSTALLED GATE VALVE
  - INSTALLED TEE
  - INSTALLED REDUCER
  - PLUG
  - HYDRANT
  - GATE VALVE
  - CURB STOP
  - MANHOLE
  - CATCH BASIN
  - MAILBOX
  - SIGN
  - CURB & GUTTER
  - FENCE
  - ELECTRIC
  - GAS
  - SANITARY SEWER
  - STORM SEWER
  - TELEPHONE
  - WATER

**CAUTION**  
 LOCATE ALL BURIED UTILITIES BEFORE DIGGING  
 OVERHEAD POWER

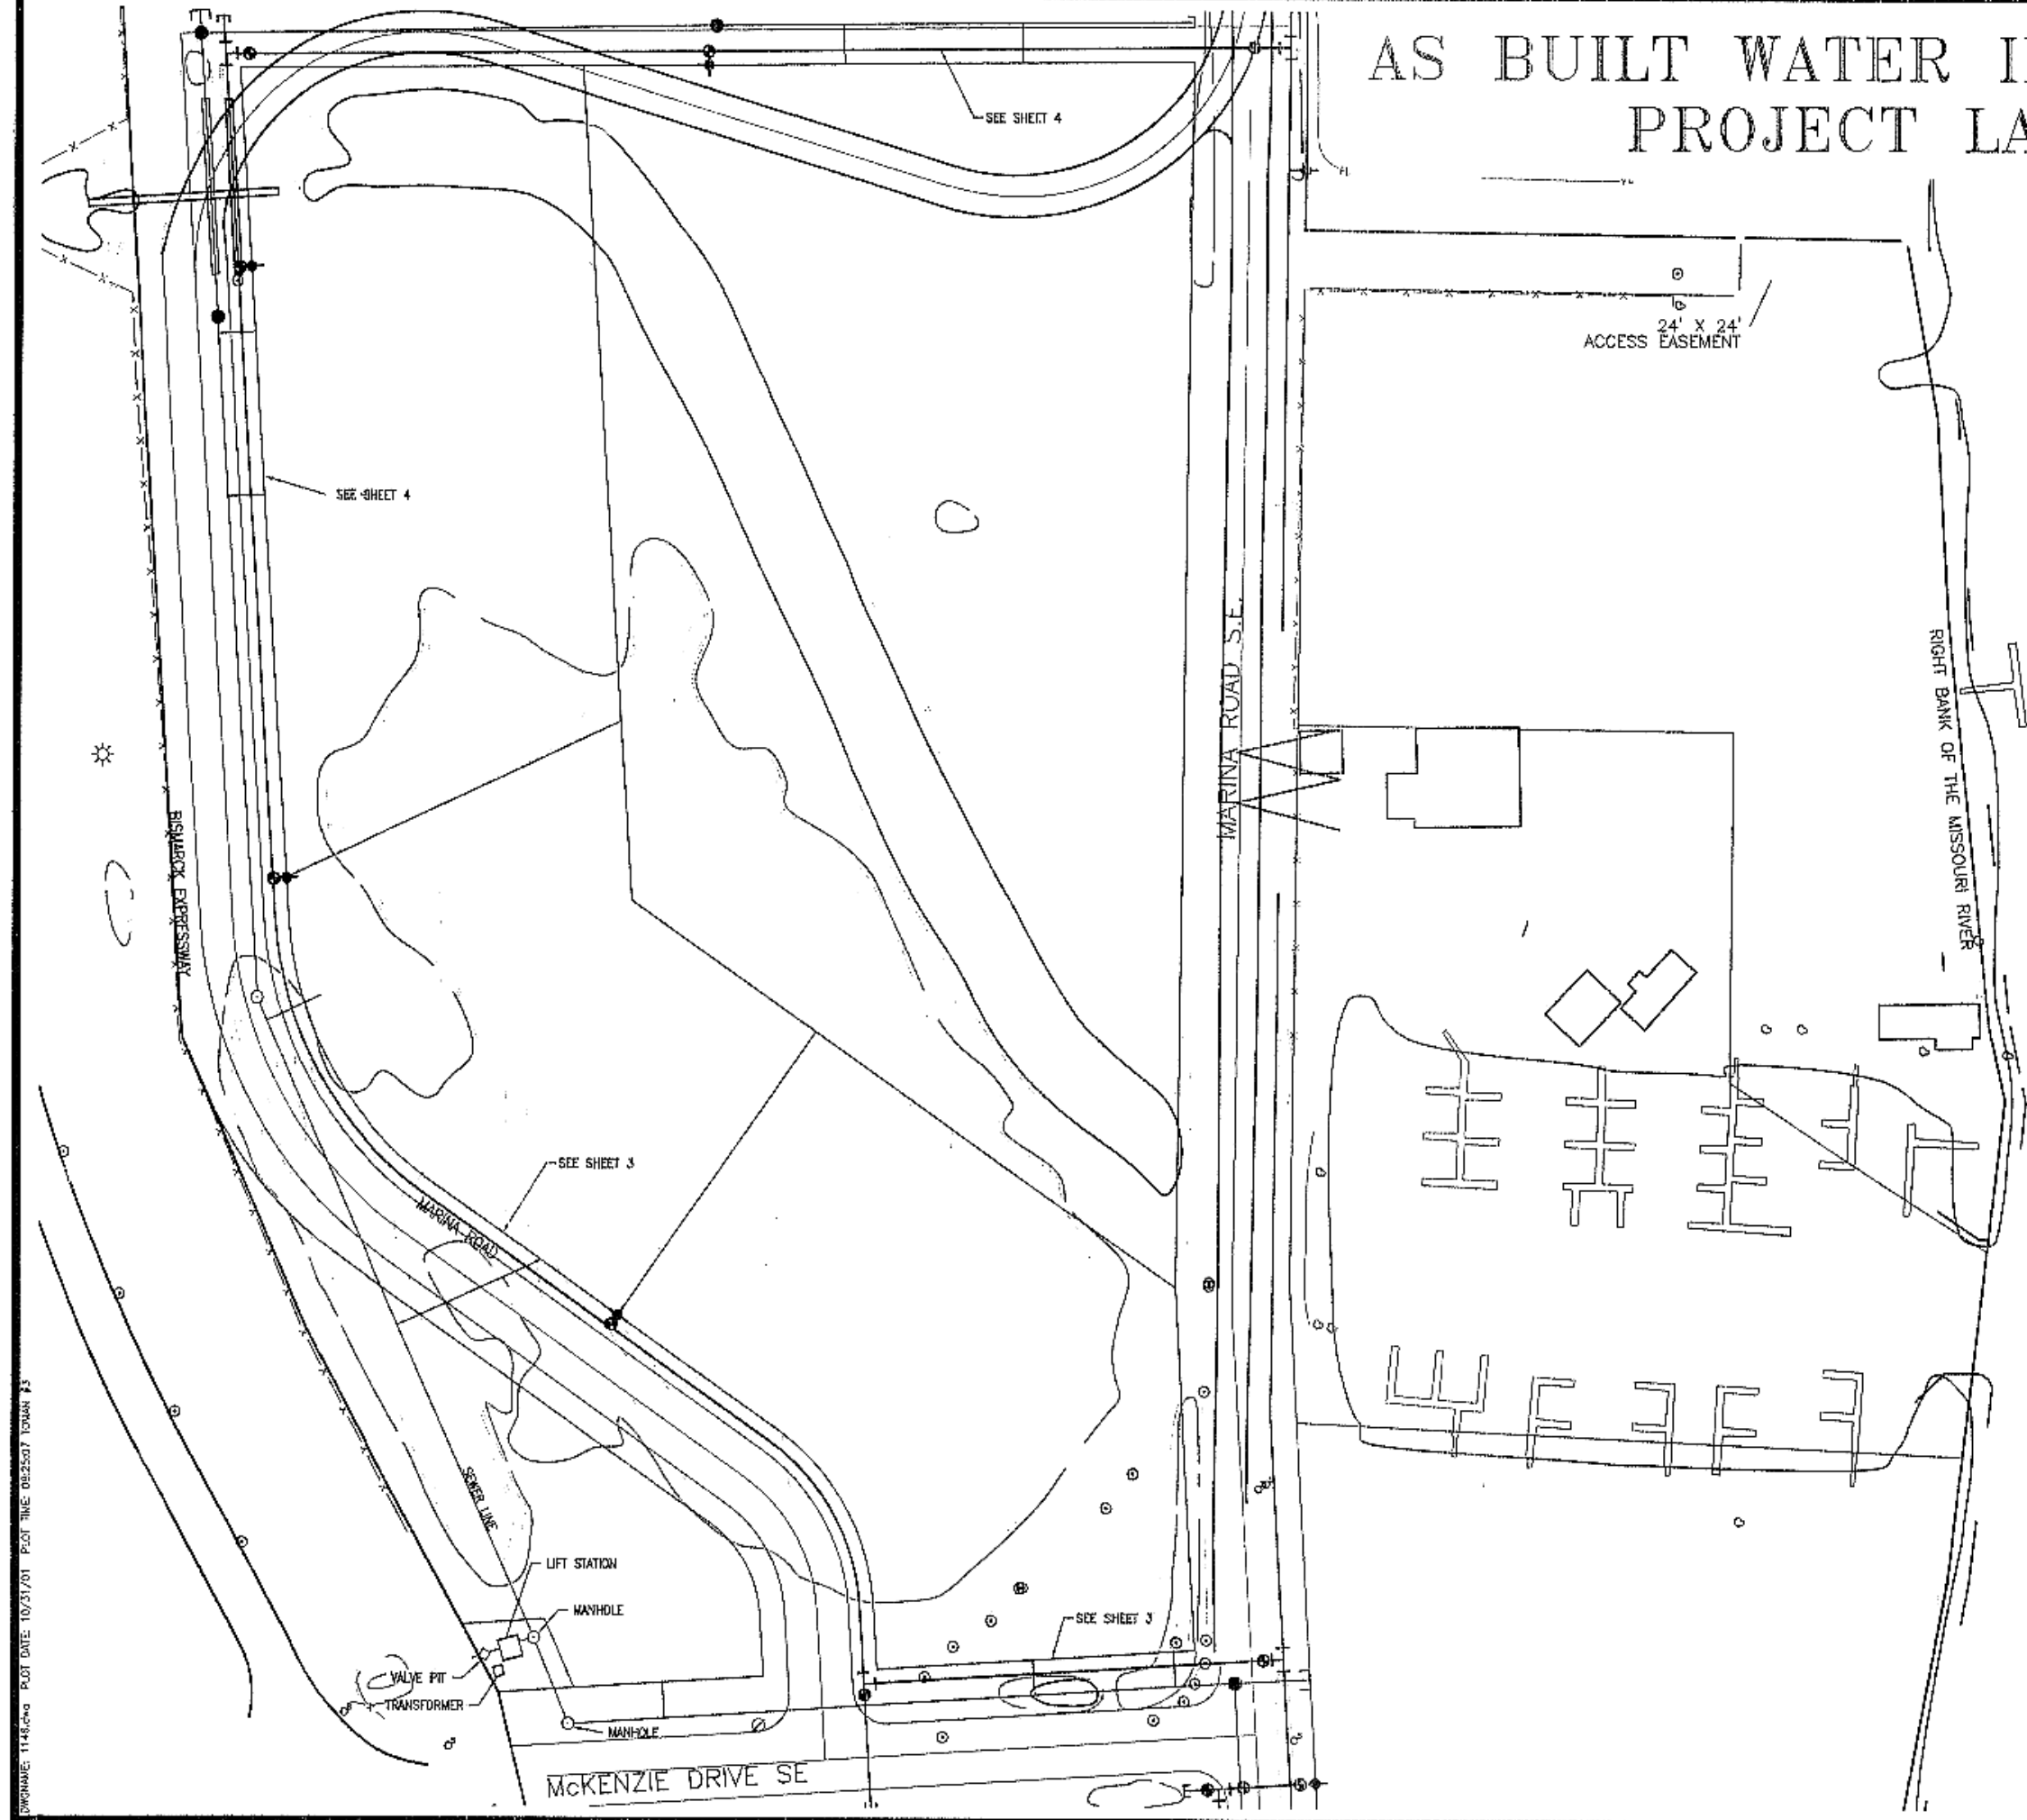

D:\15592\114662-1\11466.dwg, 1/20/2005 4:43:45 PM, 1:2  
 D:\15592\114662-1\11466.dwg PLOT DATE: 10/31/07 PLOT TIME: 09:25:57 TOWAN #3

**TOWAN ENGINEERING COMPANY**  
 CONSULTING CIVIL & ENVIRONMENTAL ENGINEERS  
 305 2ND ST. N.W. • MINNAPOLIS, MINN. 55354  
 (763) 663-6423

WATER IMPROVEMENT PLANS  
 AS BUILT PROJECT LAYOUT  
 CITY PROJECT NO. 98-8

PROJECT:	
TITLE: RICKER'S SECOND ADDITION	BY: JAM
NO. 1	DATE: 10/07/07
REVISIONS	DATE
NO. 1	DATE
SHEET NUMBER	
2	
OF 5 SHEETS	