





AS-BUILT WATER IMPROVEMENT PLANS MARINA ROAD

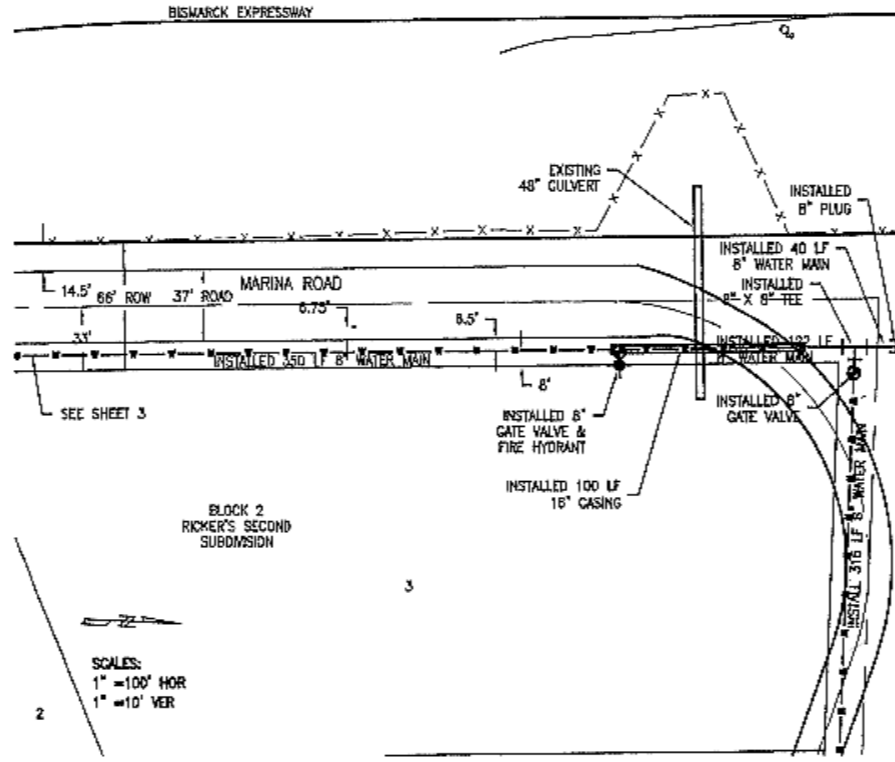

SCALES:
1" = 100' HOR
1" = 10' VER

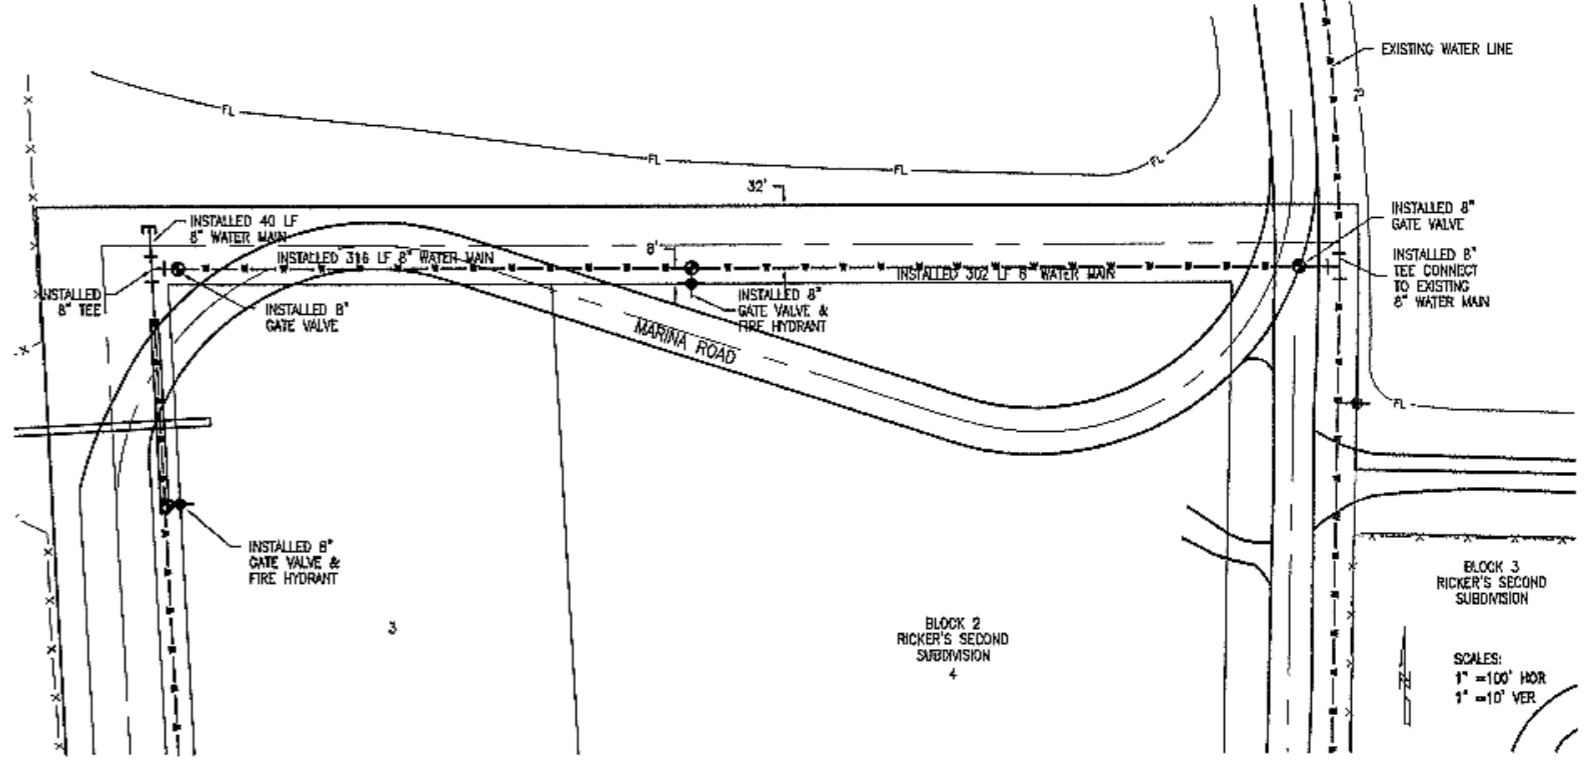

SCALES:
1" = 100' HOR
1" = 10' VER

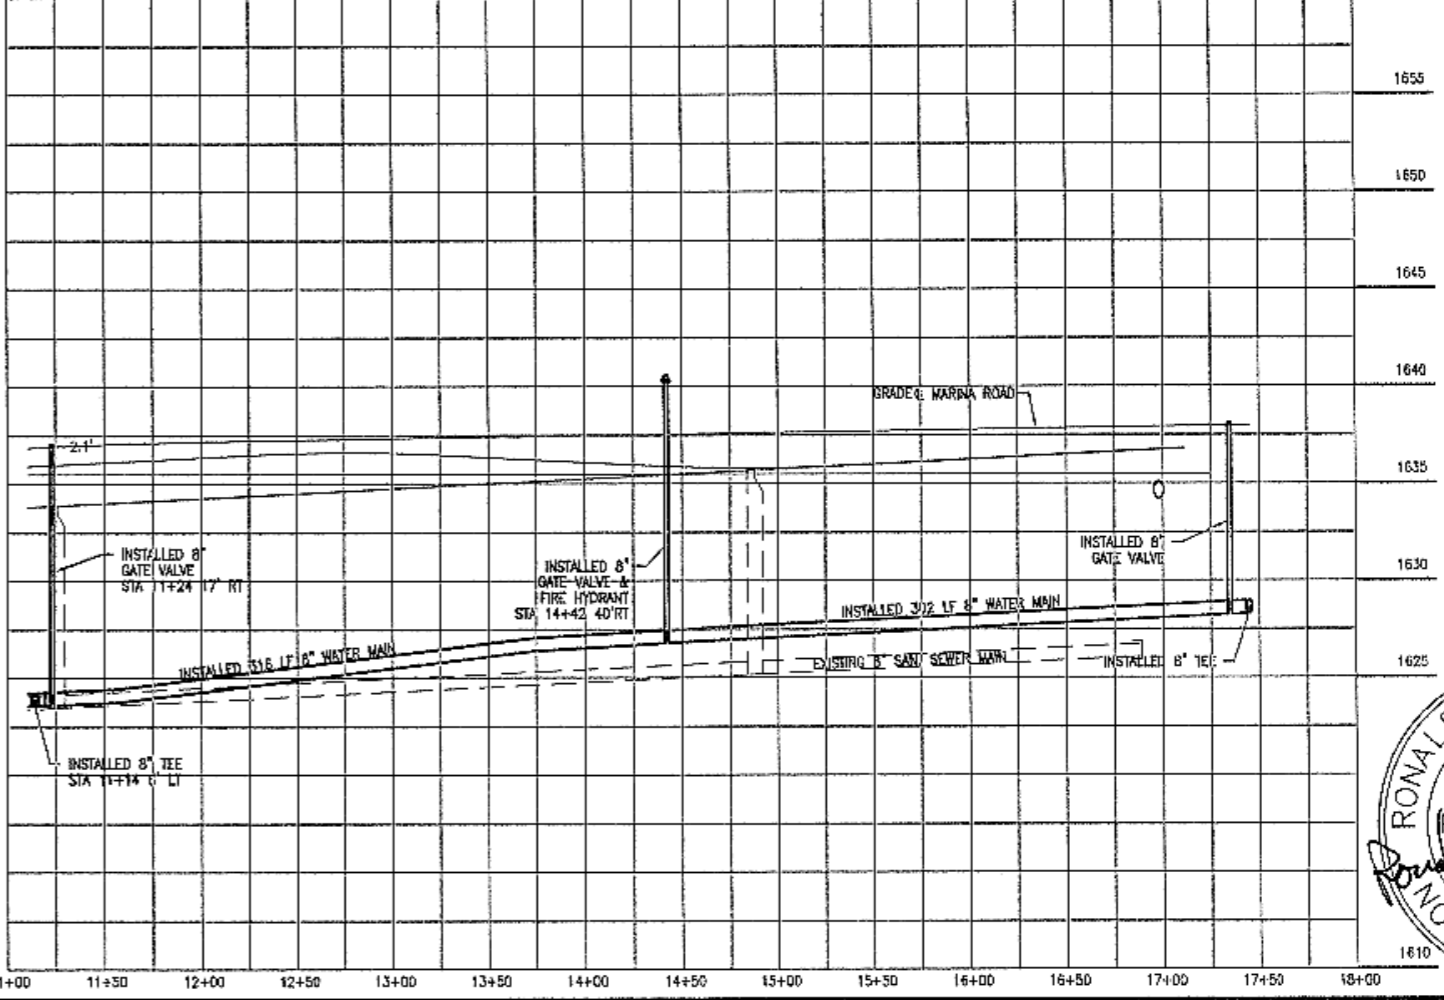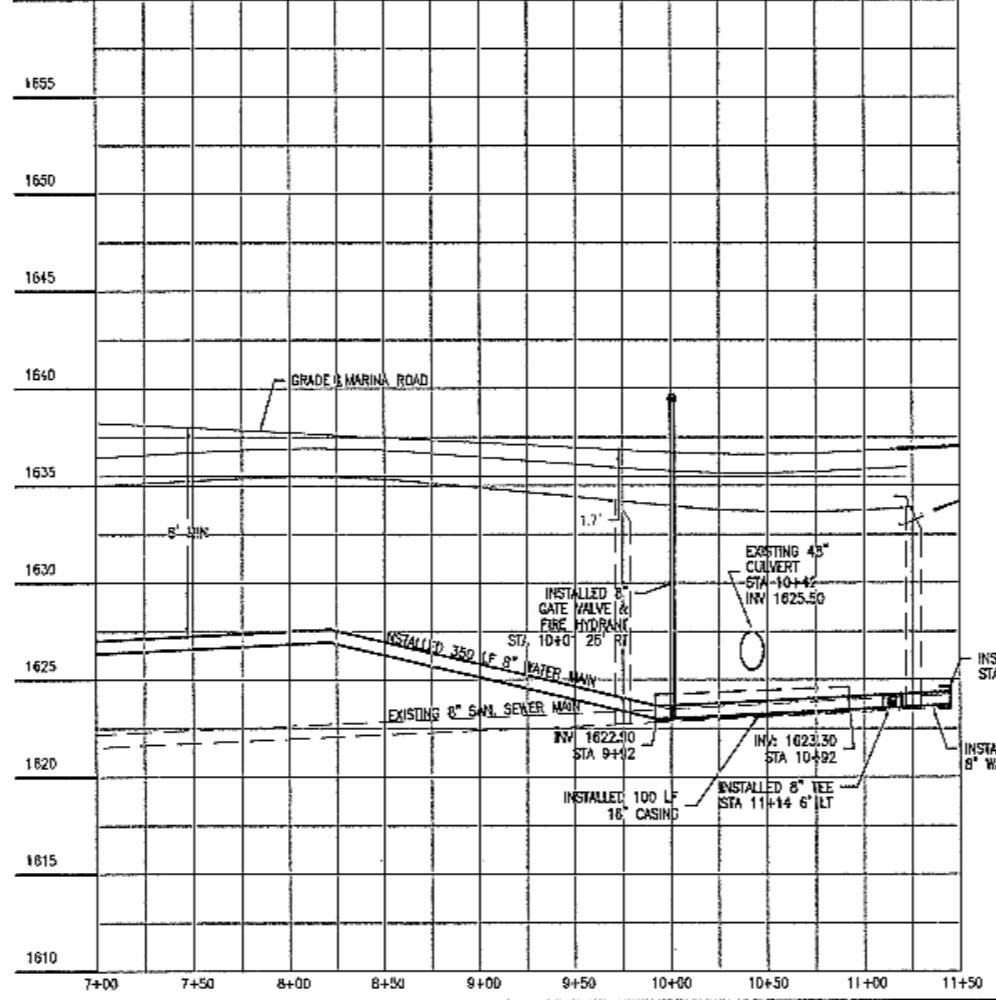

CAUTION
LOCATE ALL BURIED
UTILITIES BEFORE DIGGING
OVERHEAD POWER



D:\1000\114687-1\114687.dwg, 1/20/2005 4:41:27 PM, 1:2
DRAWING: 114687.dwg PLOT DATE: 06/27/05 PLOT TIME: 10:52:25 USER: JF

TOMAN ENGINEERING COMPANY
CONSULTING CIVIL & ENVIRONMENTAL ENGINEERS
508 2ND ST. N.E. (701) 663-6483

PLAN & PROFILES
MARINA ROAD
CITY PROJECT NO. 98-8 AS-BUILT

PROJECT: RICKER'S SECOND ADDITION

NO.	DATE	BY	REVISIONS
1	1/20/05	JF	ISSUE FOR PERMIT
2	4/7/05	JF	ISSUE FOR CONSTRUCTION

SHEET NUMBER
4
OF 5 SHEETS