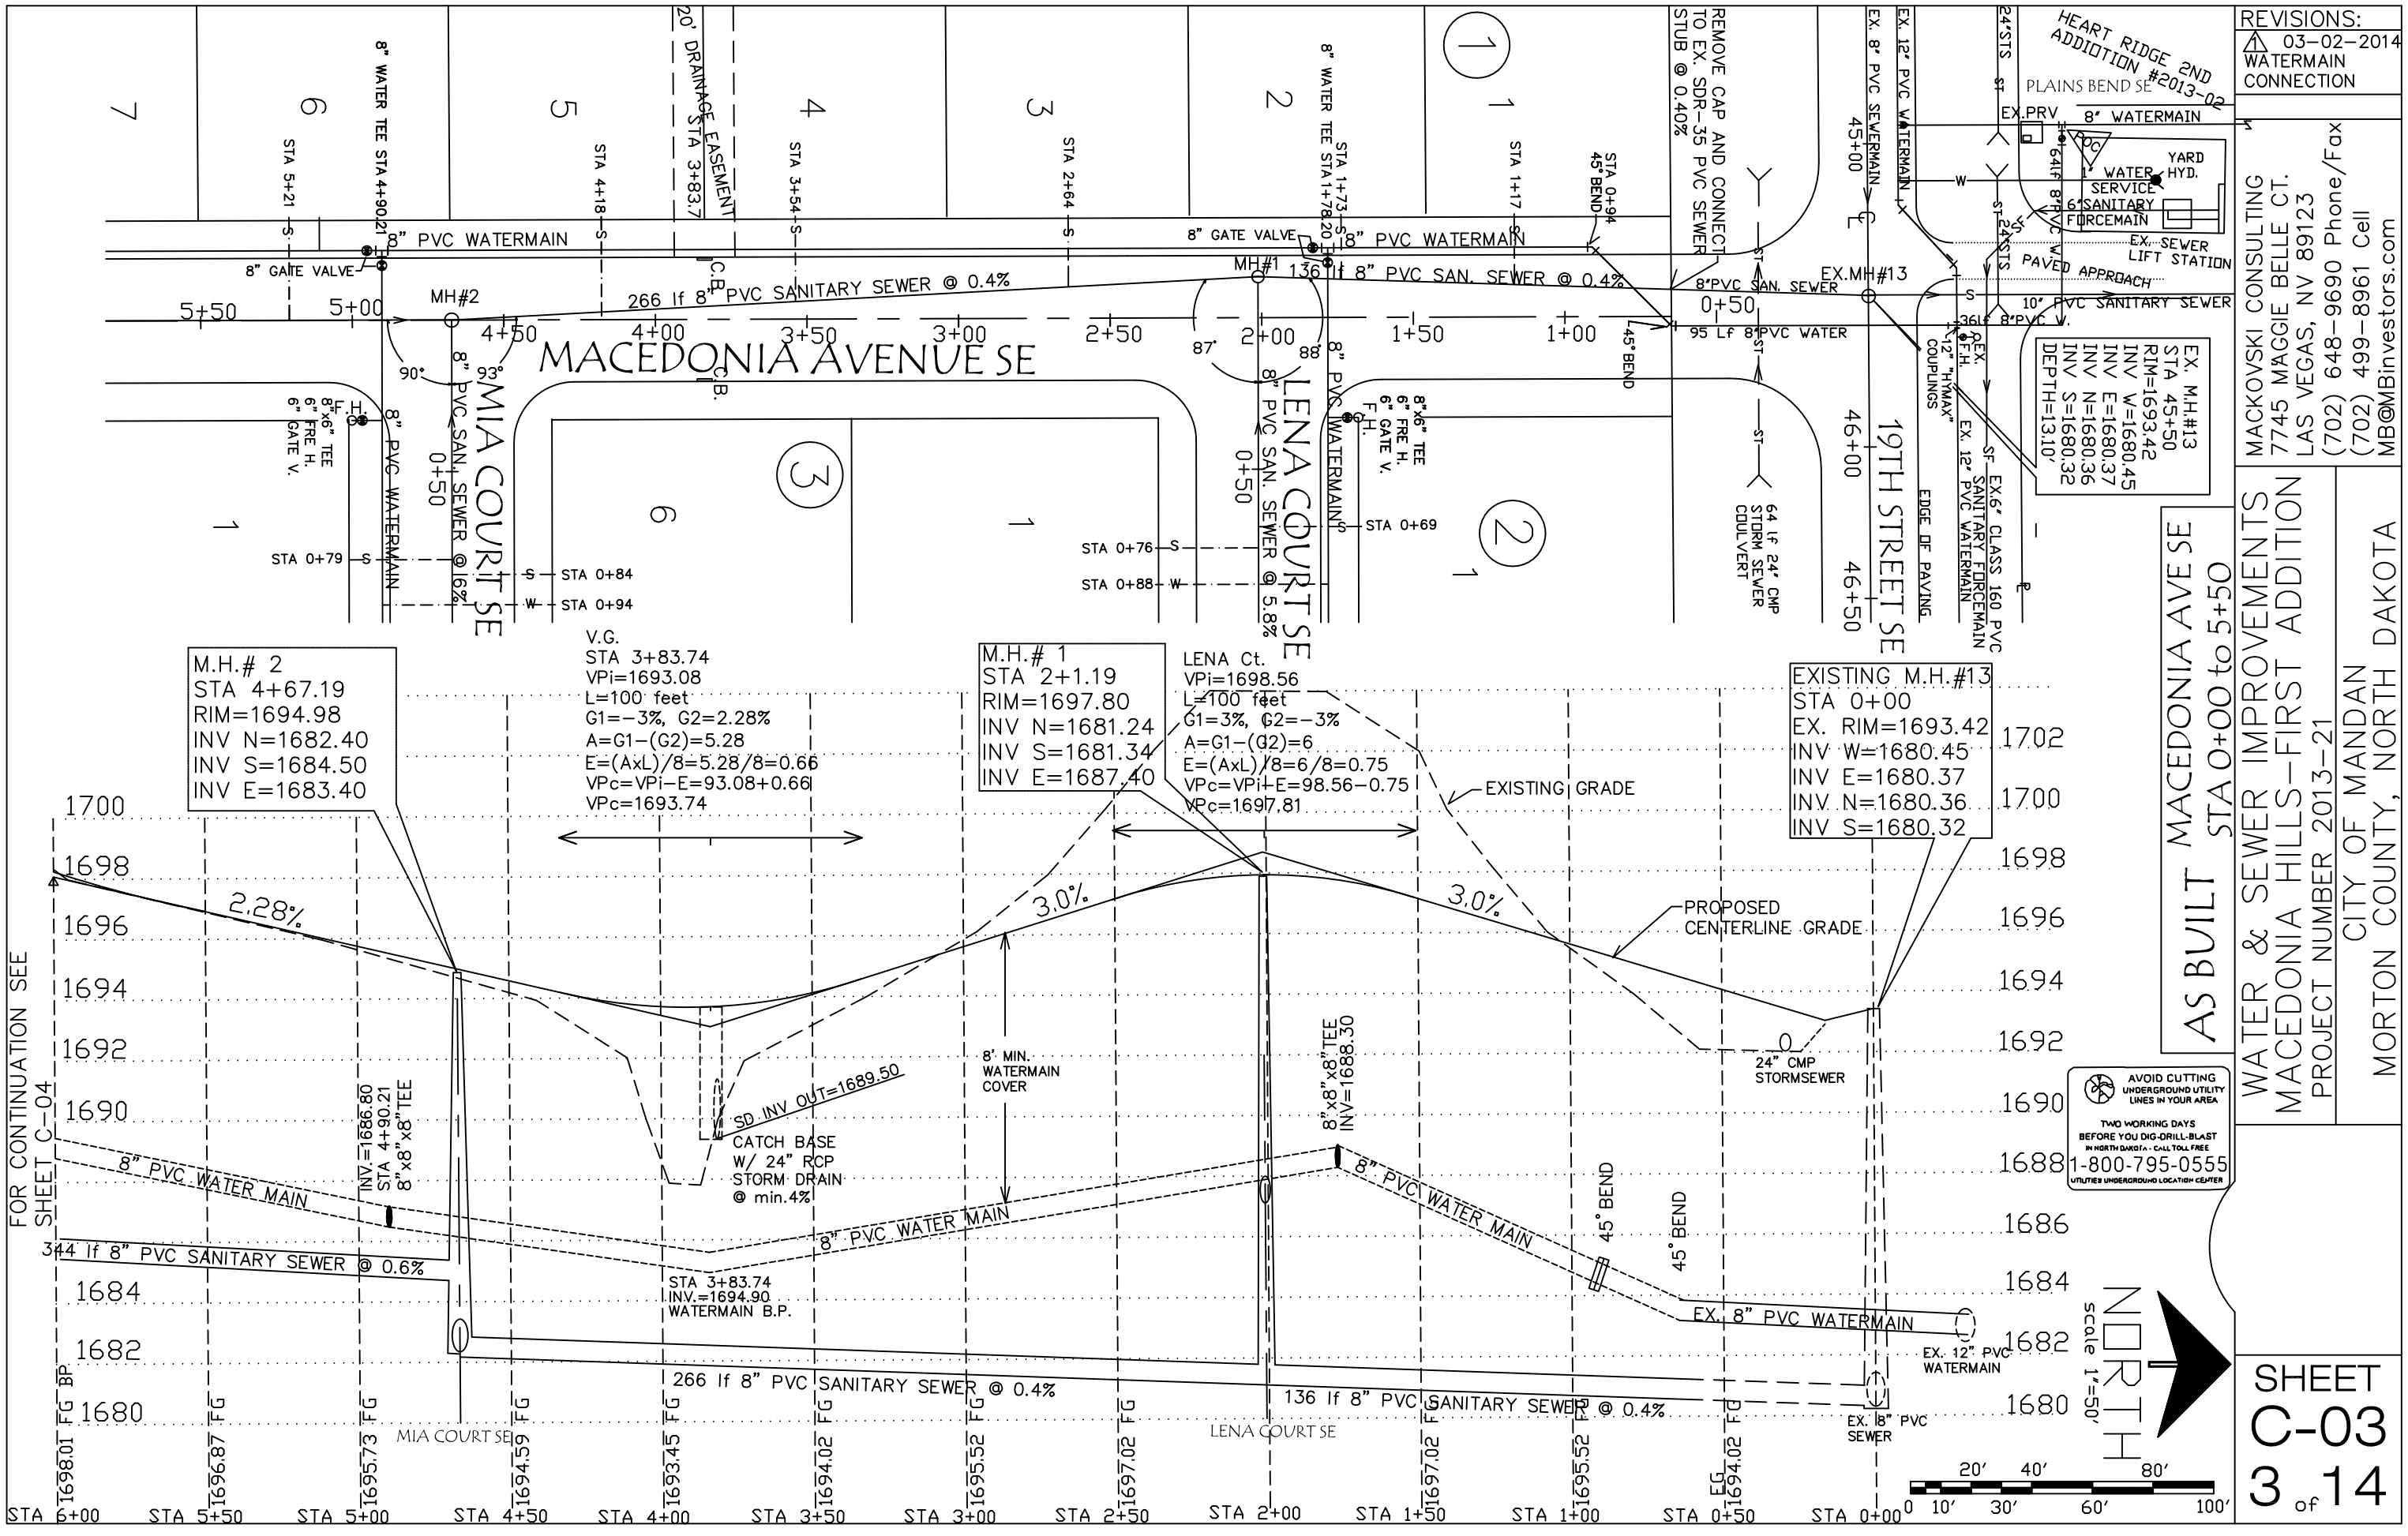

REVISIONS:
03-02-2014
WATERMAIN CONNECTION

MACKOVSKI CONSULTING
7745 MAGGIE BELLE CT.
LAS VEGAS, NV 89123
(702) 648-9690 Phone/Fax
(702) 499-8961 Cell
MB@MBinvestors.com

AS BUILT

WATER & SEWER IMPROVEMENTS MACEDONIA HILLS-FIRST ADDITION

PROJECT NUMBER 2013-21

CITY OF MANDAN
MORTON COUNTY, NORTH DAKOTA

MACEDONIA AVE SE
STA 0+00 to 5+50

AVOID CUTTING UNDERGROUND UTILITY LINES IN YOUR AREA
TWO WORKING DAYS BEFORE YOU DIG-DRILL-BLAST IN NORTH DAKOTA - CALL TOLL FREE
1-800-795-0555
UTILITIES UNDERGROUND LOCATION CENTER

SHEET
C-03
3 of 14