

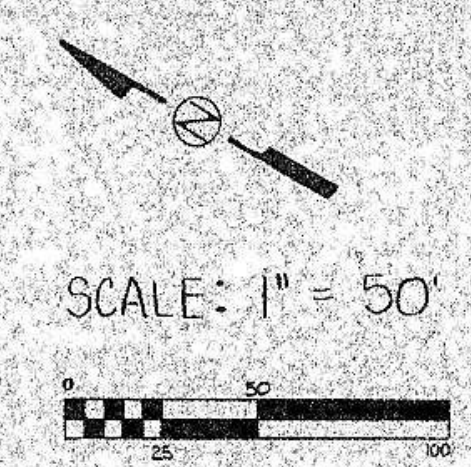


PLAN
 SUPERVISOR: _____
 CHECKED: _____
 DATE: _____
 NO. OF PAGES CHECKED: _____
 NO. _____

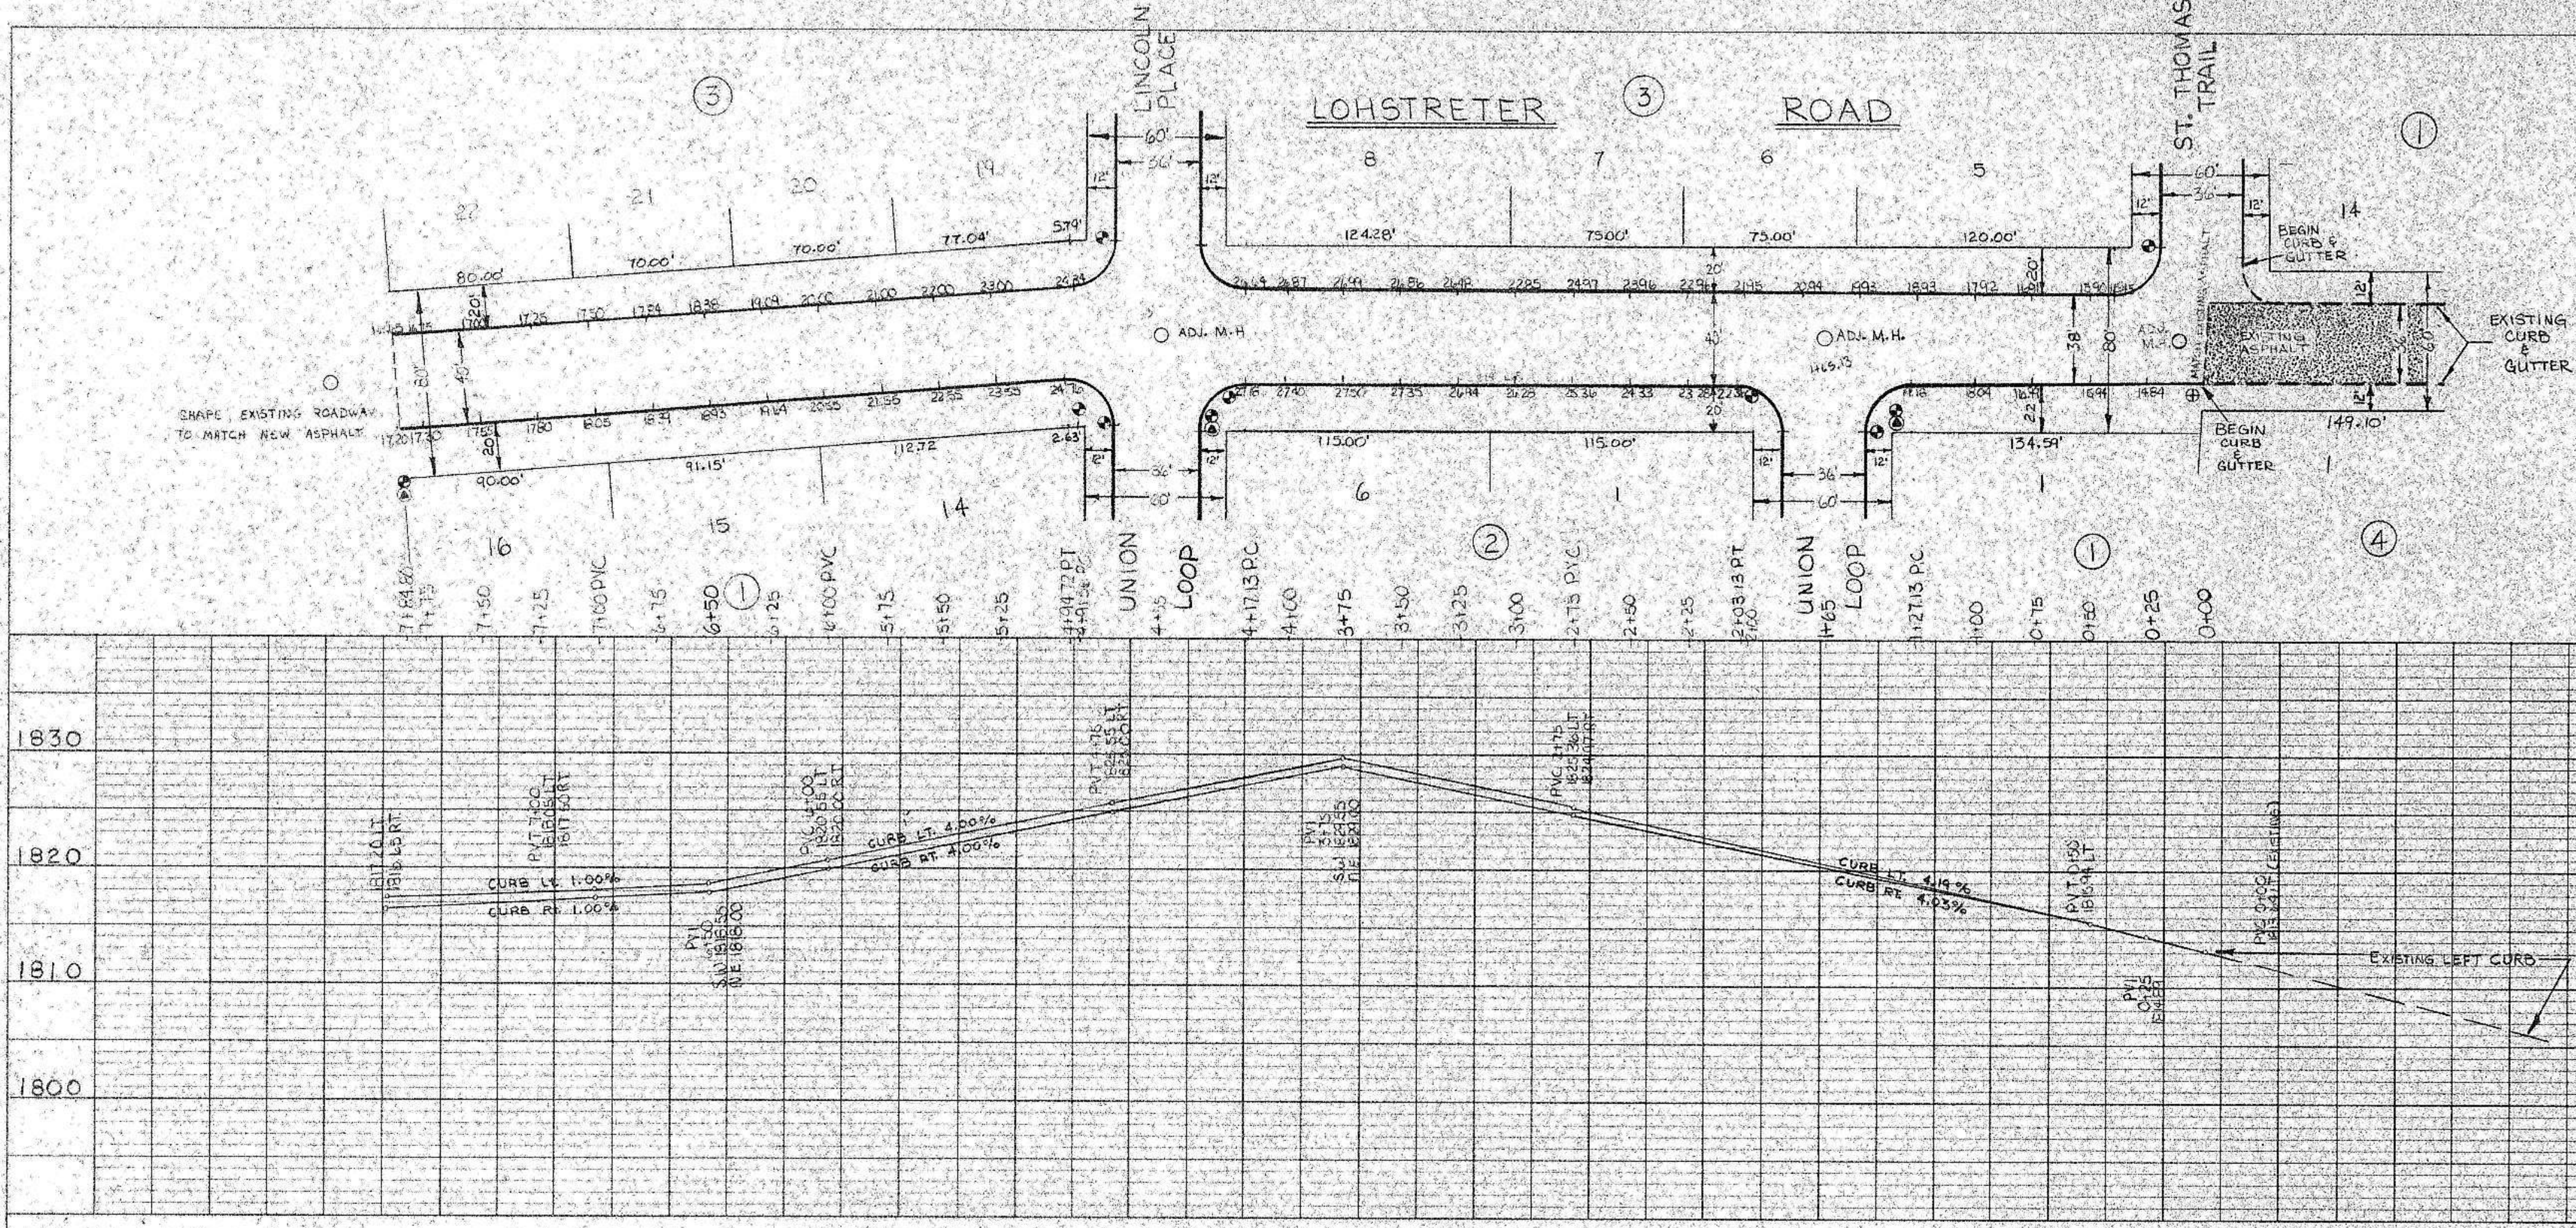


ALL RADII 20' UNLESS OTHERWISE NOTED.

PROFILE
 SUPERVISOR: _____
 CHECKED: _____
 DATE: _____
 NO. OF PAGES CHECKED: _____
 NO. _____

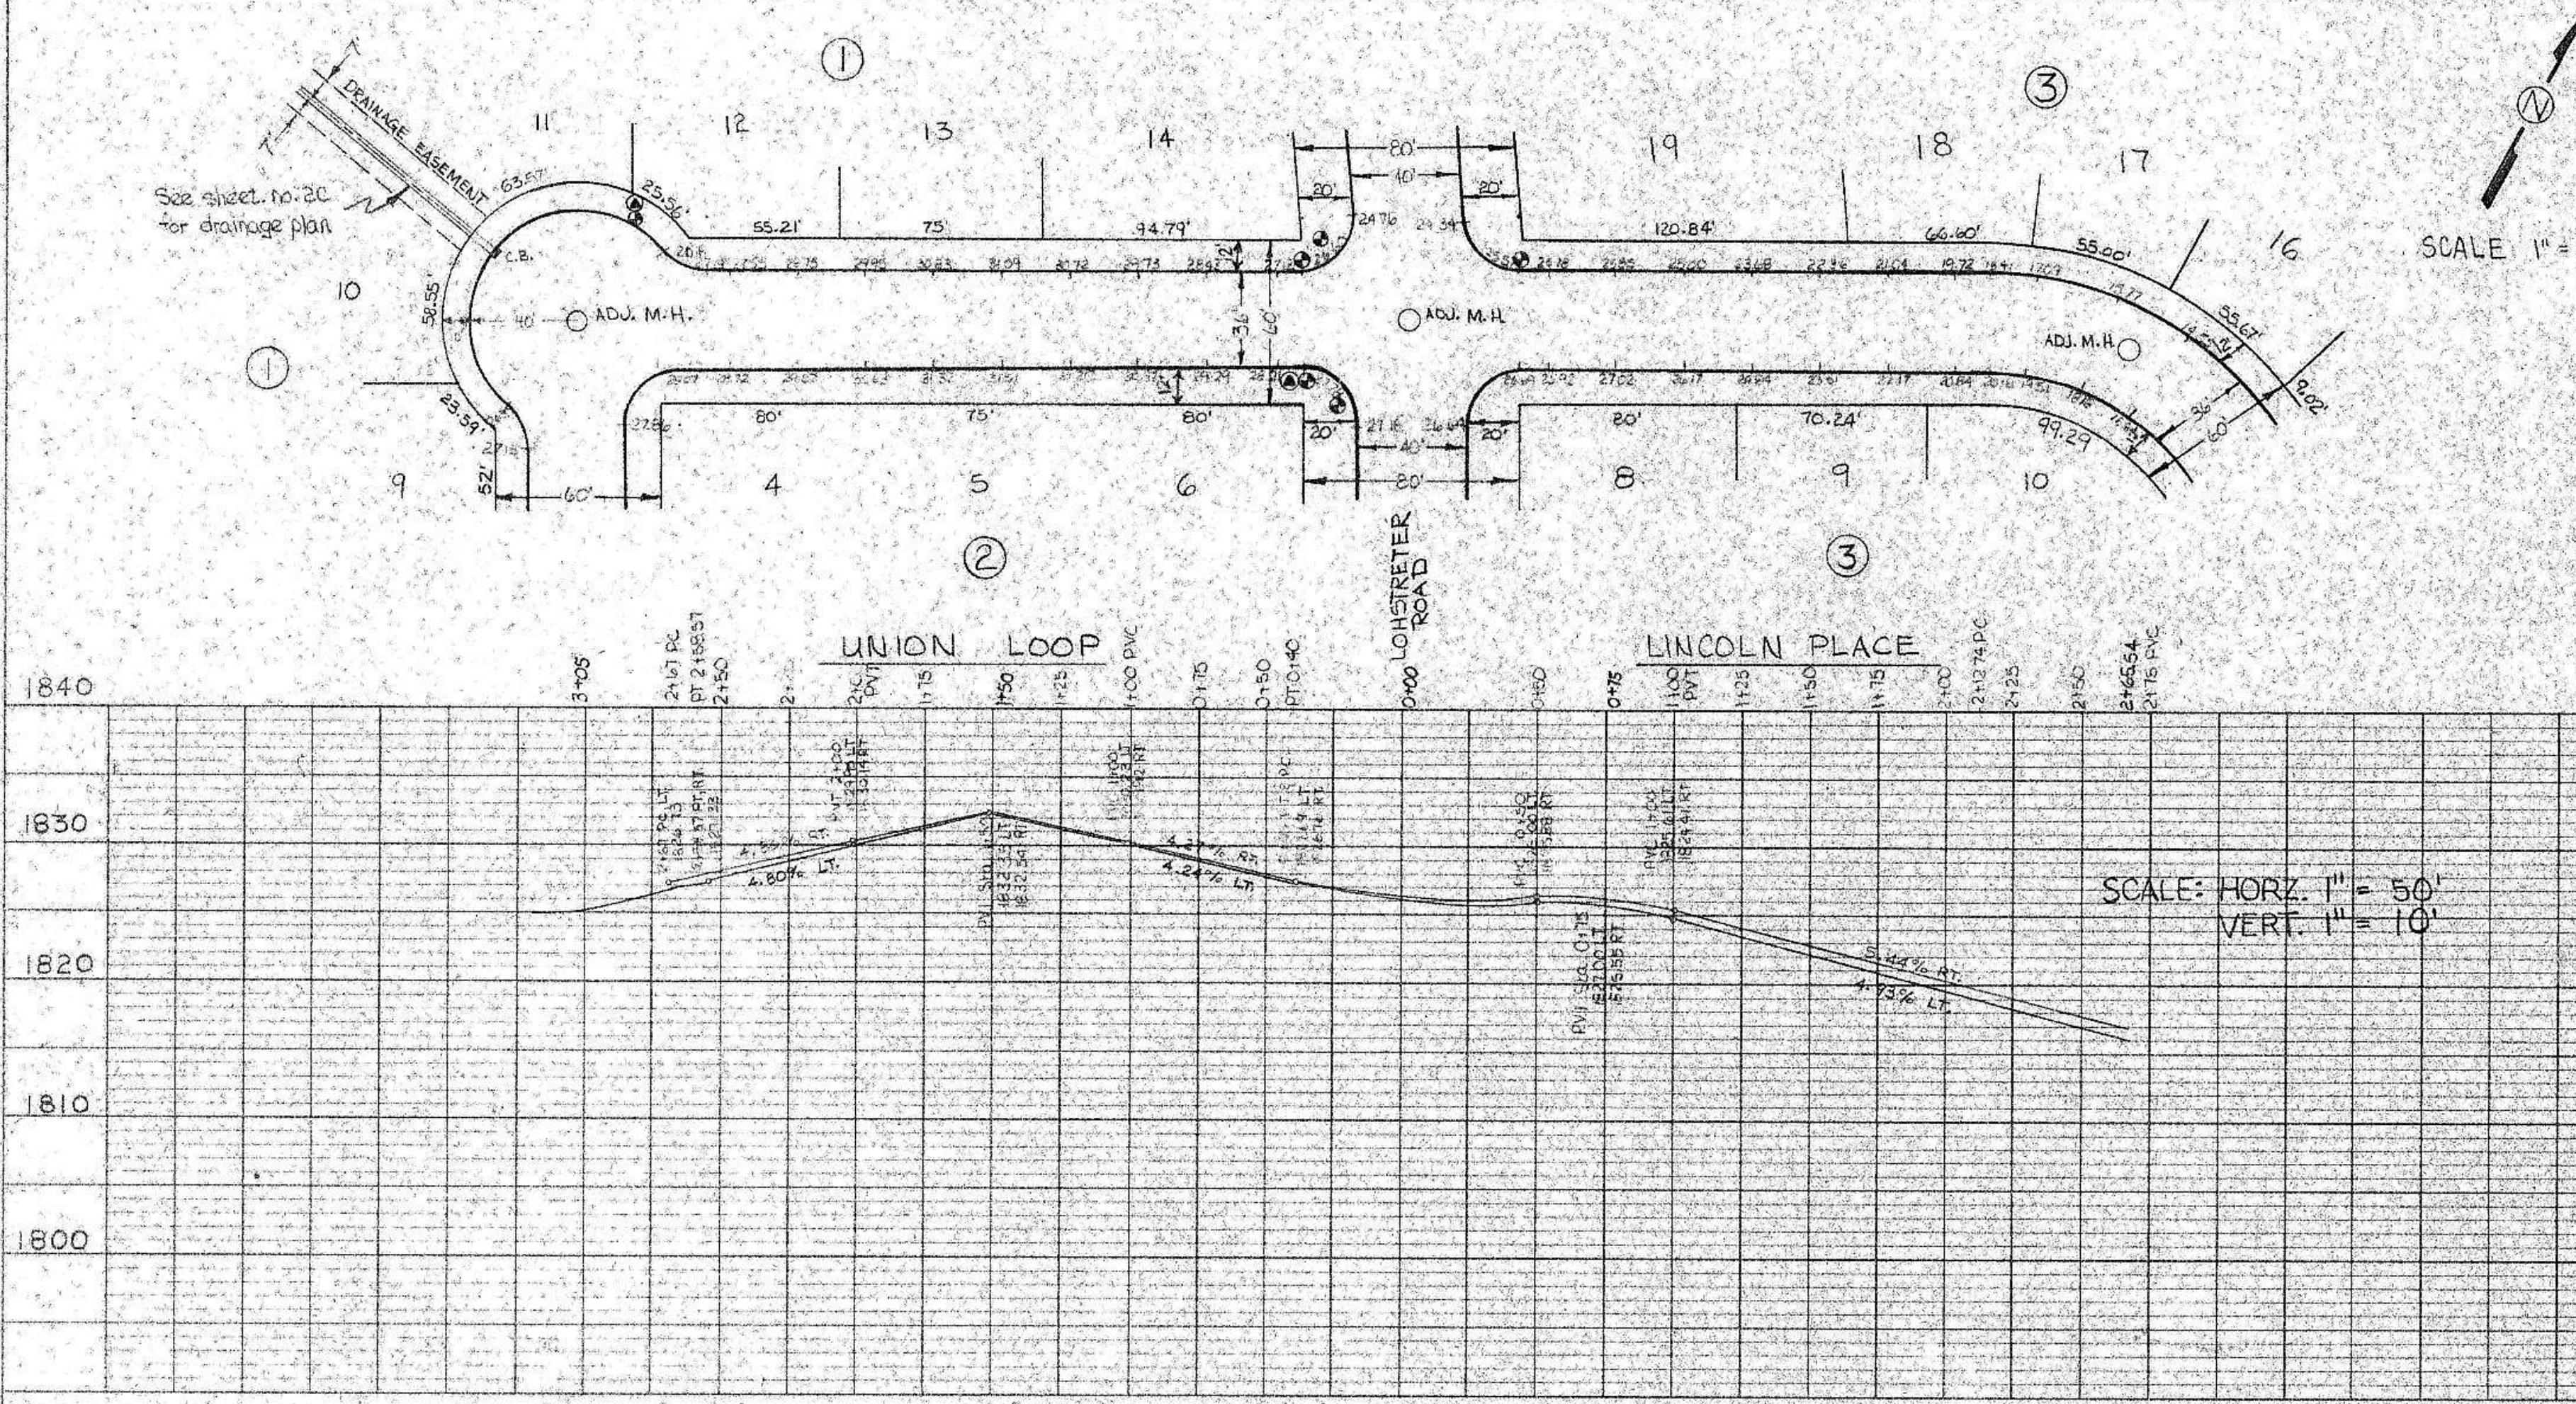

SCALE: HORIZ. 1" = 50'
 VERT. 1" = 10'

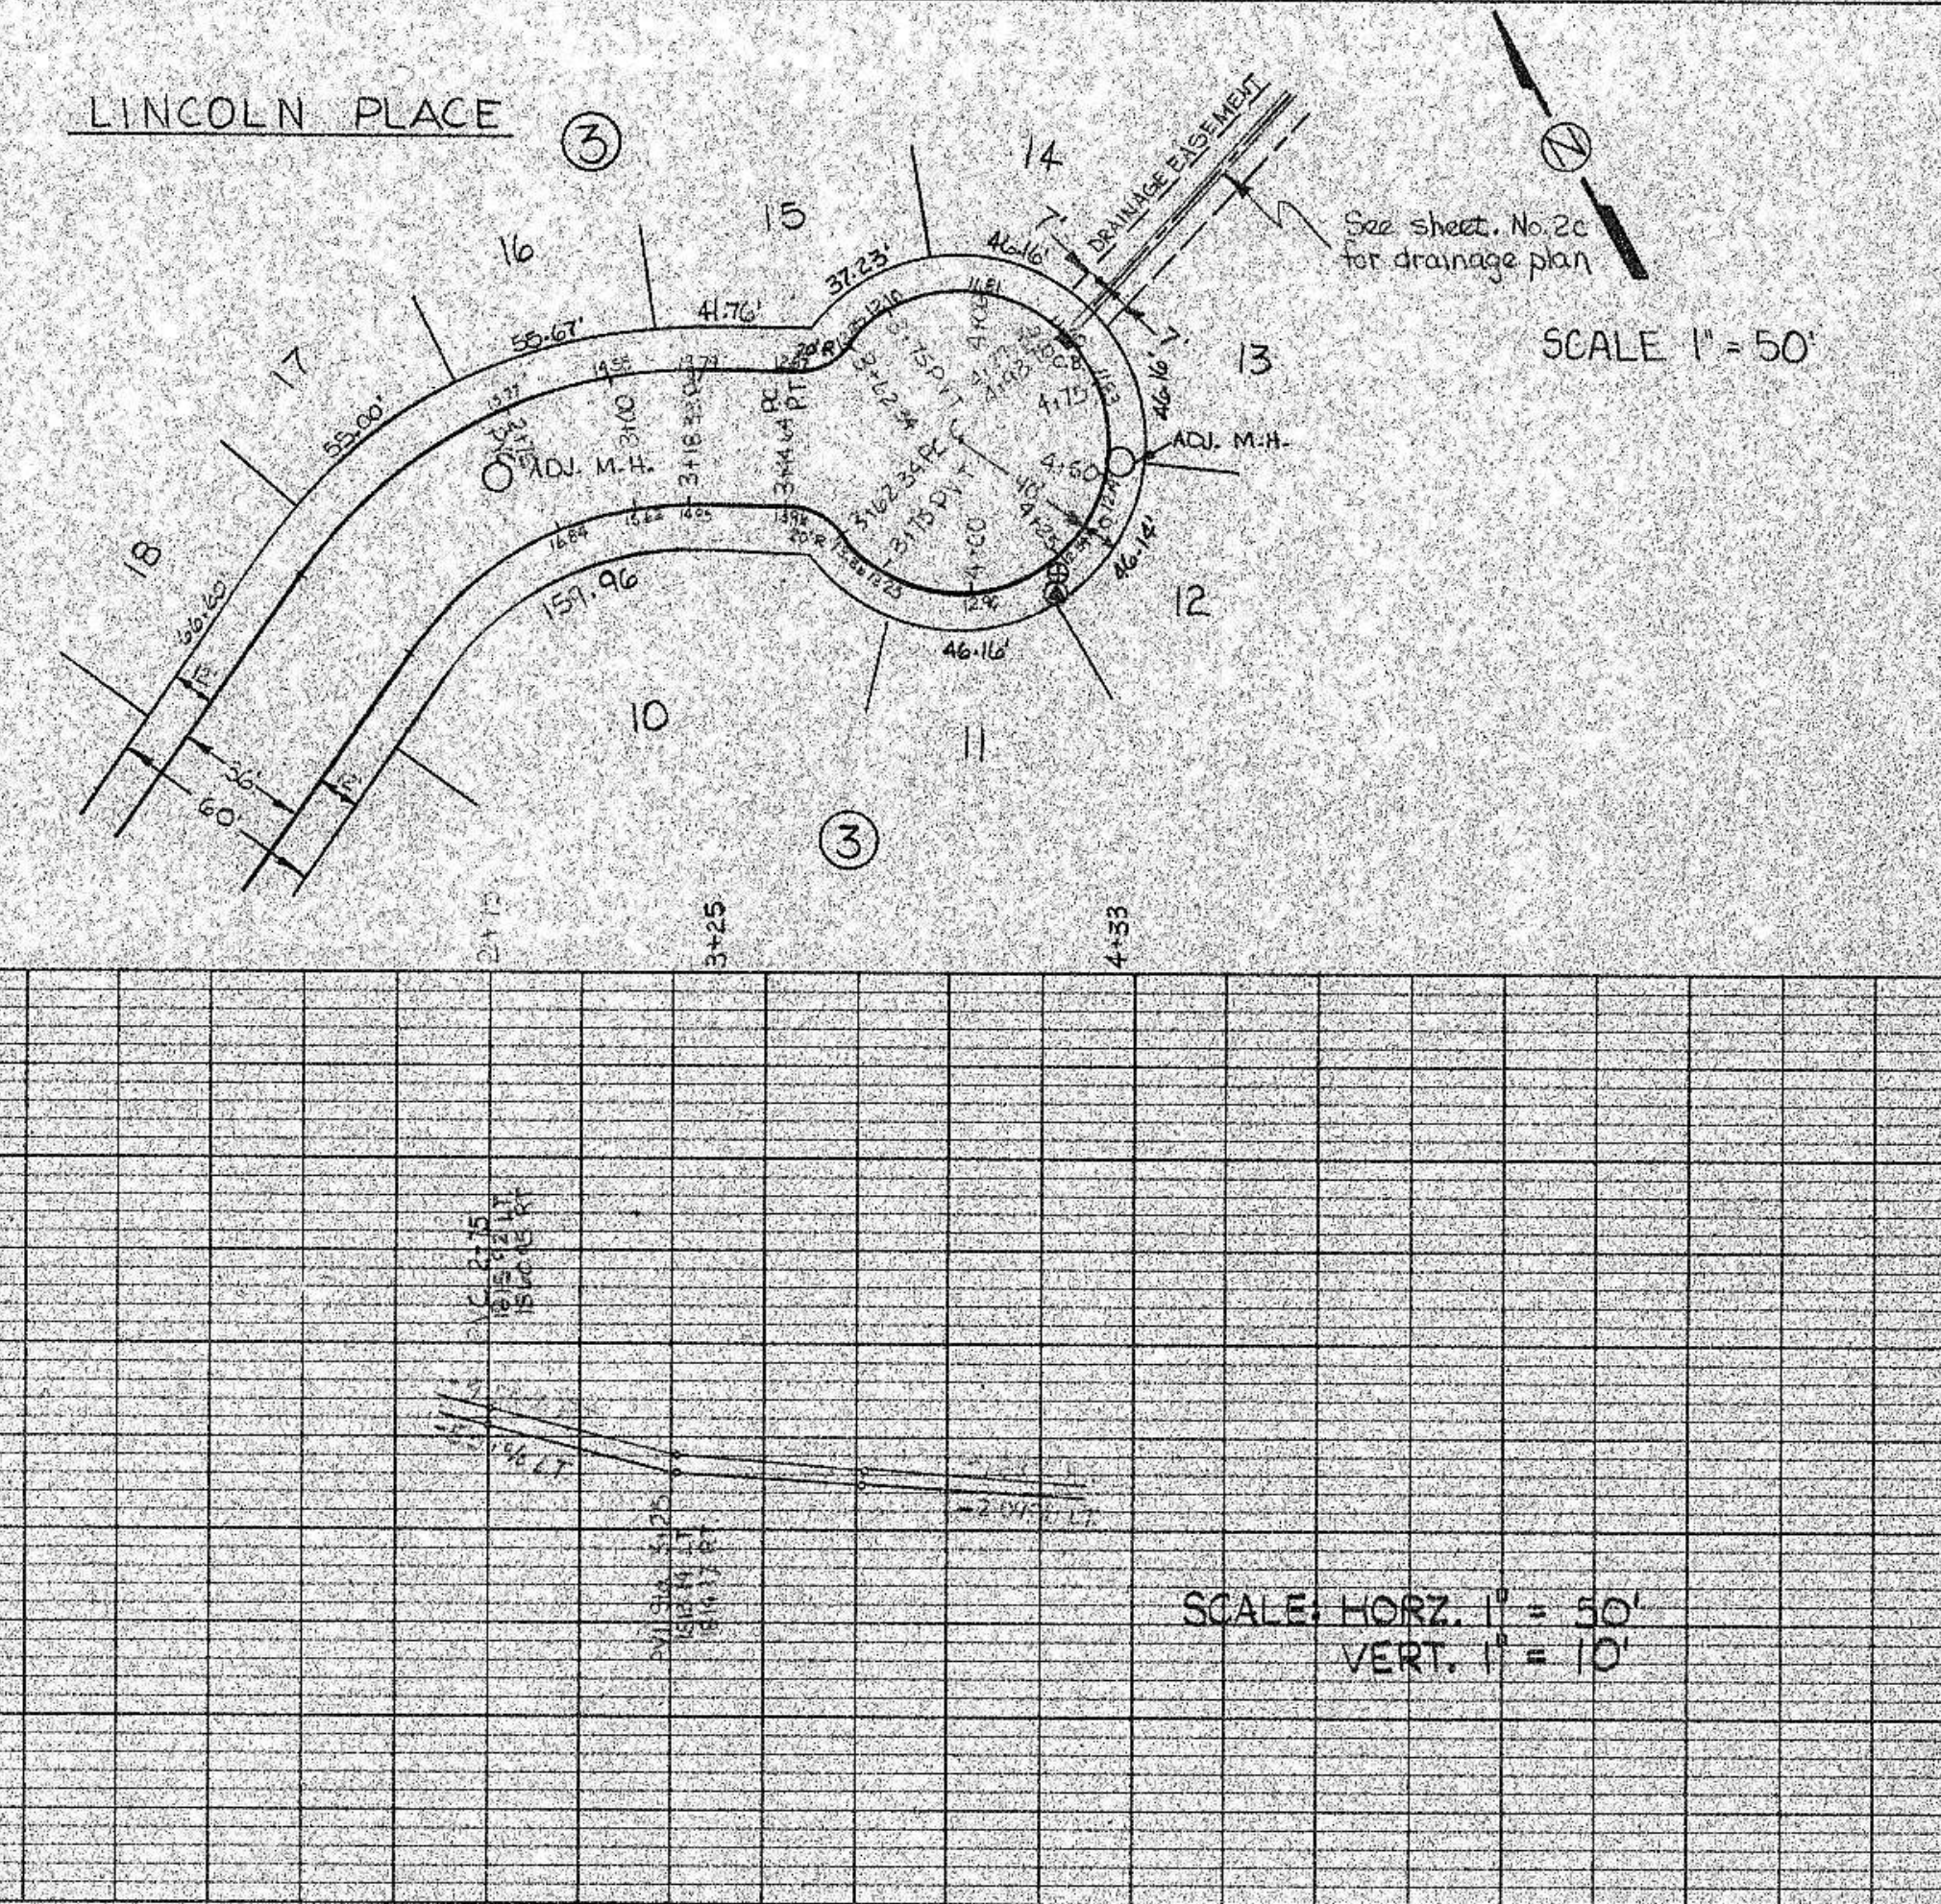

SCALE: 1" = 50'

SCALE: HORIZ. 1" = 50'
 VERT. 1" = 10'