PLAN
SURVEYED
PLOTTED
NOTE BOOK
No.
DRAWN
ALIGNMENT CHECKED
RT. OF WAY CHECKED

PROFILE
SURVEYED
PLOTTED
NOTE BOOK
No.
GRADES CHECKED
B.M.'s NOTED
STRUCTURE NOTATIONS CHECKED

BY | DATE

PLAN & PROFILE DRAWING

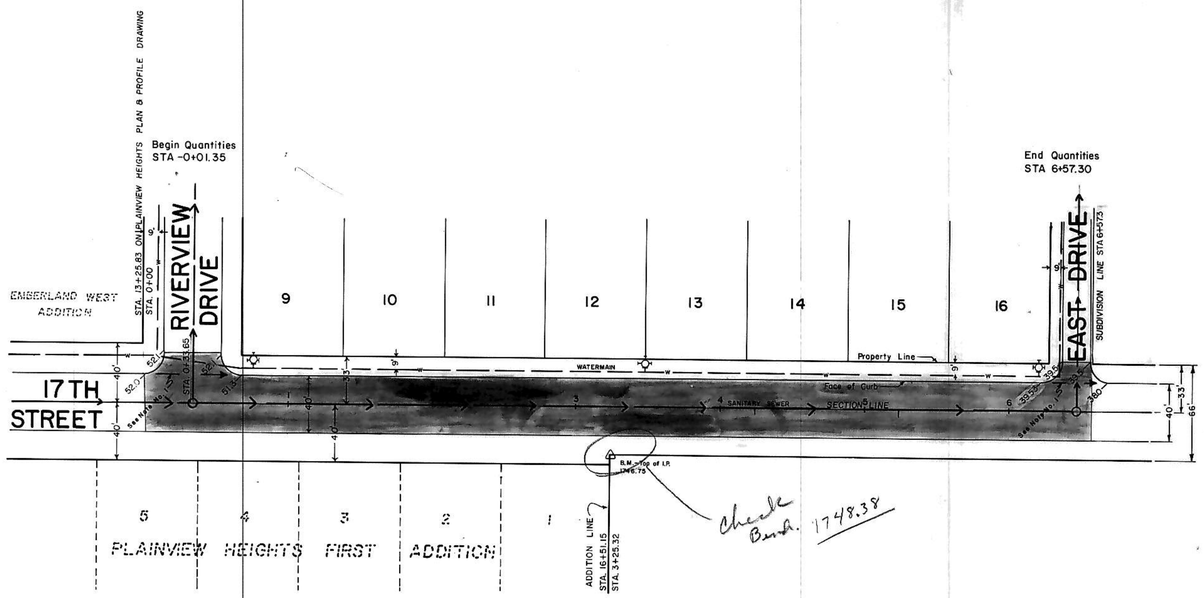

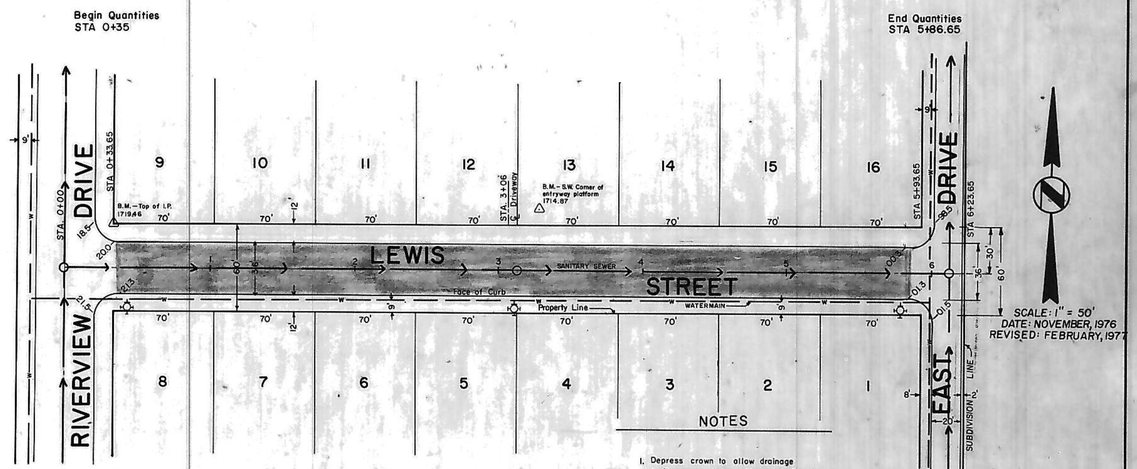

SCALE: 1" = 50'
DATE: NOVEMBER, 1976
REVISED: FEBRUARY, 1977

Existing ℄
50' Left
50' Right
Manhole
Sanitary Sewer
Watermain
Hydrant
Gate Valve

NOTES

1. Depress crown to allow drainage to flow across intersection as indicated. Also tip gutter section to allow storm water to flow across intersection.
2. All curb and gutter radii are 15 feet at face of curb unless otherwise stated.
3. Water & Sewer as per plans by TOMAN ENG.
4. Sanitary Sewer is existing.
5. Watermain is proposed, not existing as of date of plans.
6. Engineer shall verify locations of drop curbs prior to construction.
7. Proposed grades are to top of curb.

HORIZONTAL SCALE 1"=50'
VERTICAL SCALE 1"=5'

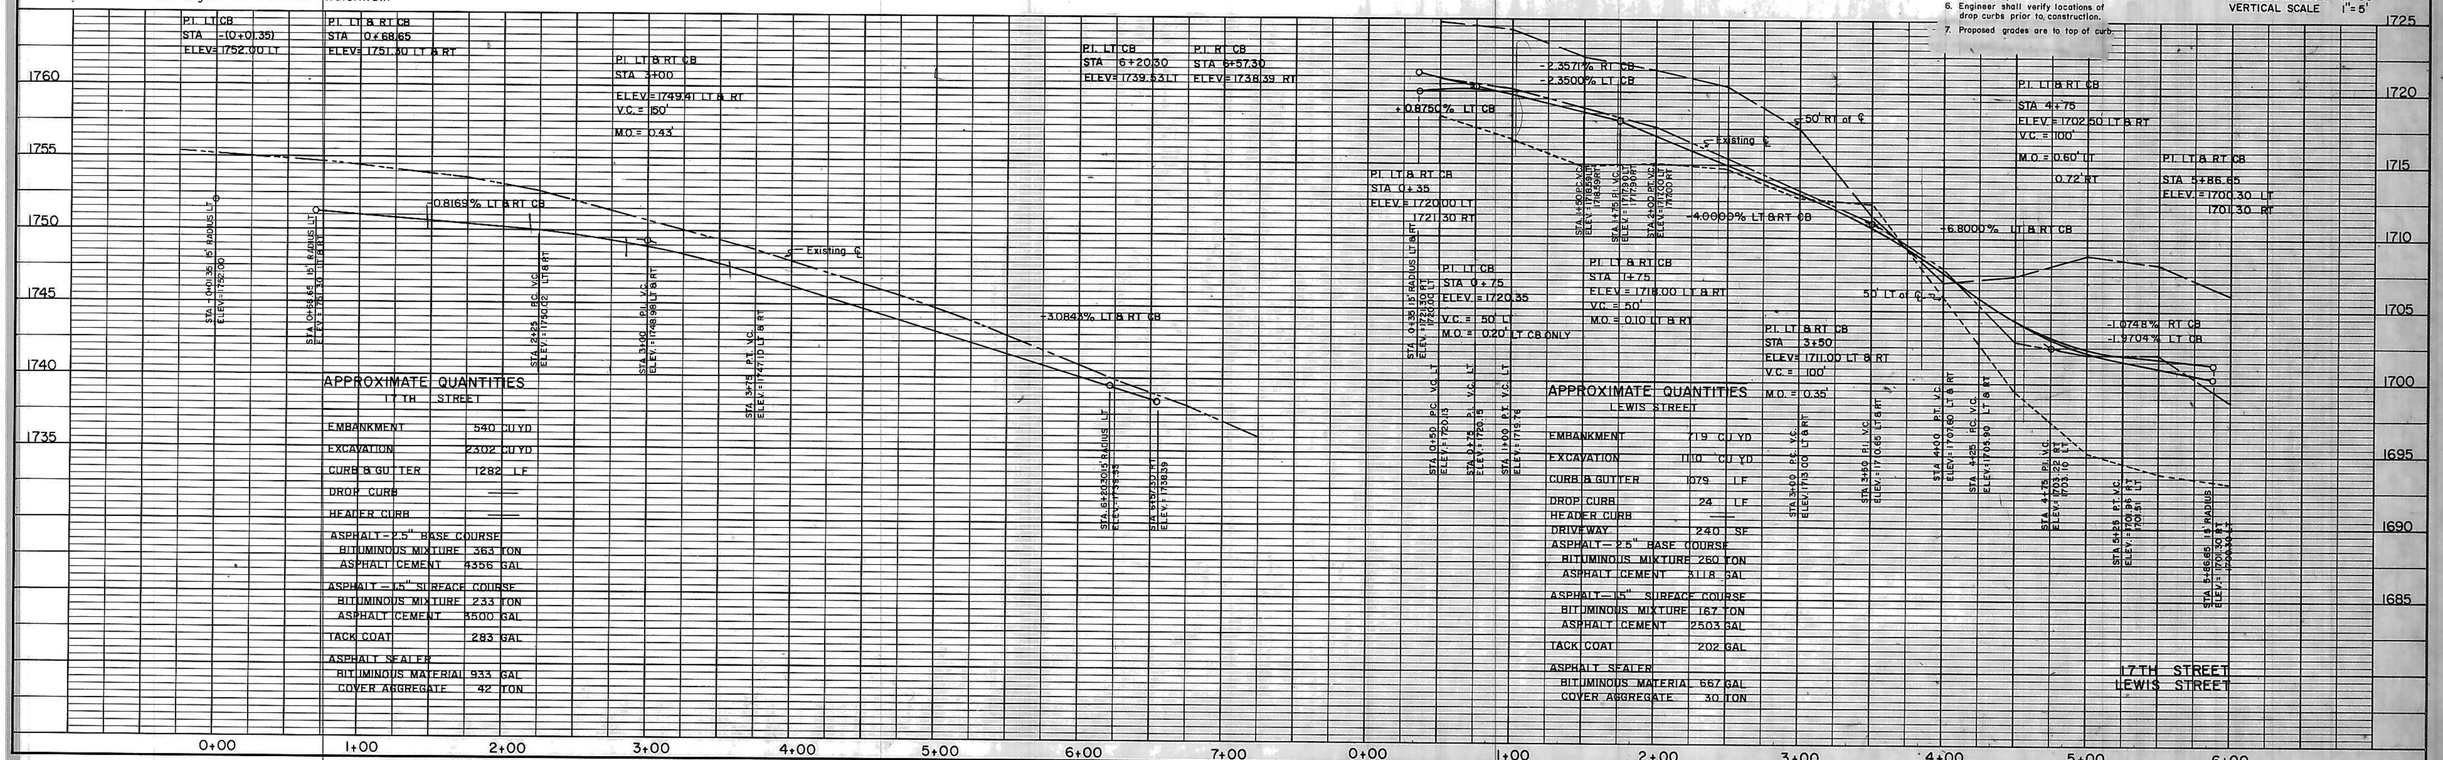

K&E PLATE 1, PLAN-PROFILE
KEUFFEL & ESSER CO.
48 7024 MADE IN U.S.A.

SHEET 5 of 7

17TH STREET & LEWIS STREET
RIPPEL'S SECOND SUBDIVISION
MANDAN, NORTH DAKOTA