14TH STREET NE
AREA 2

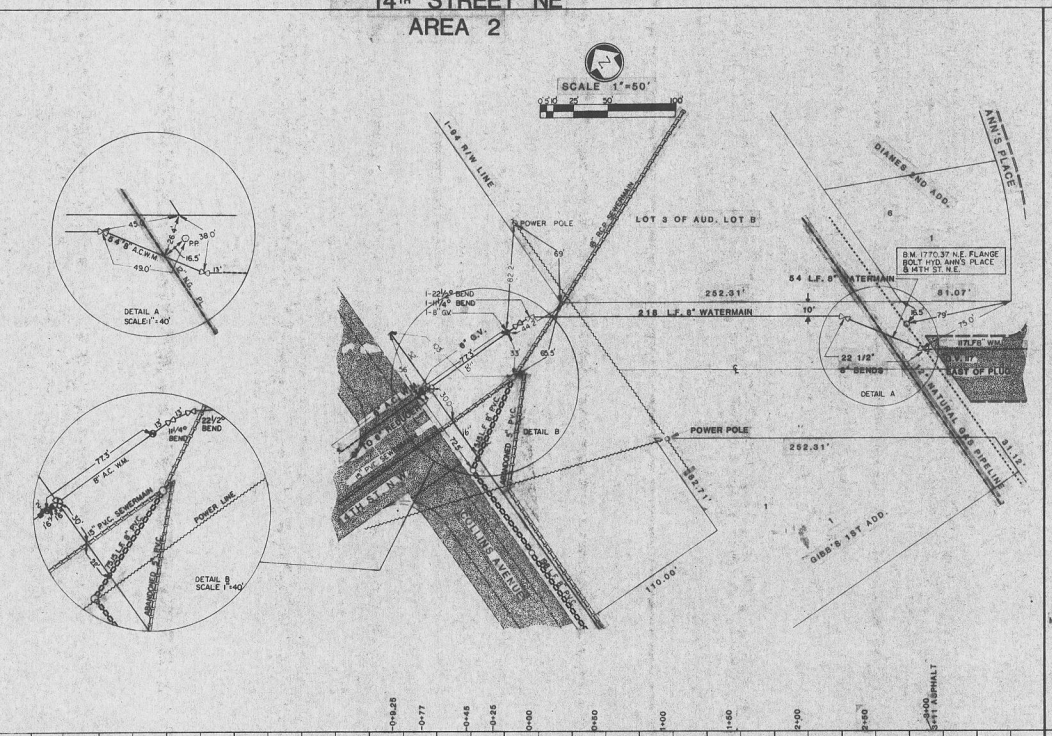

COLLINS AVE.
SEWERMAIN AREA 3
WATERMAIN AREA 2

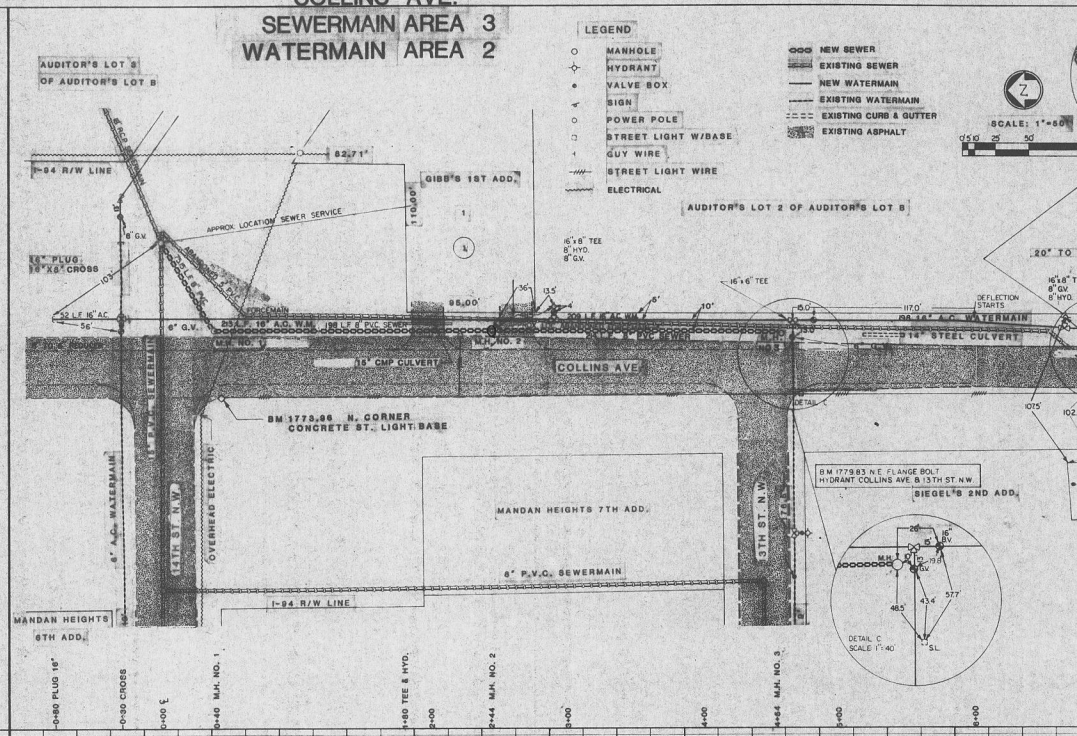

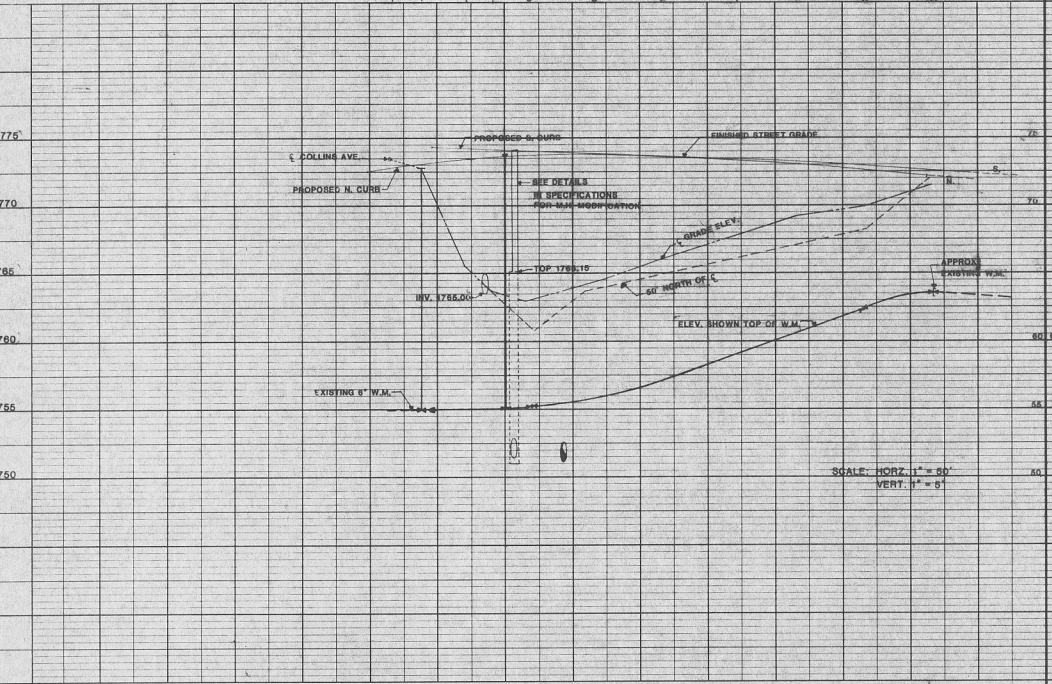

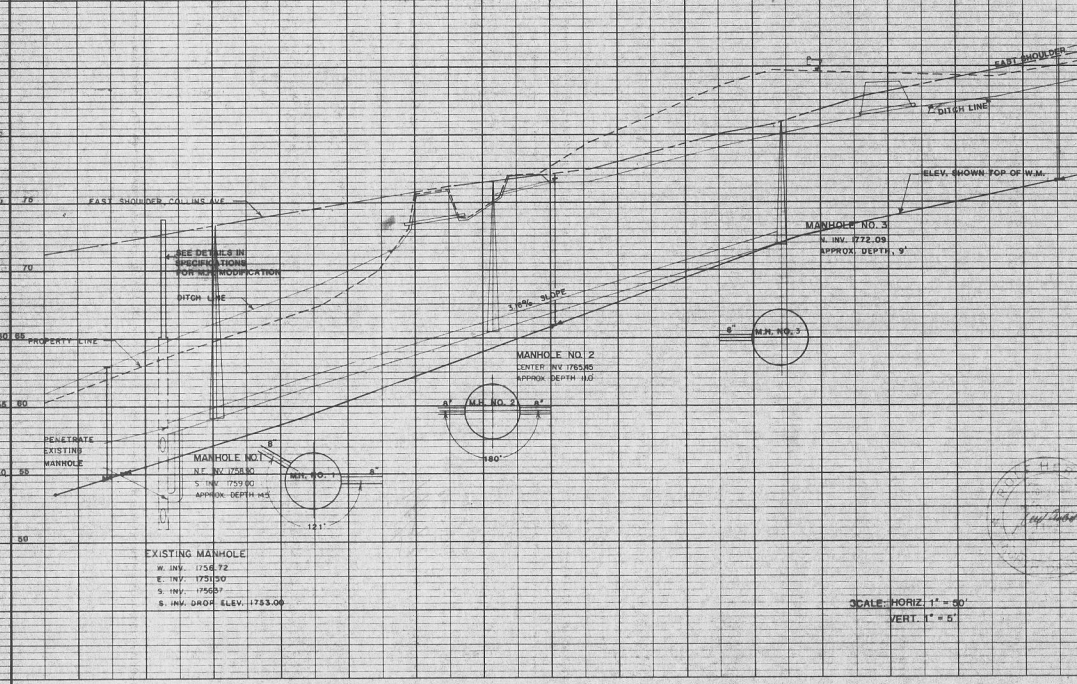

PROJECT NO. 1031

PLATE 1—PLAN PROFILE B.P.R. STANDARD
THE FREDERICK POST CO., CHICAGO

CONSOLIDATED WATER AND SEWER IMPROVEMENT DISTR

CONTRACTOR'S RECORD DRAWINGS

MANDAN N.D. SHEET NO. 2 O