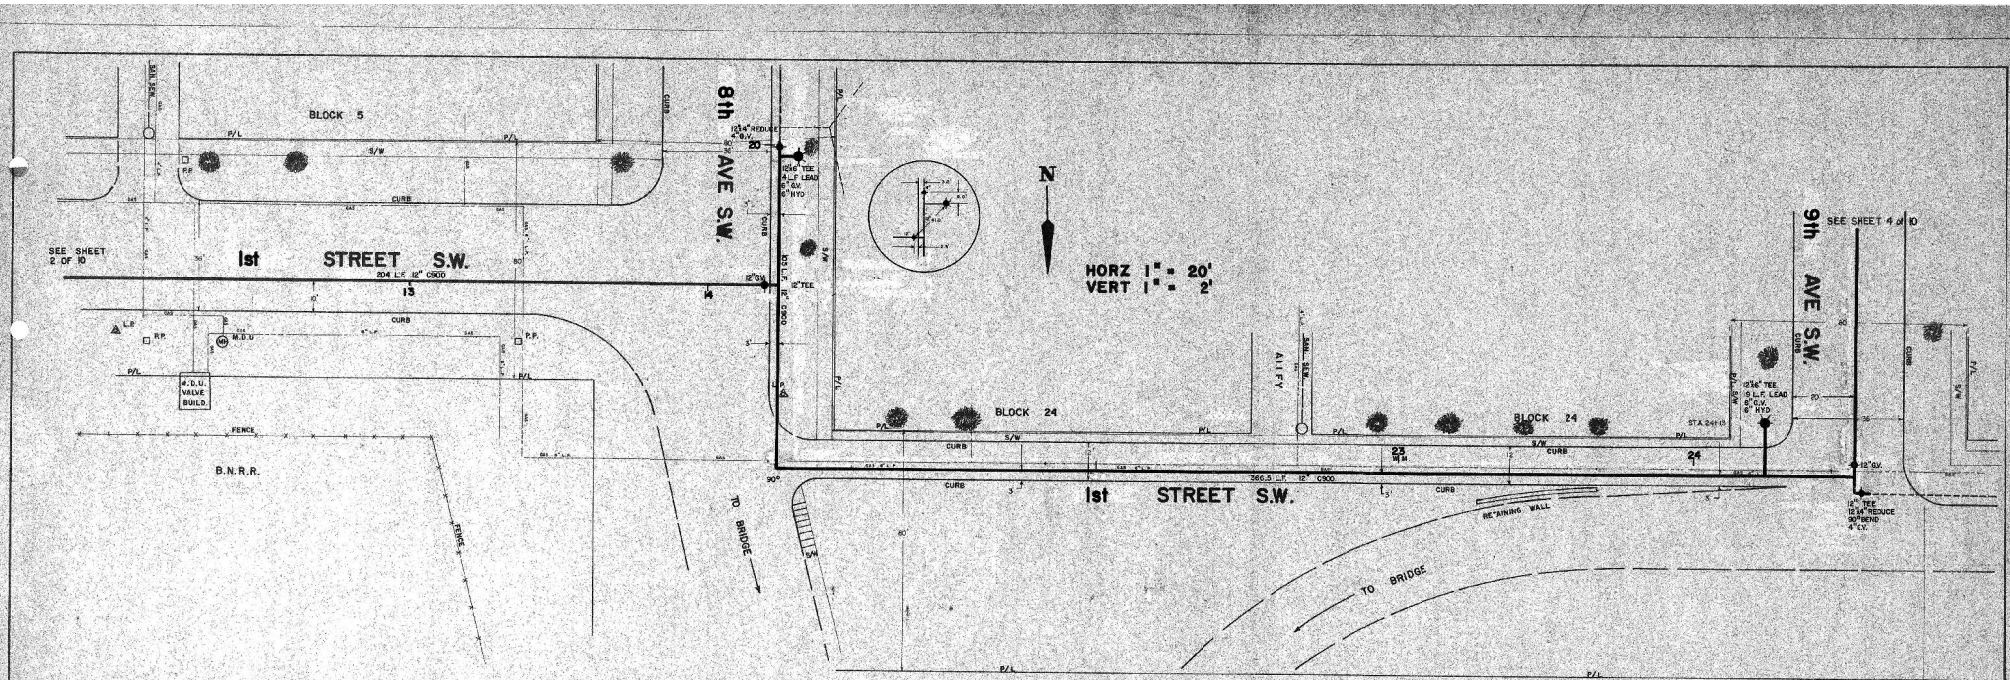

AS BUILT

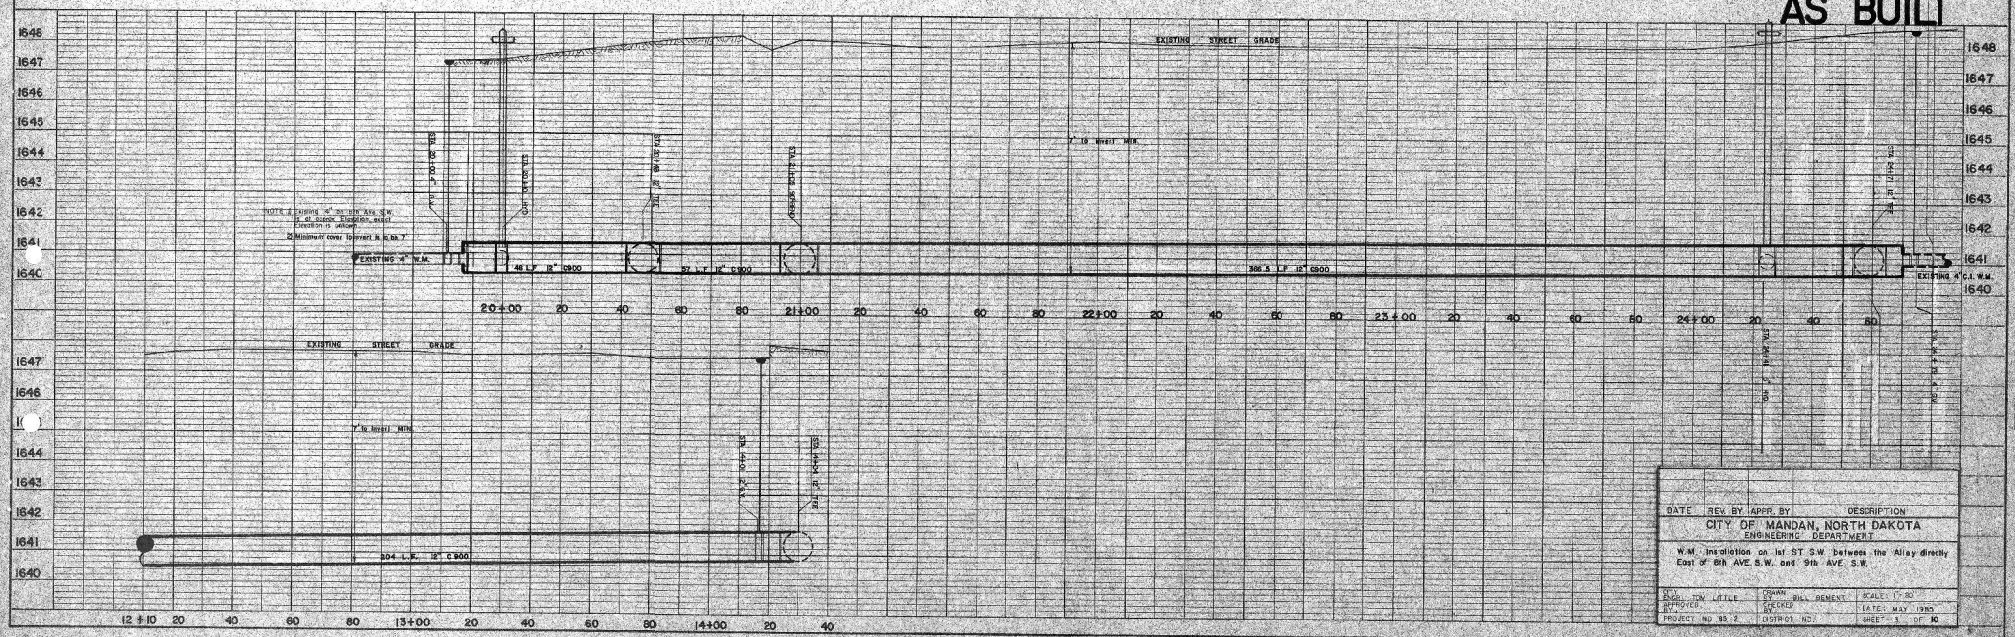

DATE	REV. BY	APPR. BY	DESCRIPTION

CITY OF MANDAN, NORTH DAKOTA
ENGINEERING DEPARTMENT

W.M. installation on 1st ST S.W. between the Alley directly East of 8th AVE S.W. and 9th AVE. S.W.

DES. TOM LITTLE	DRAWN BY BILL REMENT	SCALE: 1"=20'
APPROVED BY	CHECKED BY	DATE: MAY 1985
PROJECT NO. 85-2	DISTRICT NO.	SHEET 3 OF 10

PROJECT 85-2
SHEET 3 OF 10