


DATE
BY
DESIGNED
ALIGNMENT CHECKED
RT. OF WAY CHECKED
PLAN
NOTE BOOK
No.

N
HORZ 1" = 20'
VERT 1" = 2'

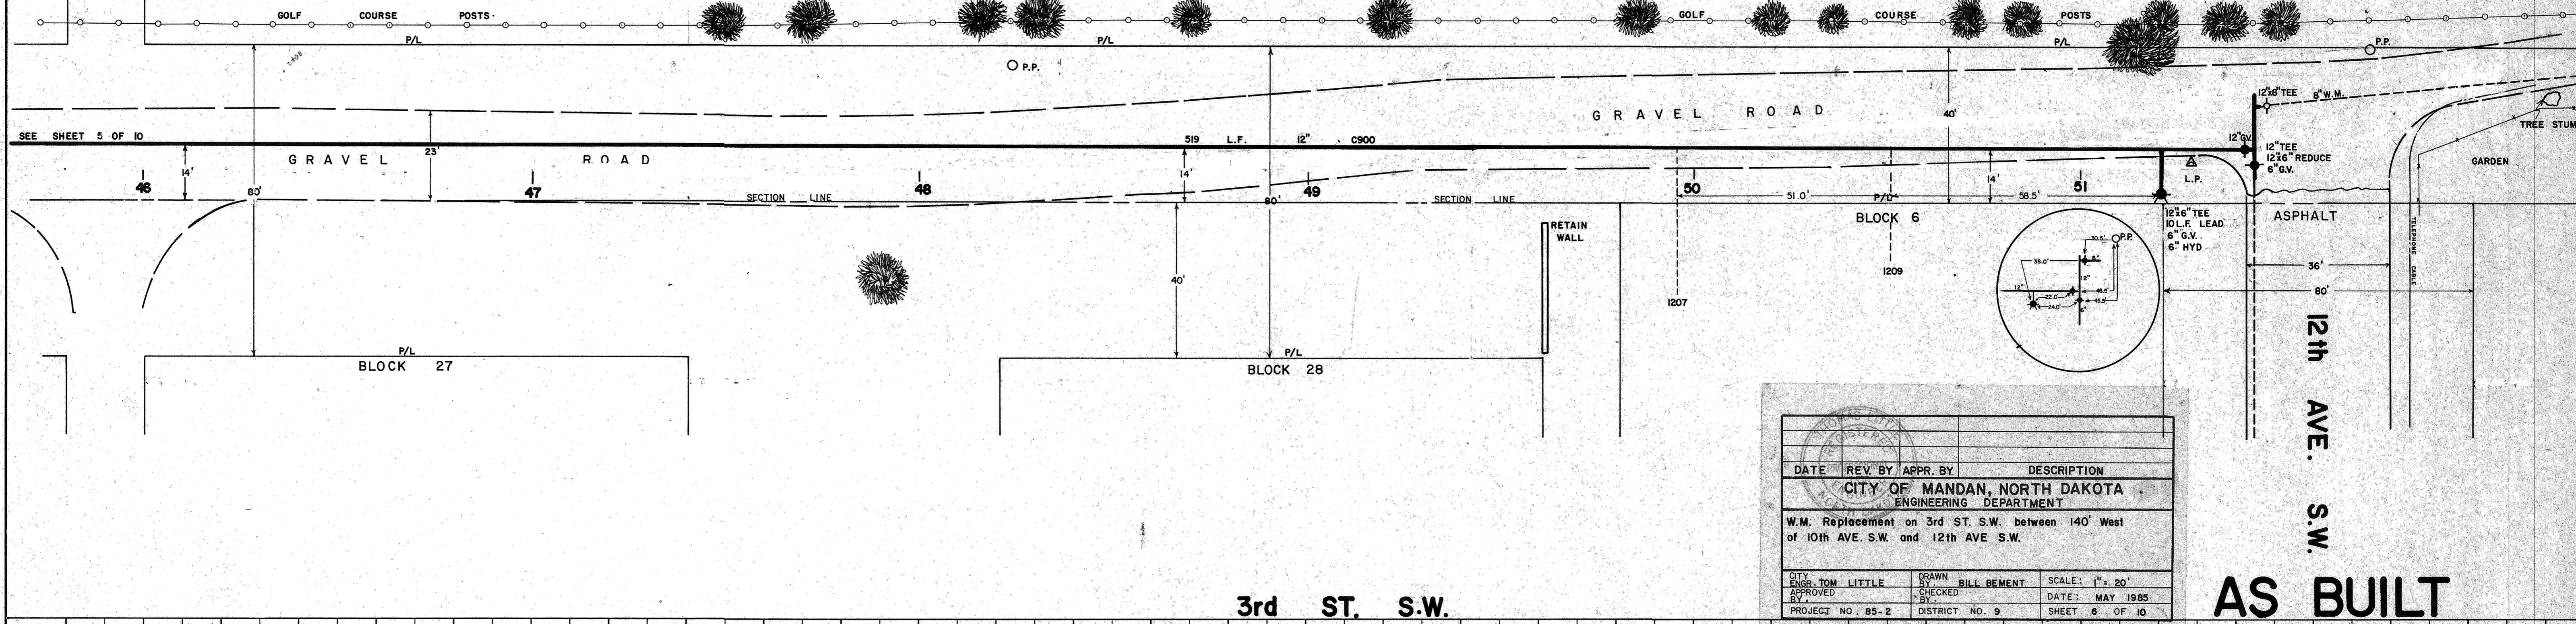

DATE
BY
SURVEIL
GRADES CHECKED
B. M. & NOTED
STRUCTURE LOCATIONS CHECKED
PROFILE
NOTE BOOK
No.

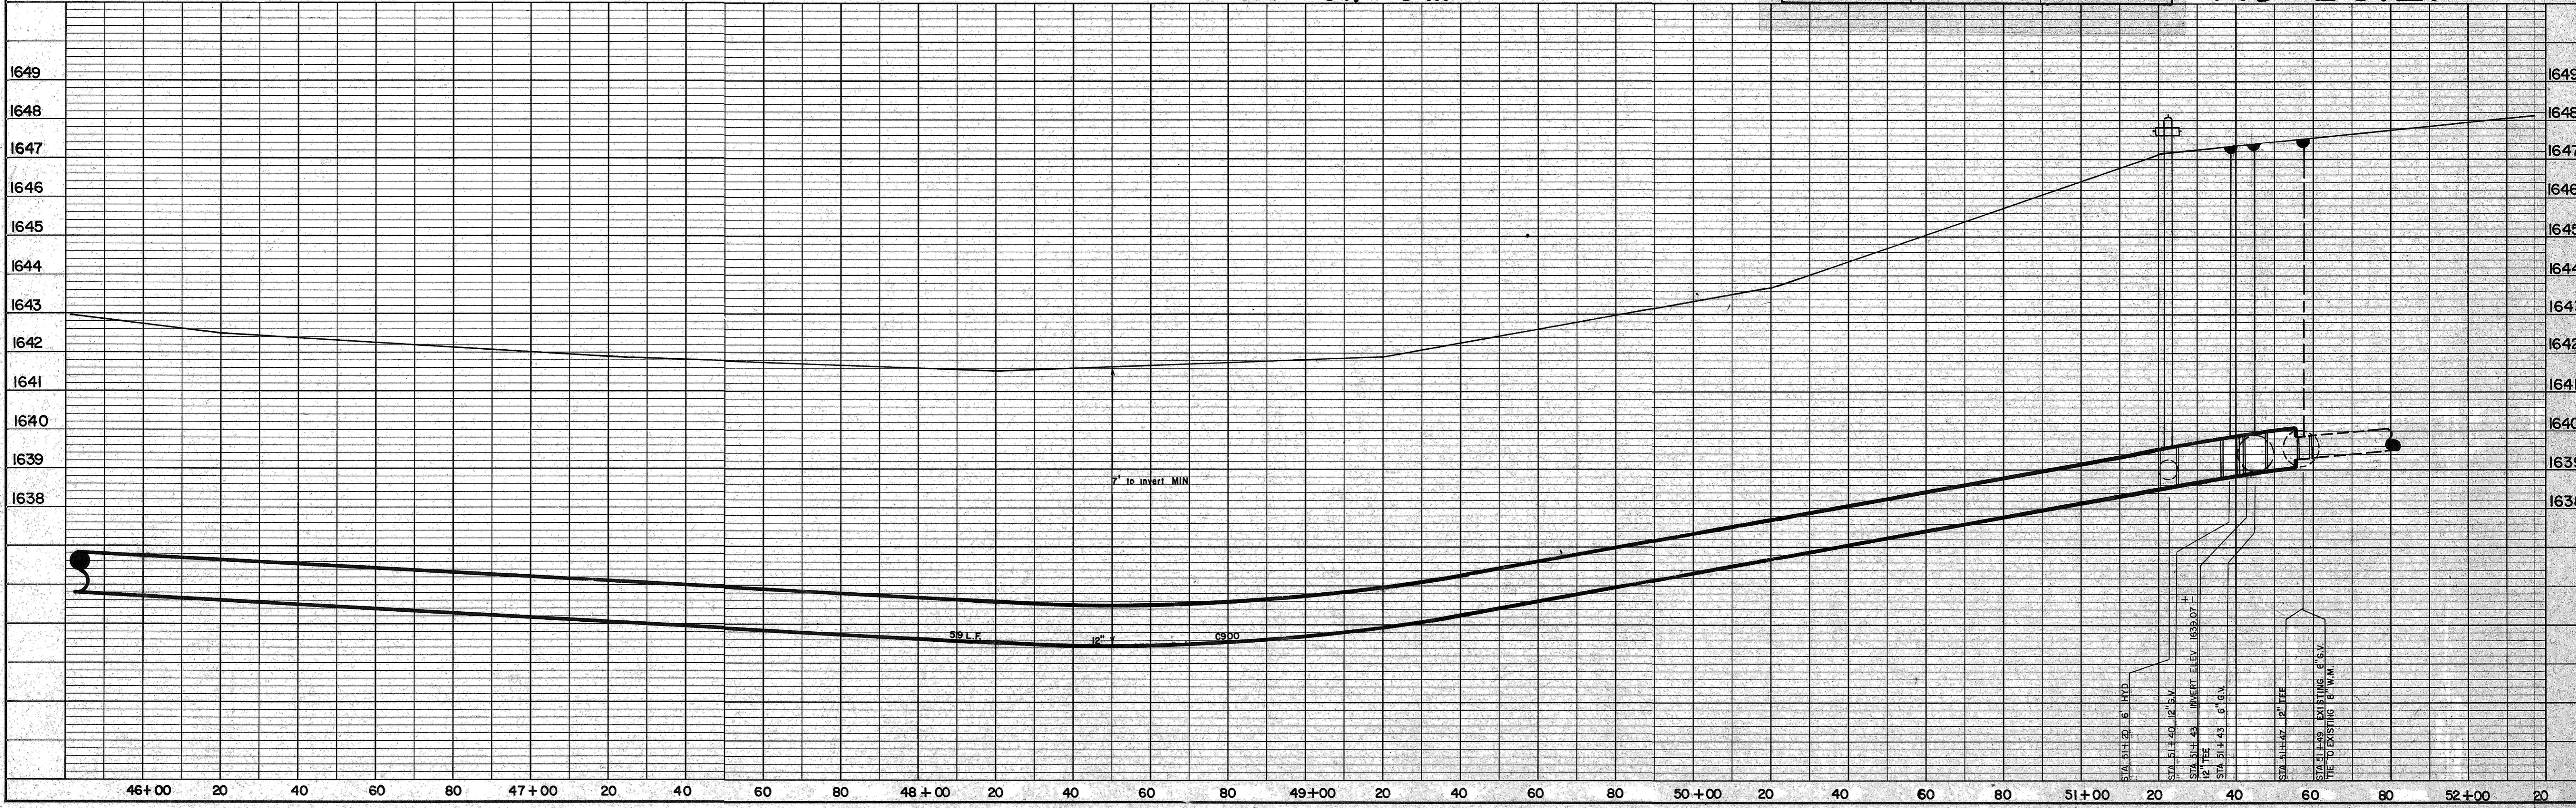


PLATE 1, PLAN-PROFILE
KEUFFEL & ESSER CO.

48 7024 MADE IN U.S.A.